


1 2 3 4 5 6 7 8 9 10 11 12 13 14 15 16

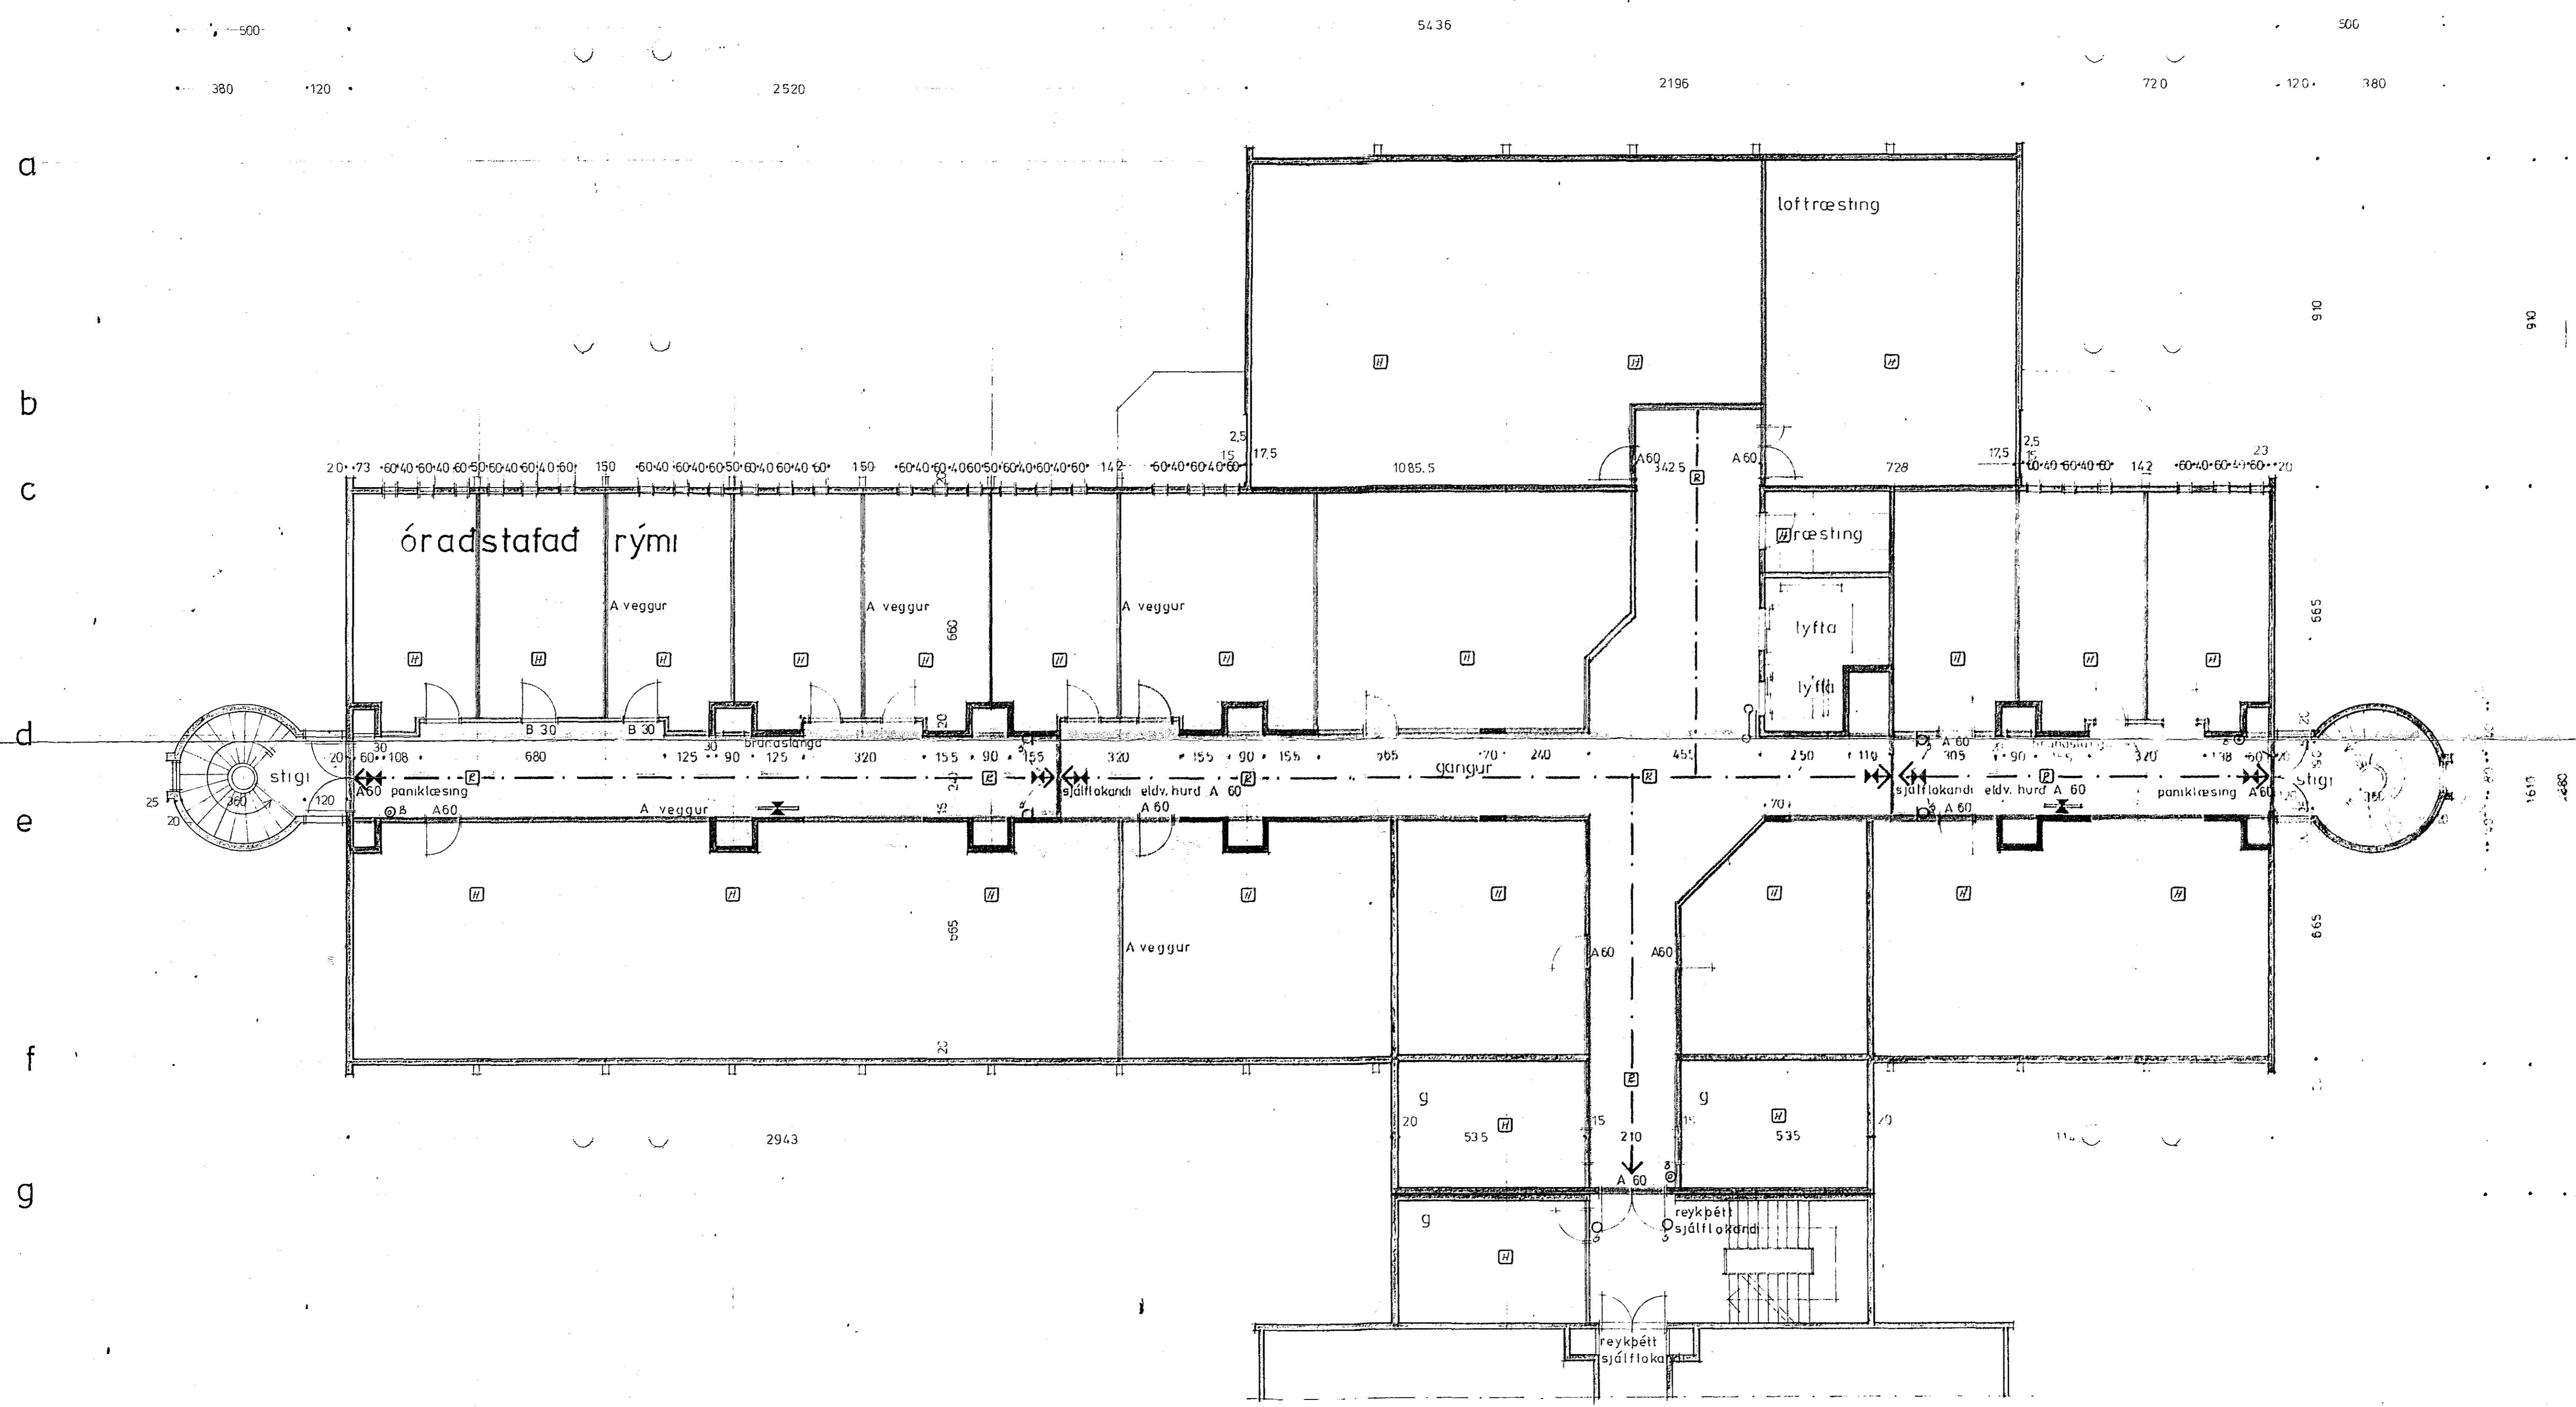

SAMPYKKT 17/3 1981
 SBR. BRÉF DAGS 17/3 1981
 BRUNAMÁLASTOFNUN RIKISINS
Heiðir Brásson

TEIKNISTOFAN H.F. ÁRMÚLA G

GÍSI HALDÓSSON JOSEF HEYRIS LEIFUR GÍSLASON BJARNI MARTEINSSON HALDÓR GUDMUNDSSON	HAFNAFIRÐI HAFNAFIRÐI HAFNAFIRÐI HAFNAFIRÐI HAFNAFIRÐI
---	--

2. AFANGI GRUNNMYND 5 HMF D B 4
 1:100 19. 5. '80 hg p.11