


Fréttargata n. 49. Breiðsing
 - Bjarni en leifsson. -

SP.
 25 / 10
 44


N=2:100

endmætt.


SP 1/11/67

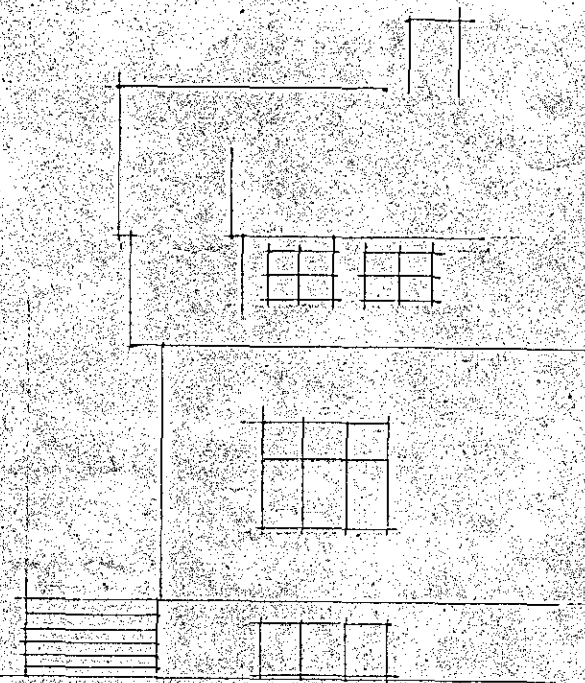


Fréttargata (öðregt.)

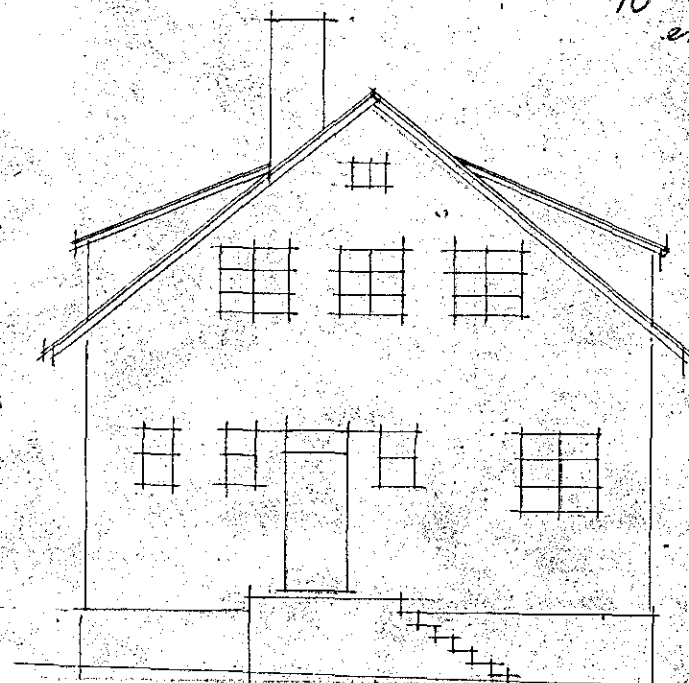

Fréttargata (öðregt.)

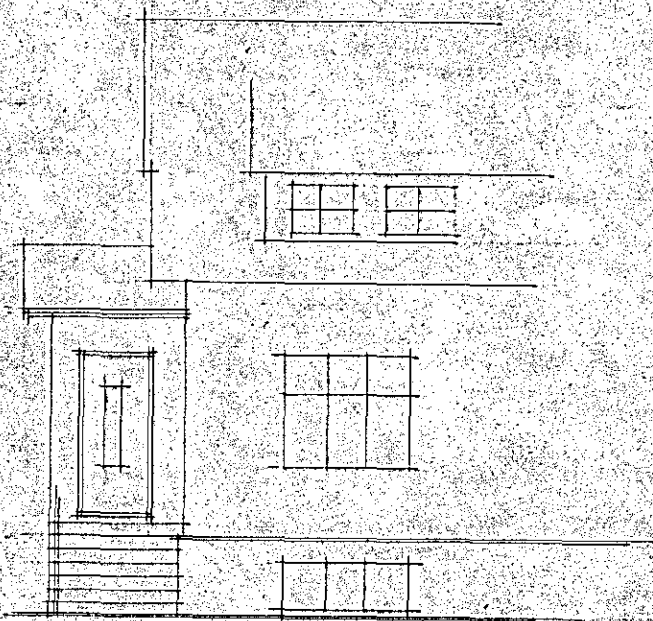

Fréttargata (öðregt.)

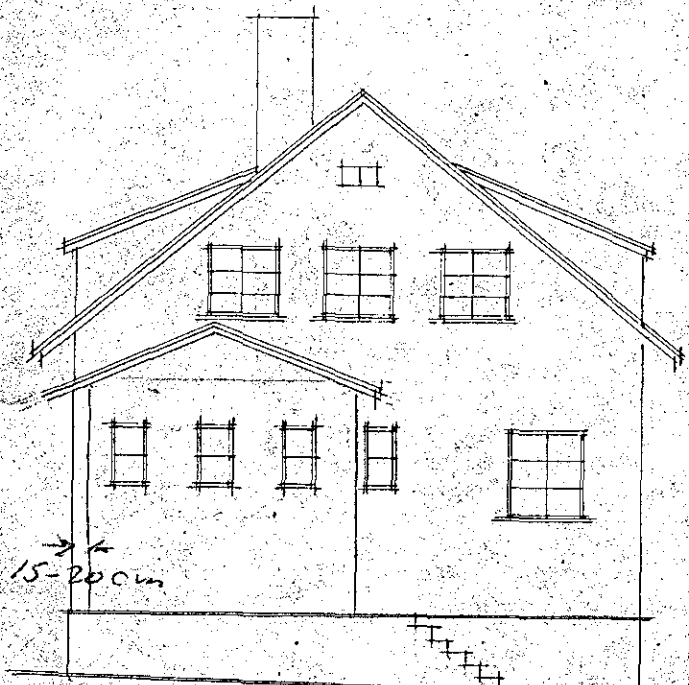

15-20 cm

$3,6 \times 180 = 6,5 m^2$
 $\times 240 = 22 m^2$

Fréttargata (öðregt.)

SP. 1/11/67

N. Þorvaldursson