




SNID 1 VEGG MILLI HUSA
NR. 11 OG 13

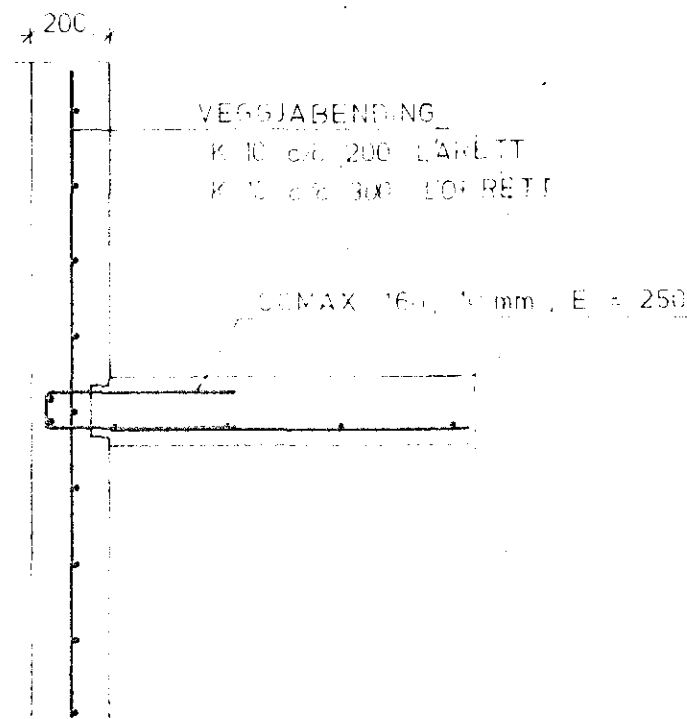


SNID B 1:20

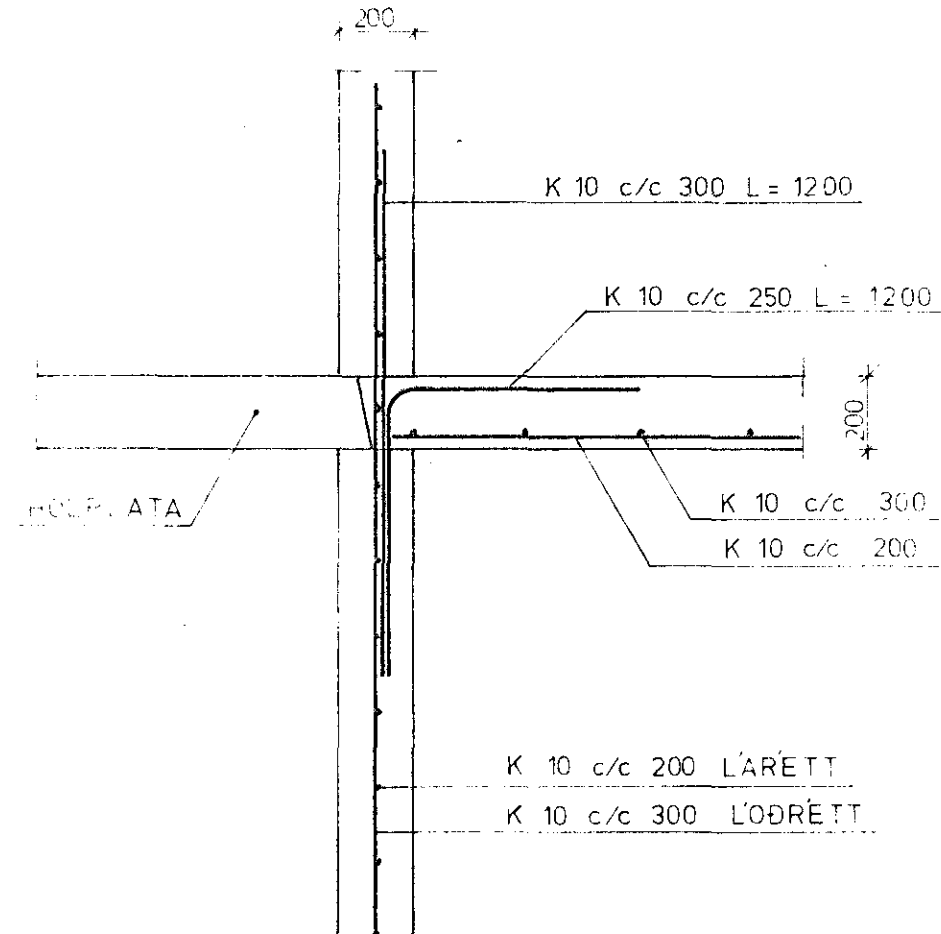


SNID C 1:20

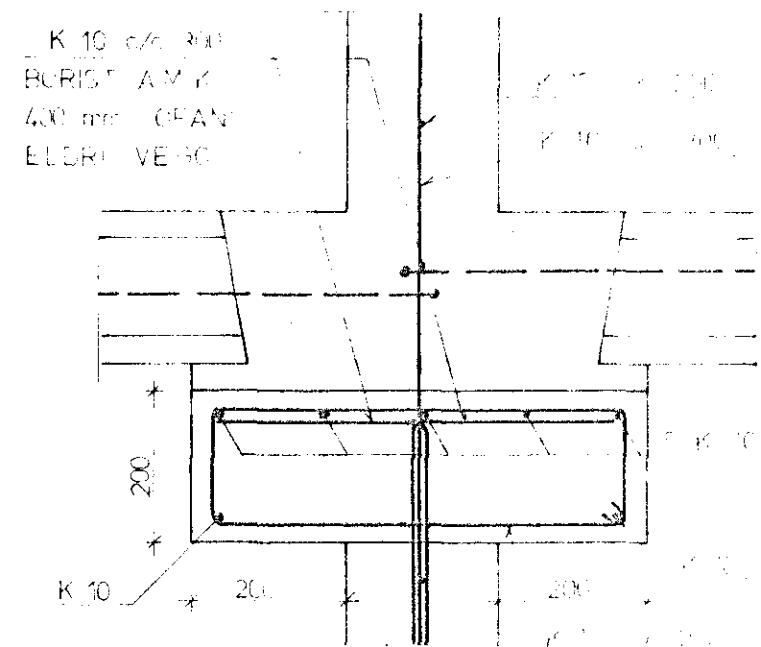


SNID 1 VEGG MILLI HUSA
NR. 11 OG 13 A HÆÐ
BREITT: MARS 1989

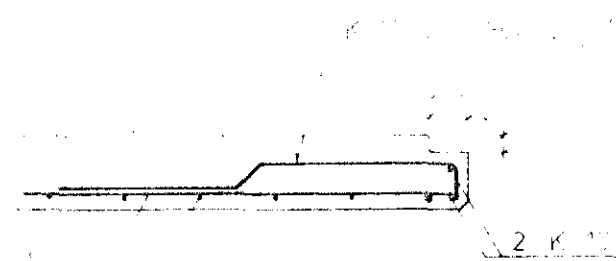


SNID A 1:20

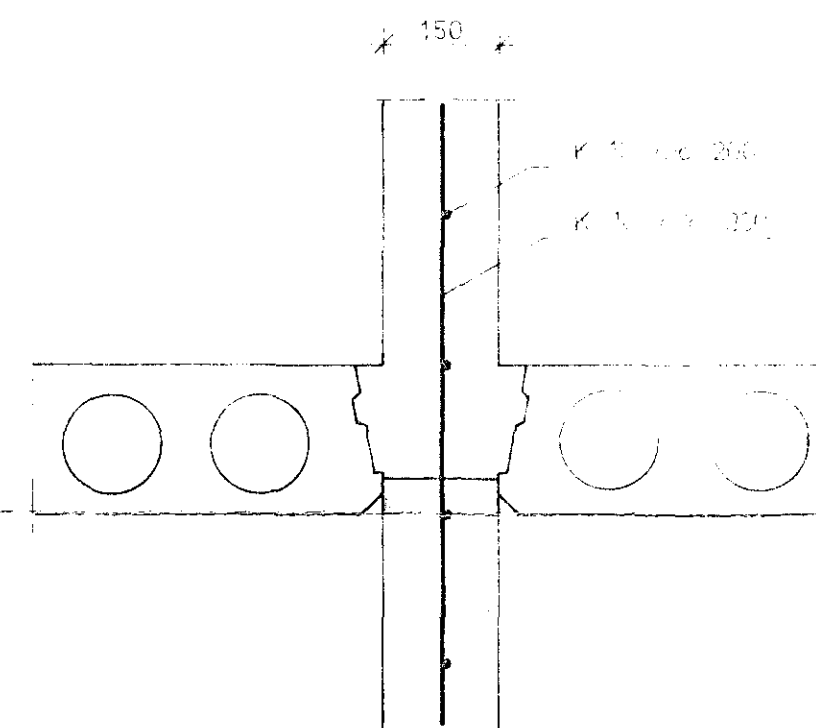


SNID 1 MILLIVEGG 1:10

 


SNID 1 HLIDARVEGG 1:10

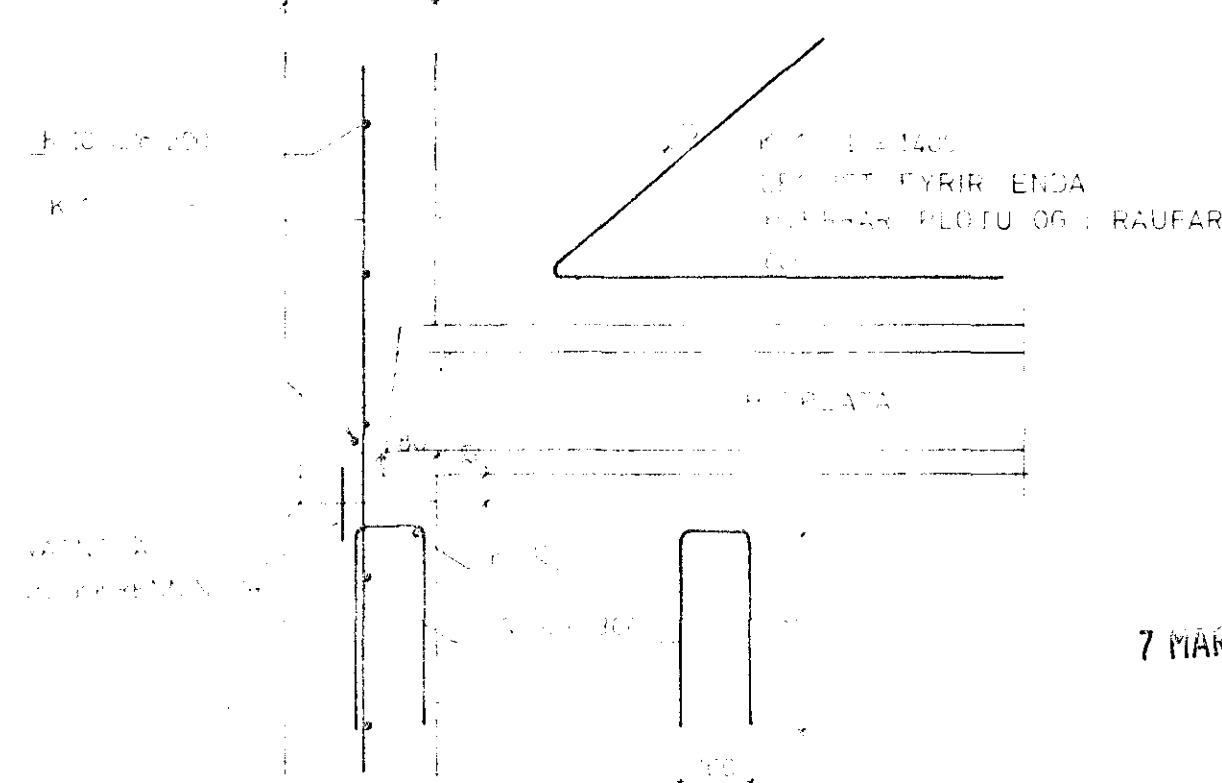

SNID 1 STAFNVEGG 1:10

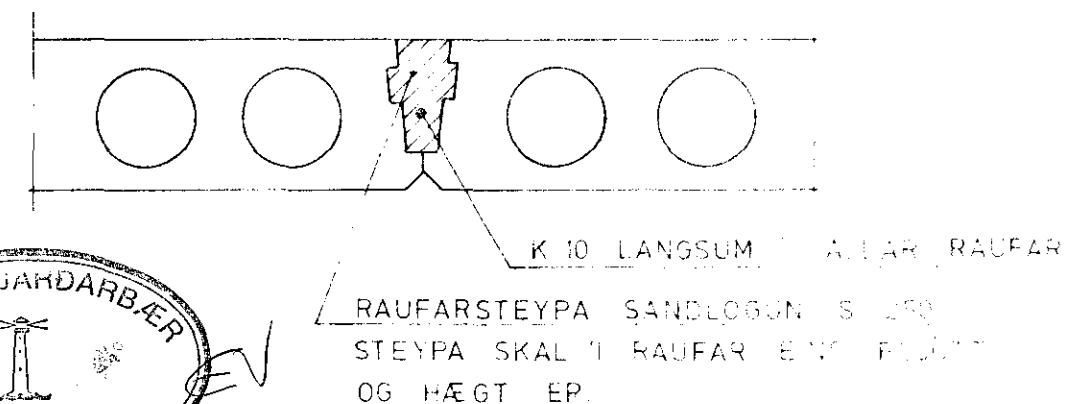

SNID 1 RAUF 1:10

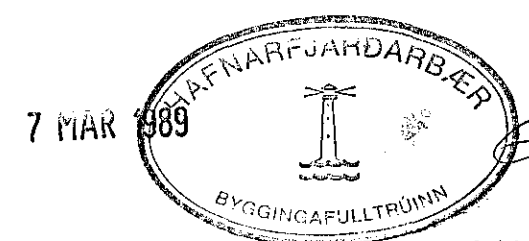

SKÝRINGAR SJA TEIKNINGU NR. 2.0.01

HAGVIRKI HF		T 22	
VERKTAKI	VERKHÖNNUN	SKUTAHRAFN 2	200 HAFNAR BÍL
SUÐURHVAMMUR 11 - 15, HFJ.			2.5.09
GÓLFPLÖTUR - SNID			
Hannað	Teiknað	Yfirfarið	Samþykkt
H.P.R.	AW	H.P.R.	