

GRUNNMÝND PAKS 1:50

REIM 125 X 50
BOLTIST A VEGG
12MM BOLTUM
1/2 80

BMF BITASKOR NEGUST MED 4X4 STK.
40/50 KAMBALM.

SPERRA 125 X 50

SPERRUFESTING
KID 7FK SPERRU.

2KID

GAARDIR KIOS 20

3KID


SNID 10 - 10 ~ 1:20

1 YTEL BRUN LITVEGGA
KOMI EINFOLD GRIND
KID 30 LÖBRÉTT
KID 20 LÁRÉTT

TUÖFOLD GRIND I BITA
KID 30 LÖBRÉTT
KID 20 LÁRÉTT
I BÄGAR BRÚNIR.

SKÝRINGAR:

ALMENNAR SKÝRINGAR SJA BL. NR. 1-01
SNID B-8+9 SJA BL. NR. 1-08.

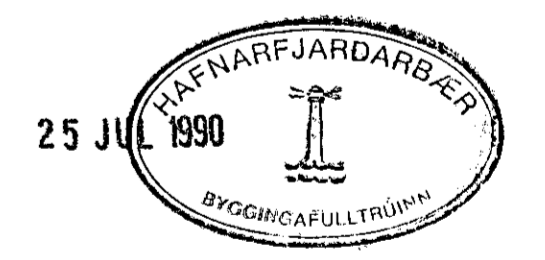

01	24.07.90	BETT VED SNID 10-10 GRIND I BITA	
BR.NR.	DAGS	EDLI BREYTINGAR	SIGN.
SVEJURGATA 94 HAFNARFJARDI			DAGS JUL 90
GRUNNMÝND PAKS			HANNAS
MELIKV. 1:50			TEIKNAD
SIGURÐUR ÞORLEIFSSON TEKNIFRÆÐINGUR F.T.F.I.			VERK NR. 8953
STRANDGÖTU 11 HAFNARFJARDI SÍMI 54751			BLAD NR. 1-07