


GRUNNMYND 1:50

ÖLL ÓNEFND MÁL ERU CM
 SPERRUR : 5x10 60 NEMA
 YFIR SÓLSTOFU, 5x20 60
 KVERKSPERRUR 5x15 (2"x6")
 FÓTREIMAR : 5x10 (2"x4")

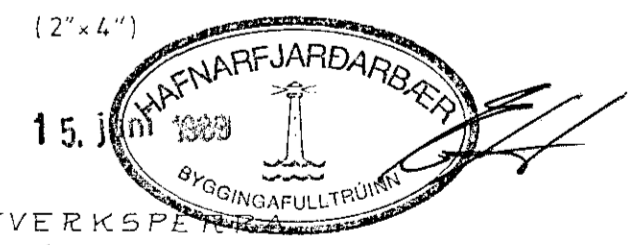

① BR MAÍ 89: KVERKSPERRA

A.J.H.

TEIKNING NR. 882-01-05	DAGS	NAFN	YFIRF
STUÐLABERG 10	Mælt:		
HAFNARFIRÐI	Hannað: JAN 89	K.K.	<i>KK</i>
	Teiknað: JAN 89	SEK.	
PAKVIRKI : GRUNNMYND	Mælikv		
	1:50		
KRISTJÁN KNÚTSSON TÆKNIFR. E.T.F.Í.	Samb		
LYNGBERGI 27, HAFNARFIRÐI, S. 651647			