


EINNIG MÅ Hafa ÞAK EFTIRFARANDI

SÚLA 2 x 2 x 4 7 STK
MÁNÍAS 2 x 2 x 8"

G. RÚI YFIR SPERRUR
YFIR MÁNÍAS NEÐUR A SÚLUR
2 x 2 x 8"
2 x 2 x 4 c 330-370

SKÝRINGAR:
SPERRUR OG STÓLA SEM LIGGJA A EDA AD STEYPU SKAL RÝÐA MÈÐ FUAVARNAREFNI. ALLUR SAUMUR I ÞAKI SKAL VERA ZINKHÚÐADUR.
STÓLA SKAL SETJA A VÍXL SINN HVORU MEGIN AD SPERRU.

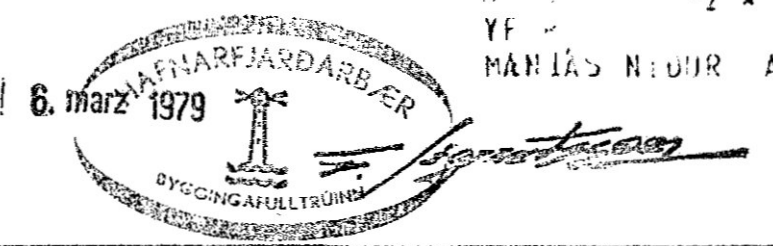

SÆVANGUR 2	MÆLIKVARDI 1:20 1:50	VERK 7625	TEIKN NR 1.3
ÞAK	Hannað: <i>GB</i> Teiknað: <i>BJ</i>	Yfirfarið: Samb: <i>GB</i>	DAGS JÚLÍ 77
JÓHANN GUNNAR BERGPÓRSSON STRANDGÖTU 11 — HAFNARFIRÐI — SÍMI 63315	VERKFR MVFI BREYTT JAN. '79		