
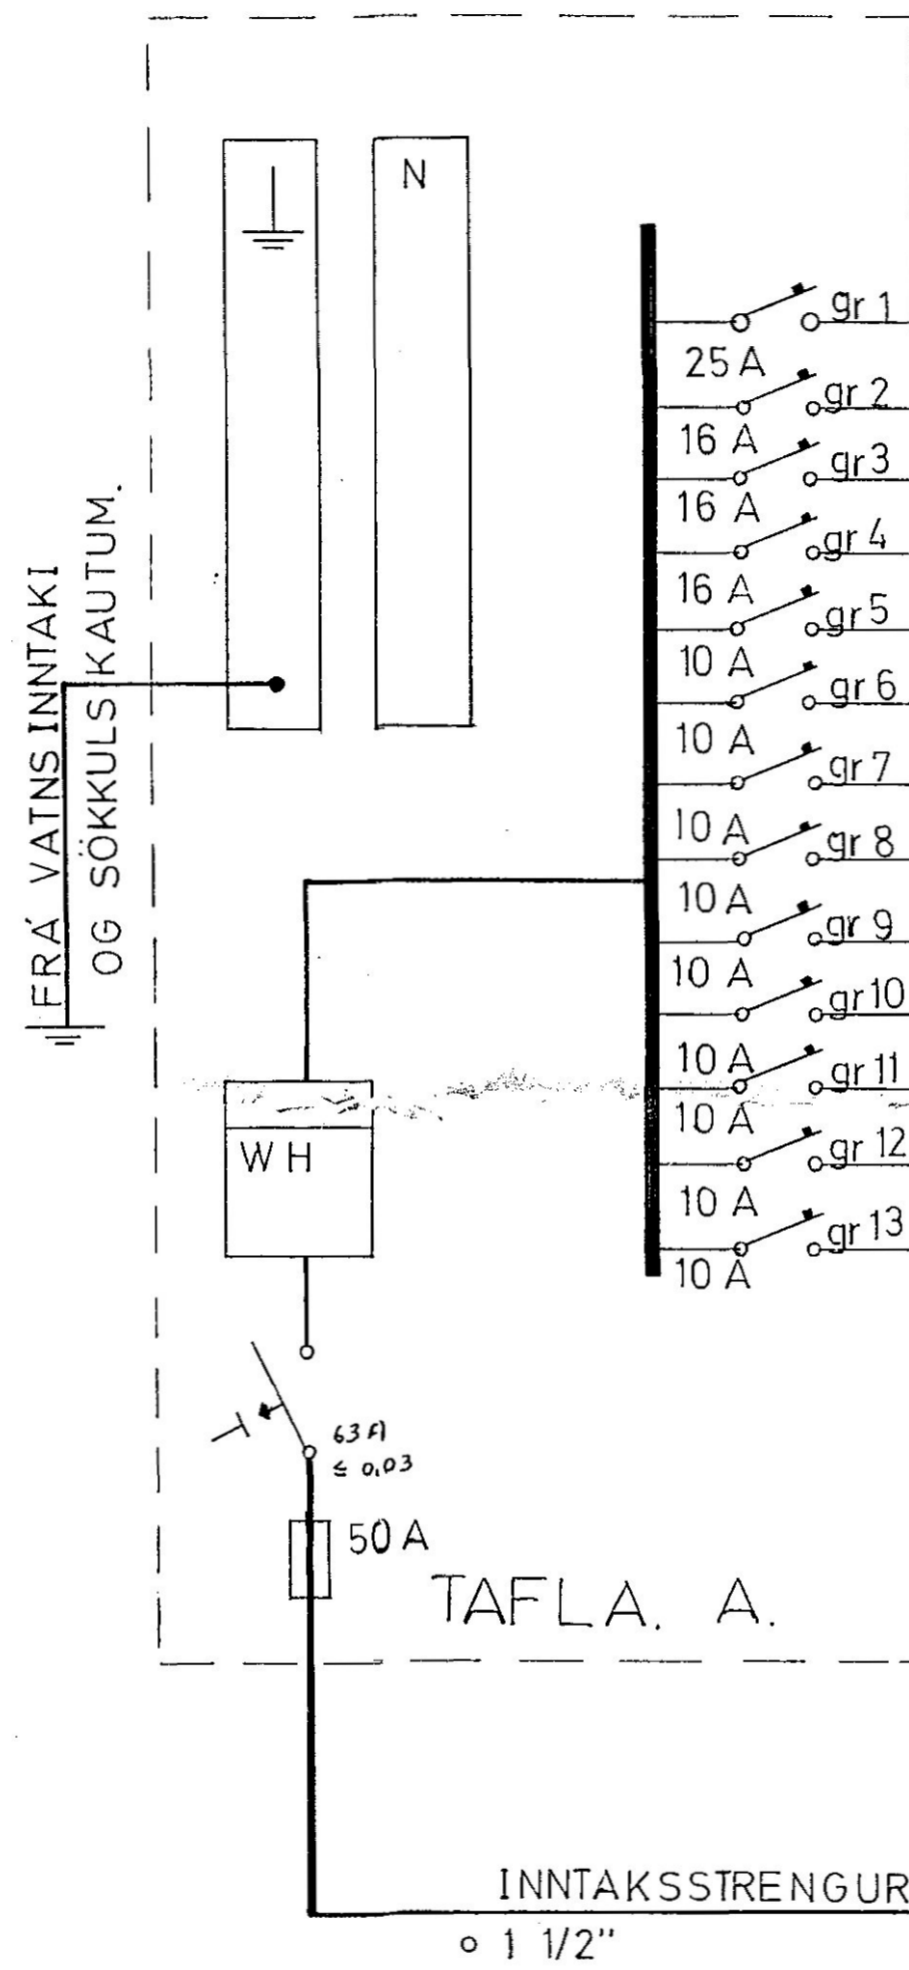


Húsvéltá nr. 510 Teikning nr. 1791
 Samþykkt þ. 2-3 1979
 f.h. RAFVEITU HAFNARFIJARDAR
Jens Guðsson
 Elfréttismeðfar rálögna

Inntök samþykkt 2.15. 1979
 f.h. RAFVEITU HAFNARFIJARDAR
Rúnar Sigurðsson

SÆVANGUR 5.
 HAFNARF.

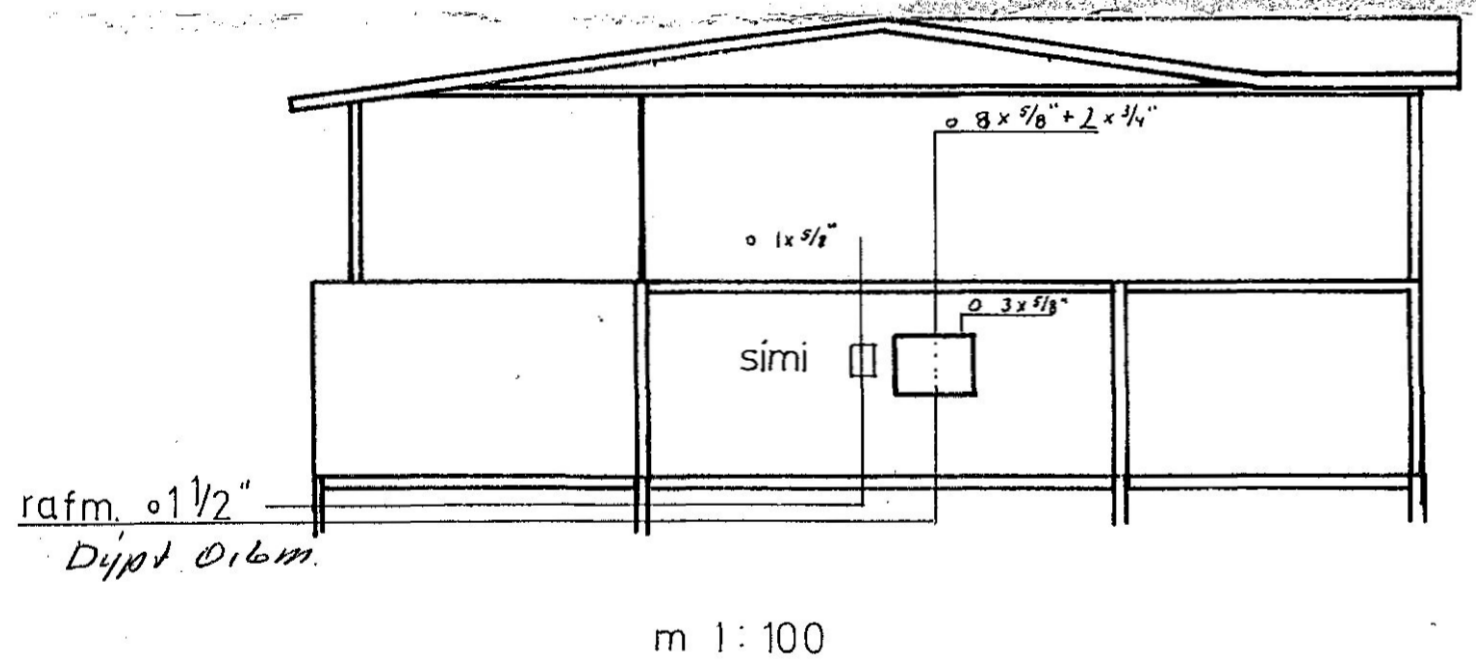

25 A	gr 1	3/4"	3	4 ²	☐	ELDAVÉL.
16 A	gr 2	3/4"	3	1,5 ²	☐	UPPTHVOTTAVÉL.
16 A	gr 3	5/8"	3	1,5 ²	☐	THVOTTAVÉL.
16 A	gr 4	5/8"	3	1,5 ²	☐	THURKARI.
10 A	gr 5	5/8"	3	1,5 ²	✕	ELDHÚS, BÚR, THVOTTAH., G.WC, FORSTOFA, HÚSB. HERB.
10 A	gr 6	5/8"	3	1,5 ²	✕	STOFA.
10 A	gr 7	5/8"	3	1,5 ²	✕	GANGAR, HOL, STIGI.
10 A	gr 8	5/8"	3	1,5 ²	✕	3. SVEFNHERB, WC.
10 A	gr 9	5/8"	3	1,5 ²	○	DYRASÝMI.
10 A	gr 10	5/8"	3	1,5 ²	☐	TENGLAR ELDHÚSI.
10 A	gr 11	5/8"	3	1,5 ²	✕	HERBERGI KJALLARA.
10 A	gr 12	5/8"	3	1,5 ²	✕	GEYMSLUR, GANGAR, KJ.
10 A	gr 13	5/8"	3	1,5 ²	✕	BÍLSKÚR.

- ELDAVÉL.
- UPPTHVOTTAVÉL.
- THVOTTAVÉL.
- THURKARI.
- ELDHÚS, BÚR, THVOTTAH., G.WC,
FORSTOFA, HÚSB. HERB.
- STOFA.
- GANGAR, HOL, STIGI.
- 3. SVEFNHERB, WC.
- DYRASÝMI.
- TENGLAR ELDHÚSI.
- HERBERGI KJALLARA.
- GEYMSLUR, GANGAR, KJ.
- BÍLSKÚR.

TAFLA. A.

INNTAKSSTRENGUR RAFV.
 1 1/2"

Mkv. 1:100	EINBÝLISHÚS EINLÍNEMYND SNID
Hannað: RS.	
Teiknað: RS.	
Yfirfarið:	
Dags. DES 78	Nr: Blað 1 af 3