



BLAD 4 AF 5

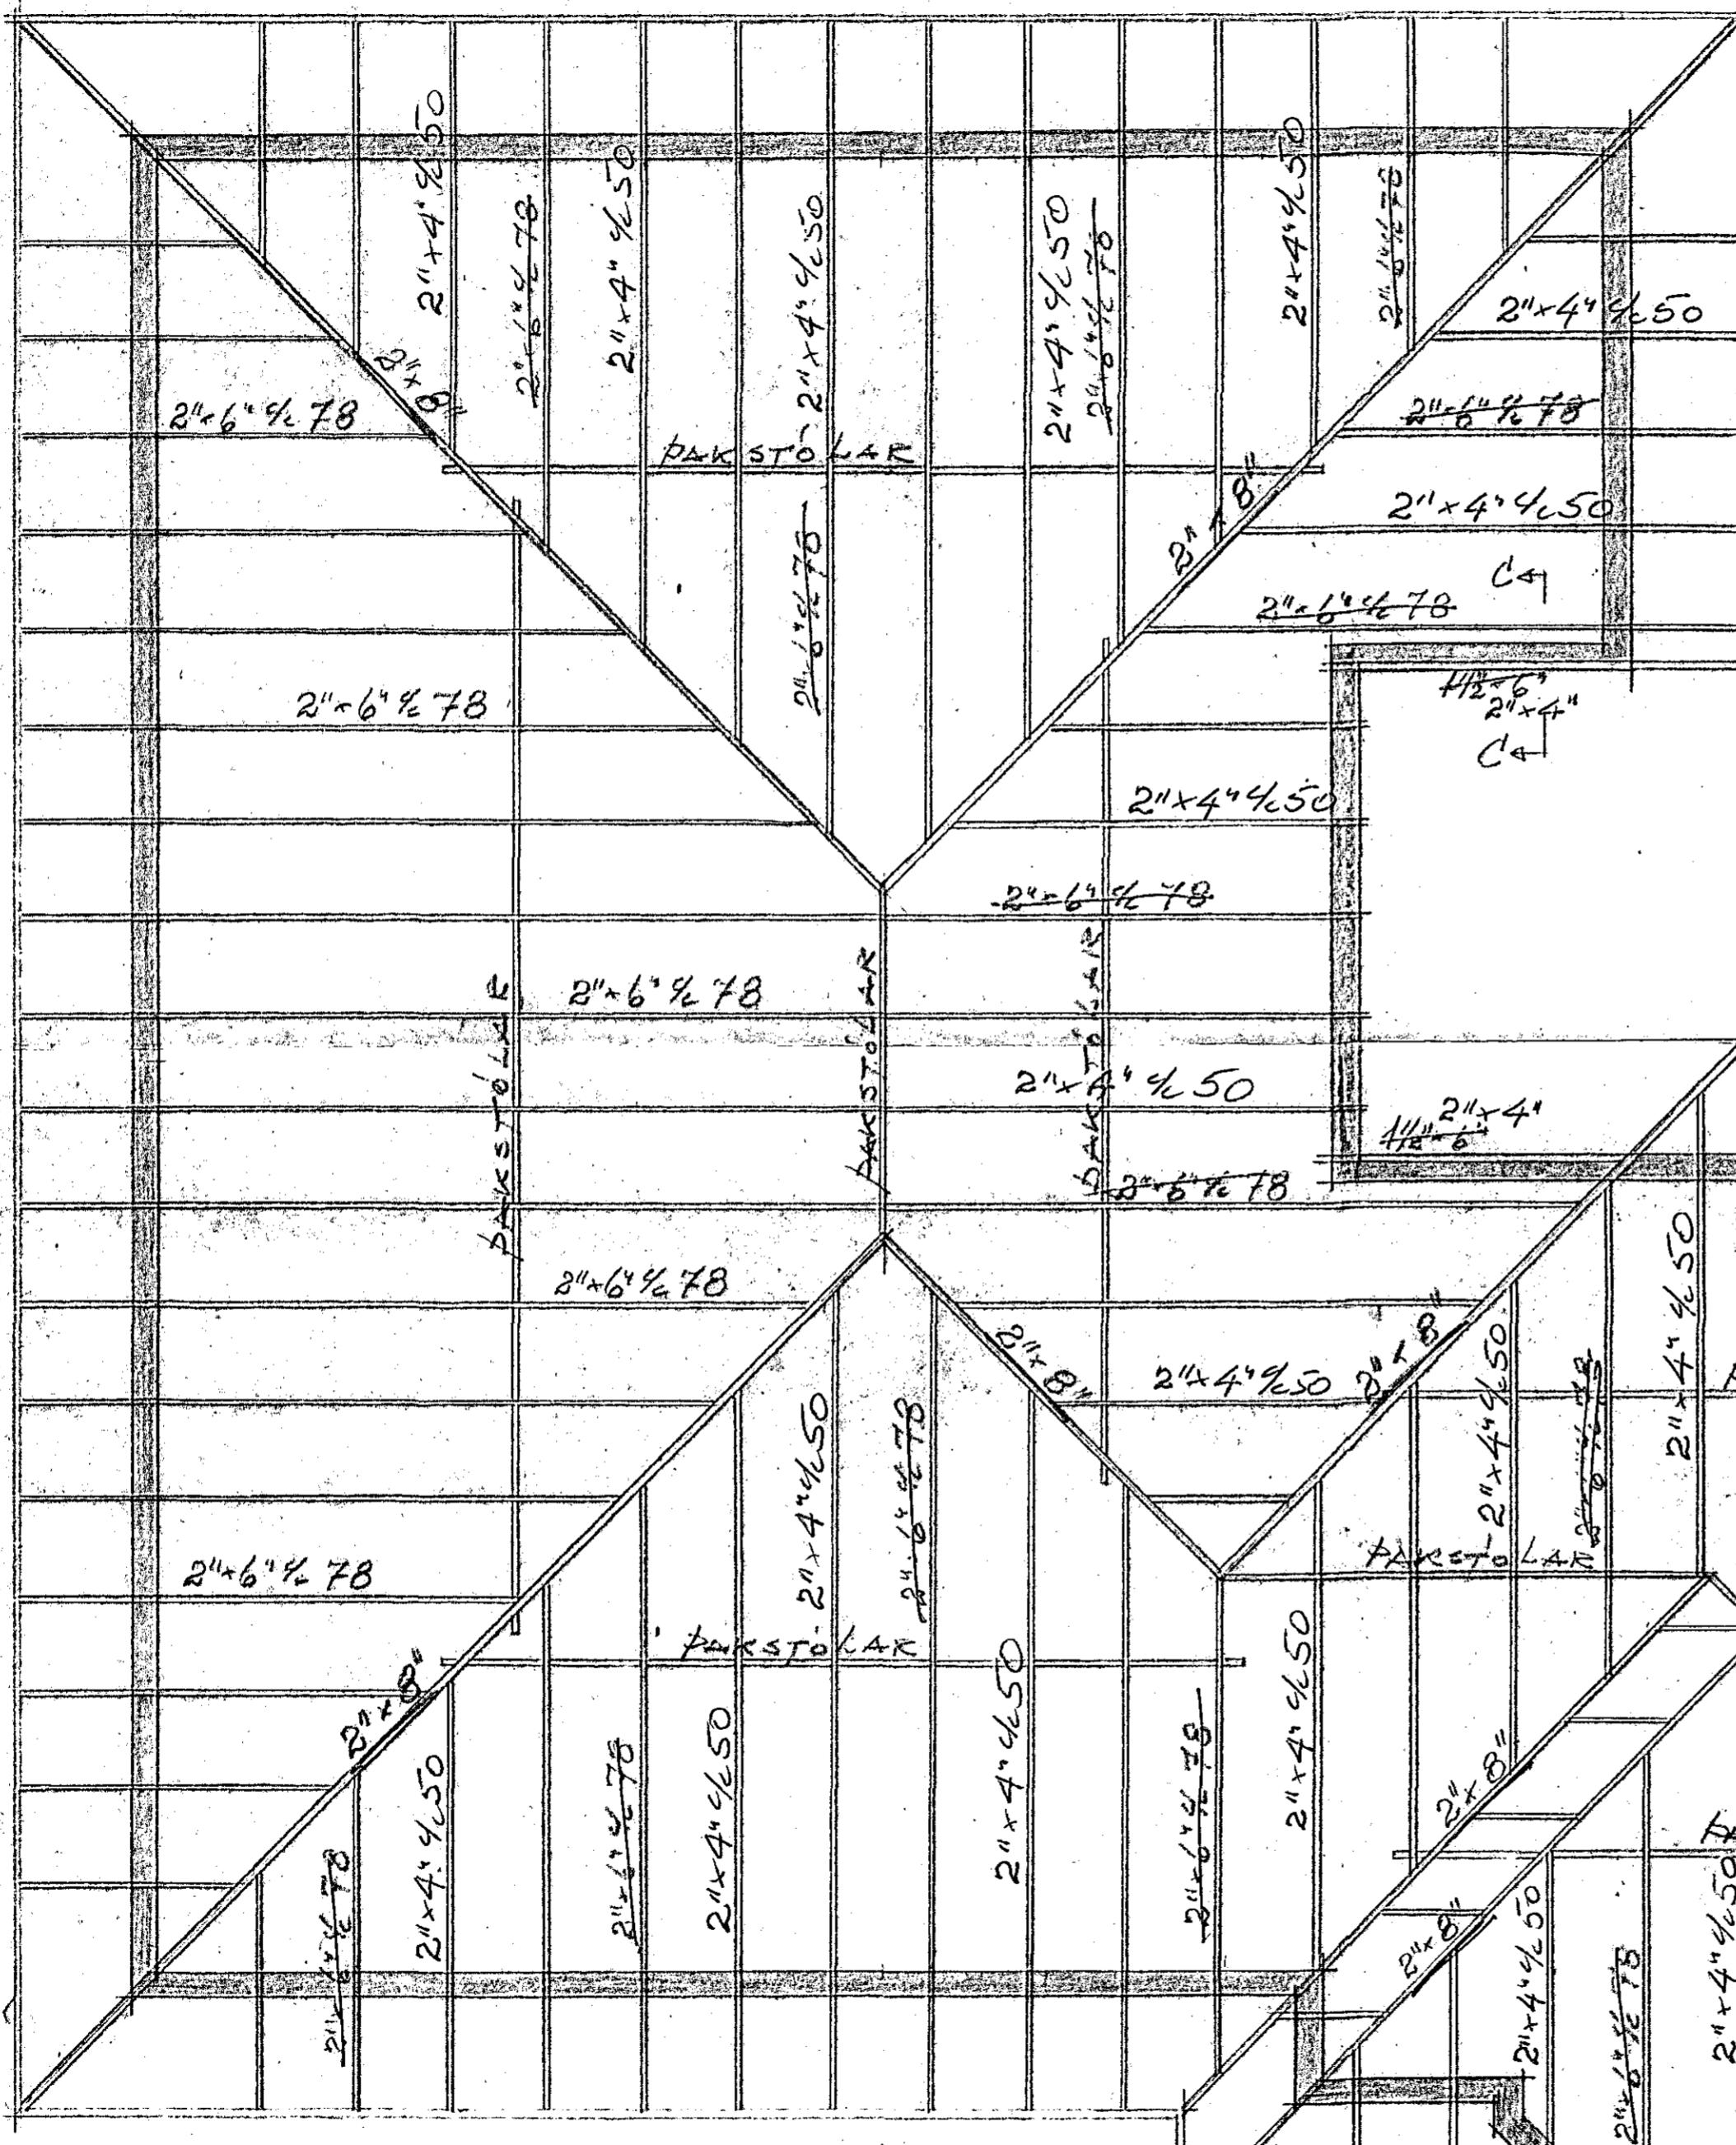

GRUNNMYND

KVADRAT 1:50

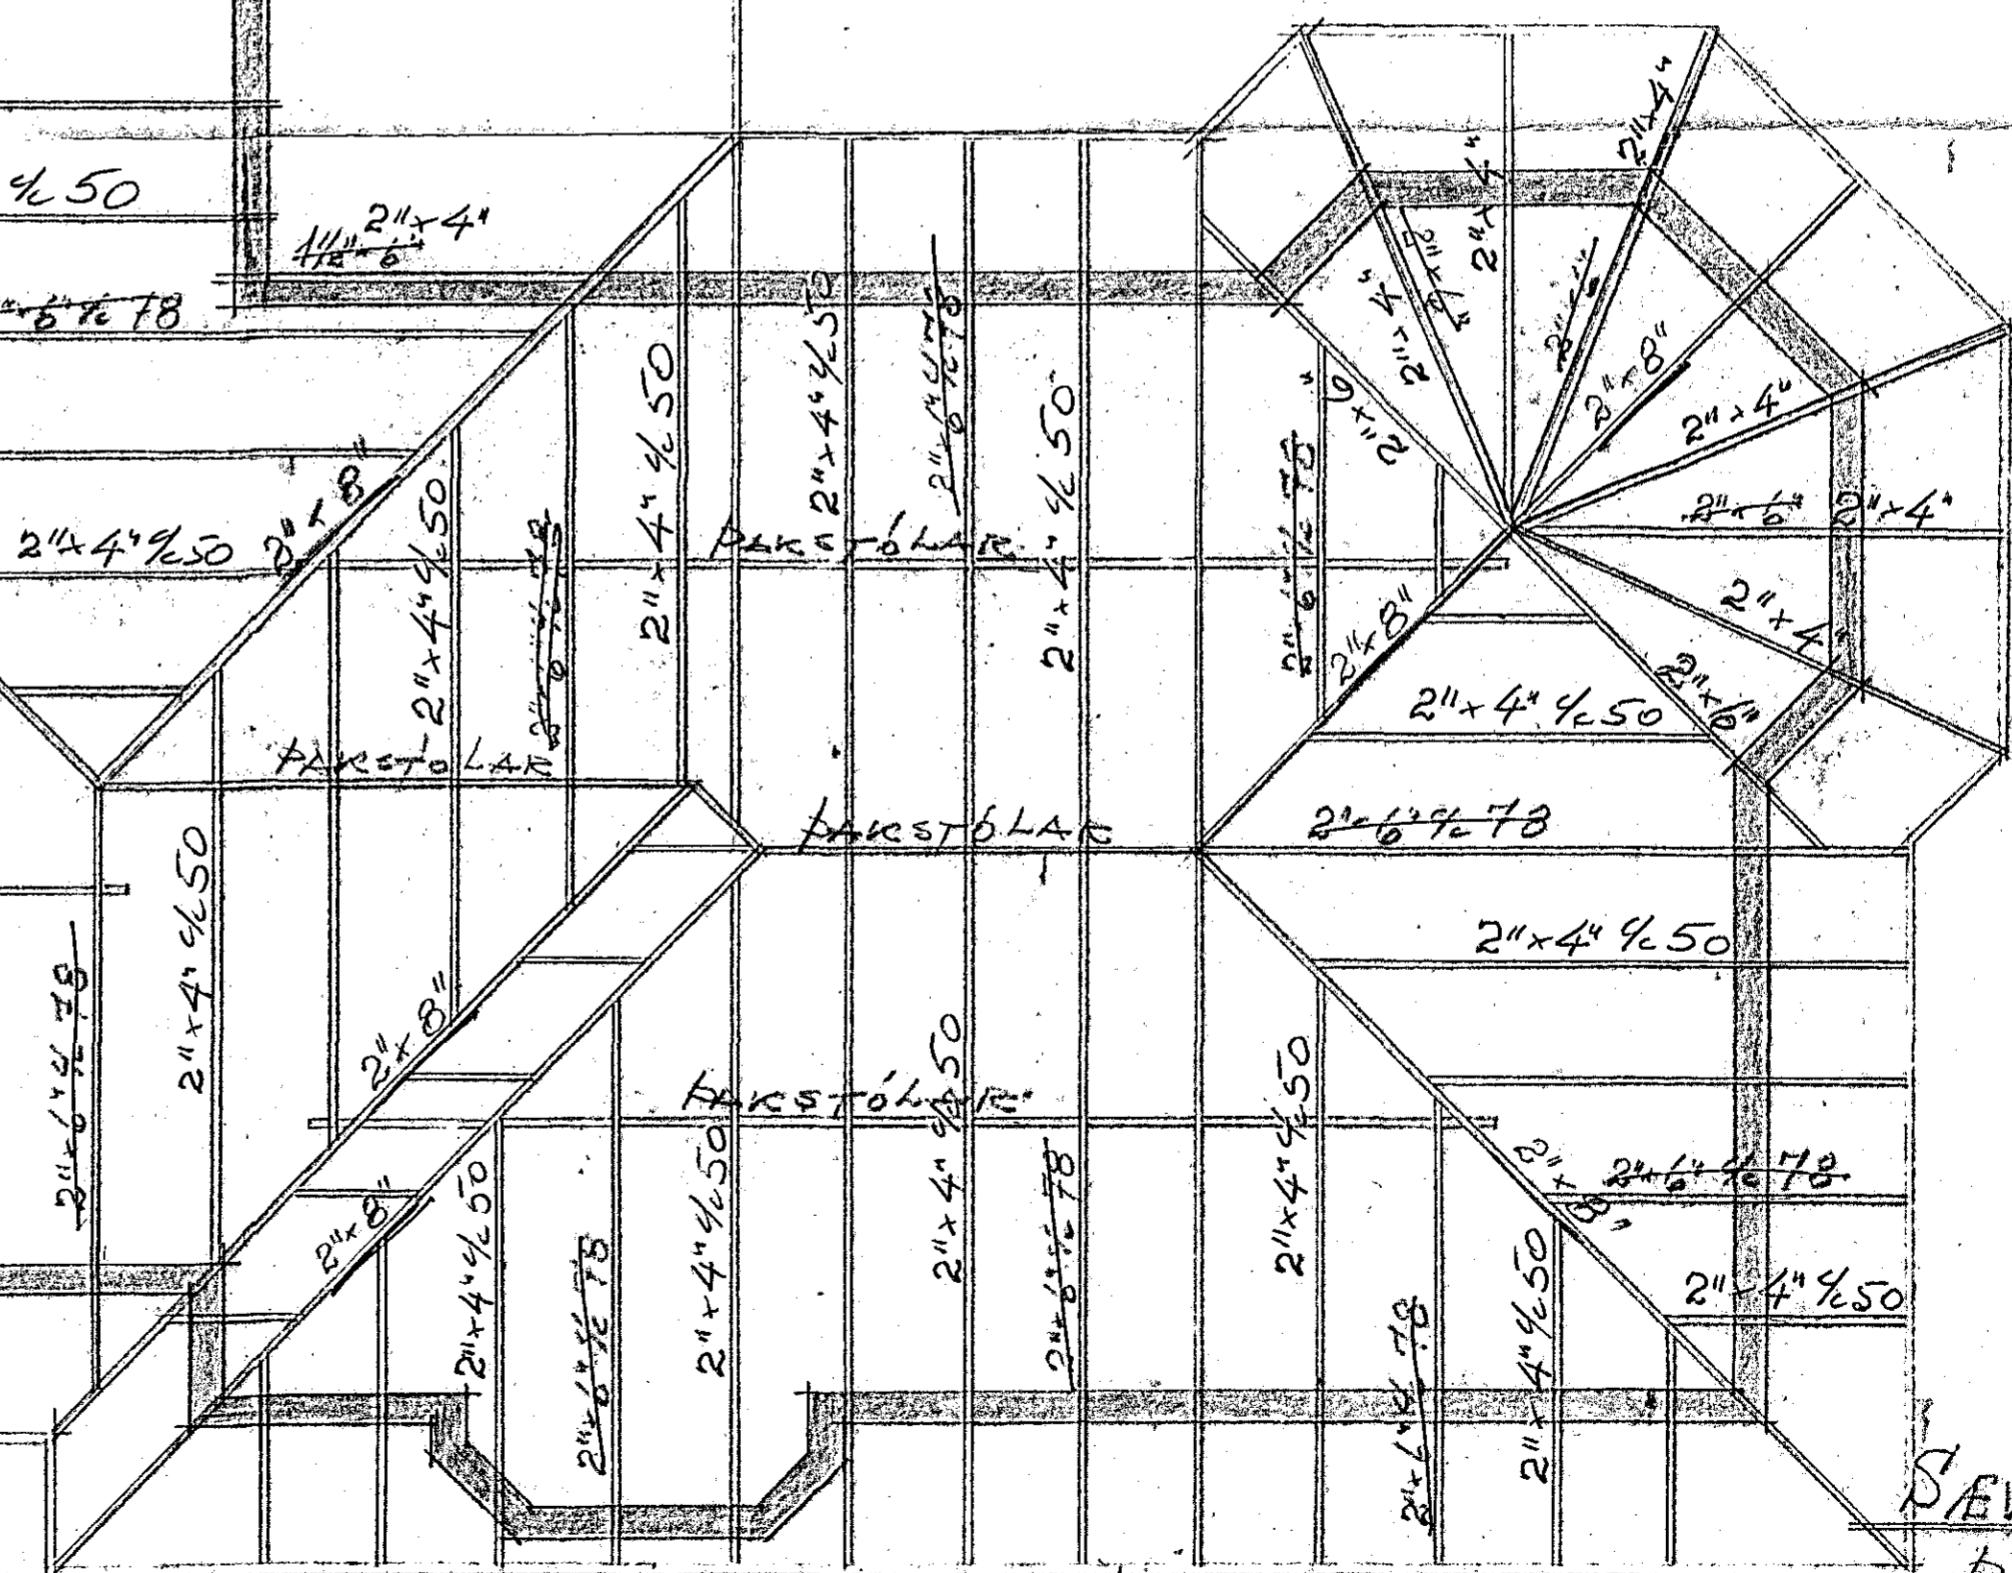

BRETT 1 DES. 1983
Karslium Lufslfss.

SEVANGUR 27

DAKVIDIR

Hafnarfjörður juli 1983
Karslium Lufslfss.