

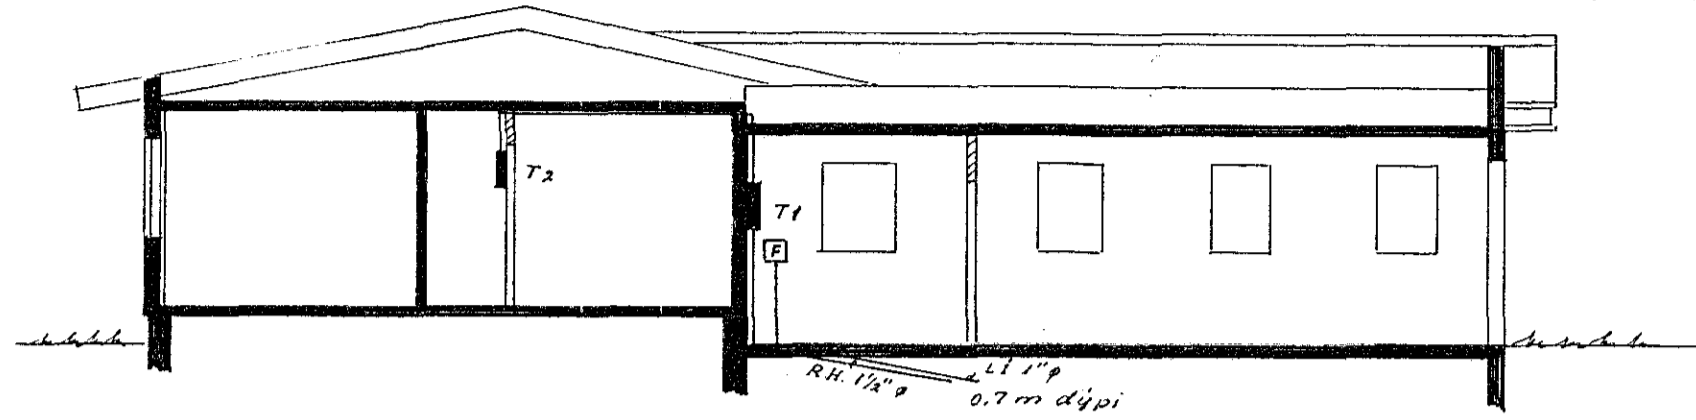
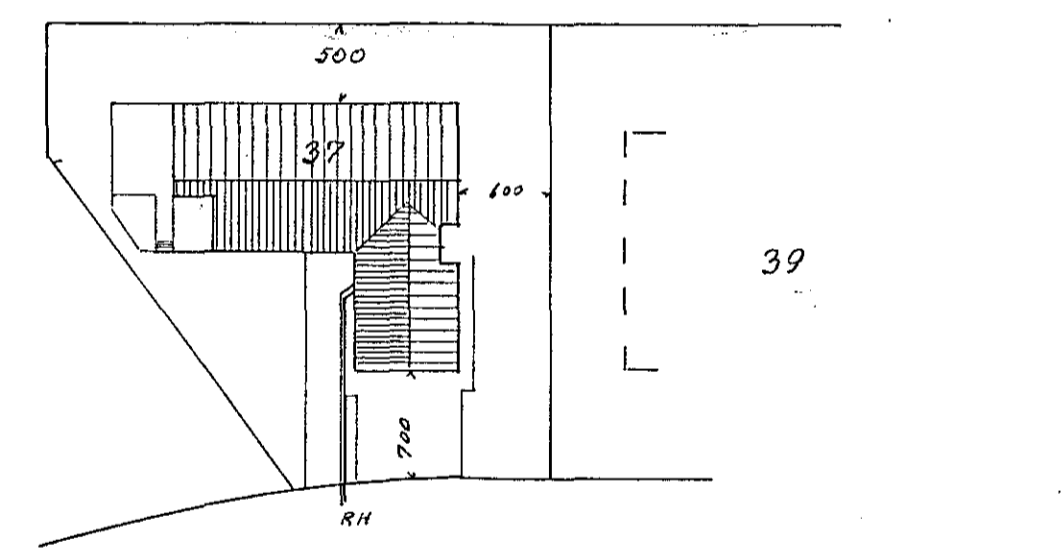


Inntök samþykkt 30/8 1179
 Rafveitull Hafnarfjardar
 Hönduð Höllaugun

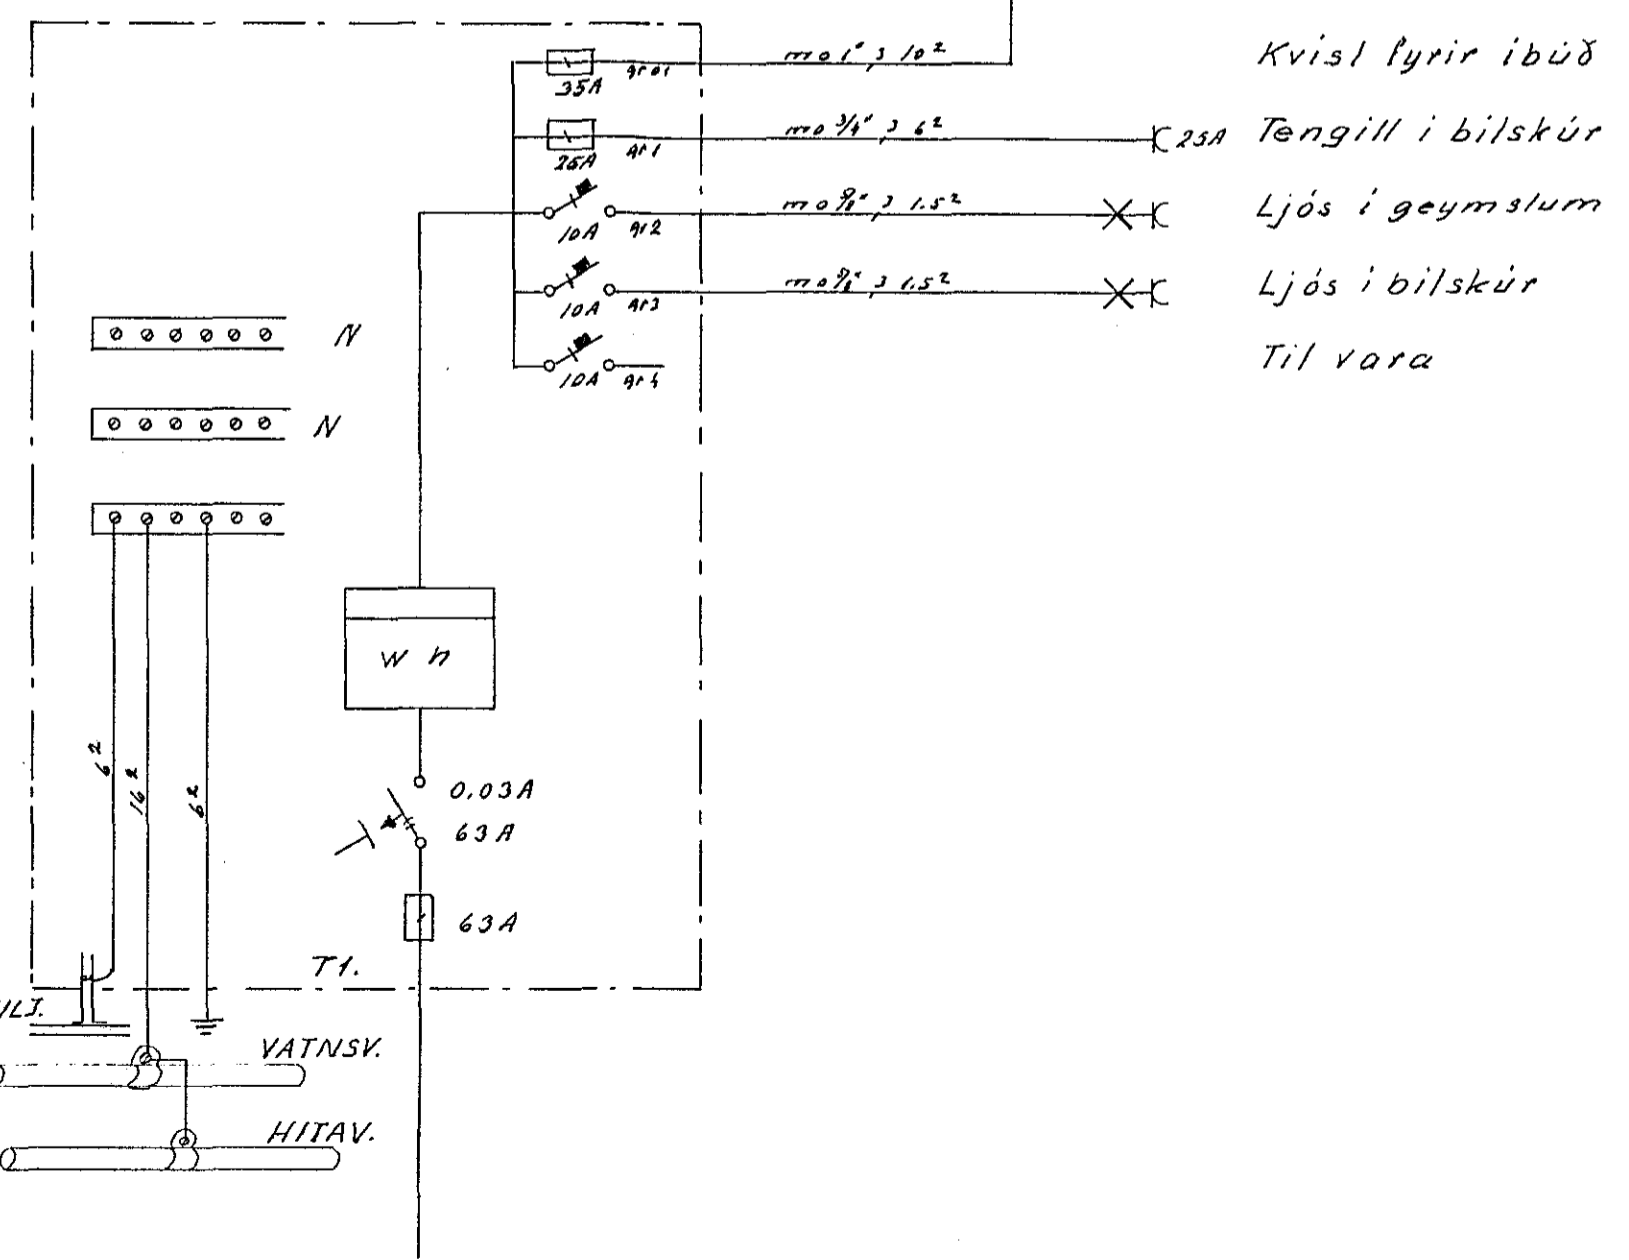

SNID A-A

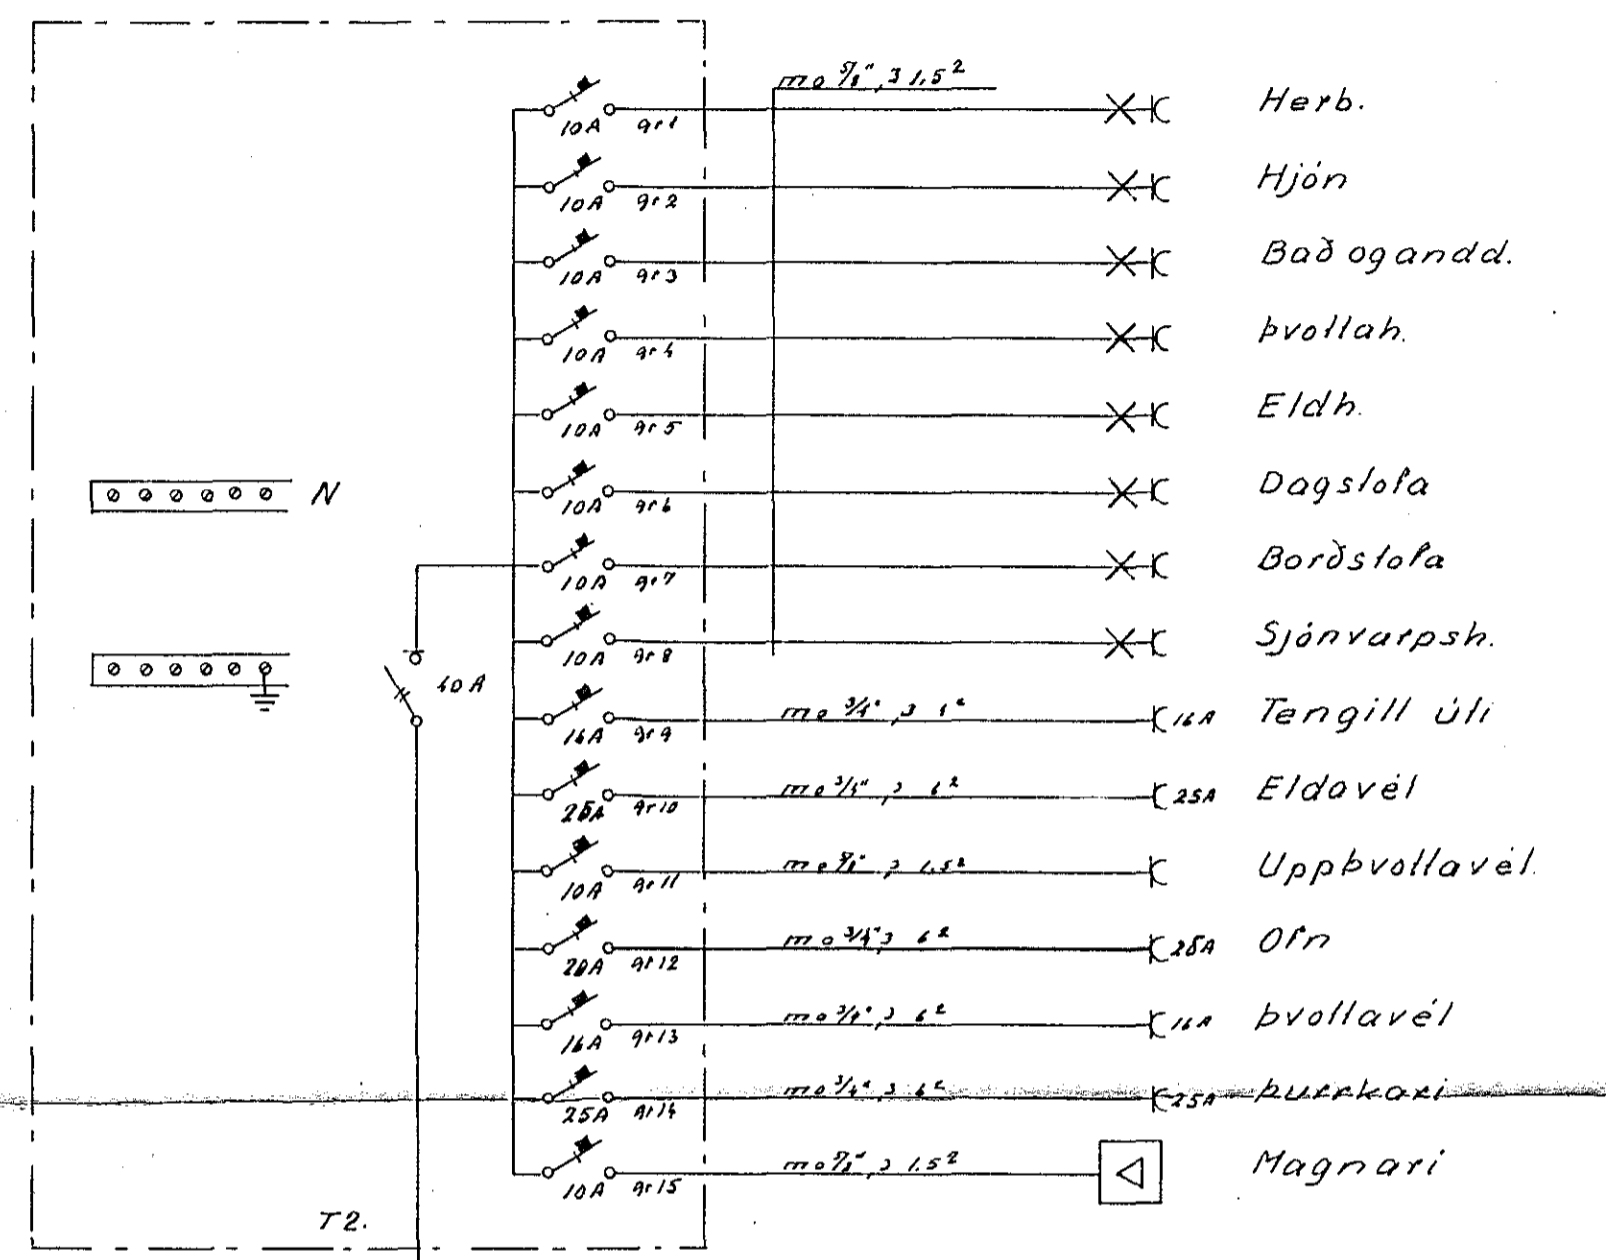

SÆVANGUR

AFSTÖÐUMYND M:1:500

TEIKNISTOFA STEFÁNS VÞORSTEINSSONAR STRANDGÖTU 11 SÍMI 54112	
SÆVANGUR 37 EINLINUMYND AF RAF- TÖFLUM, LANGSKURÐUR OG AFSTÖÐUMYND.	H 511 T 511 S M 1:100 1:500 D 79 02 12 N 339 Bl. 2 af 2 Sleipin H. Þorsteinsson