




SNID A-A 1:20

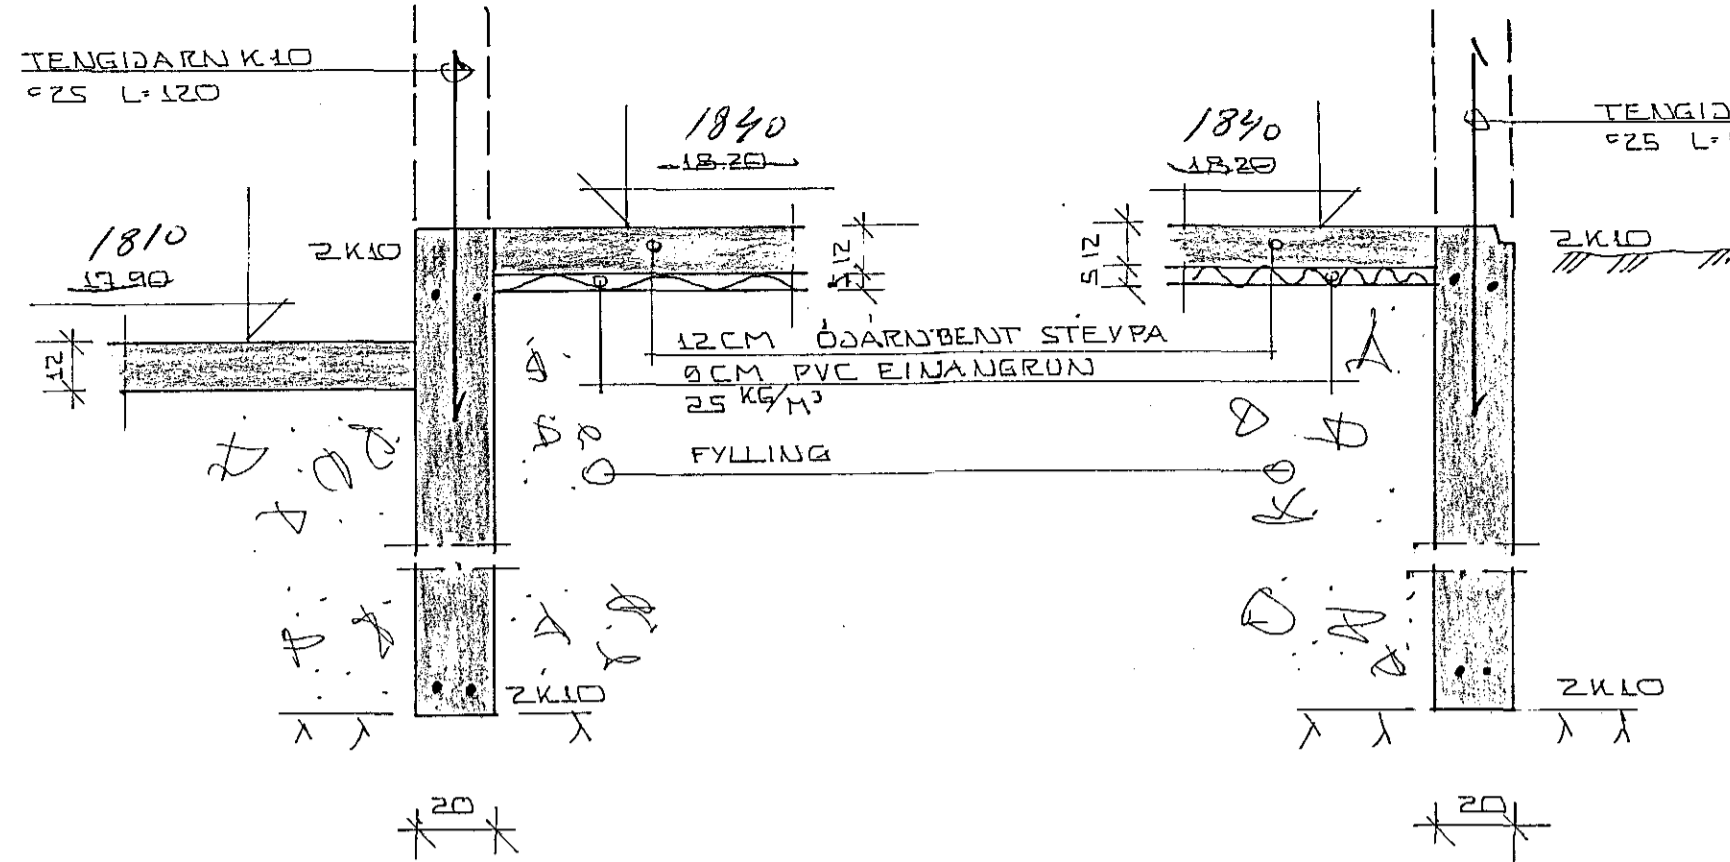


SNID B-B 1:20

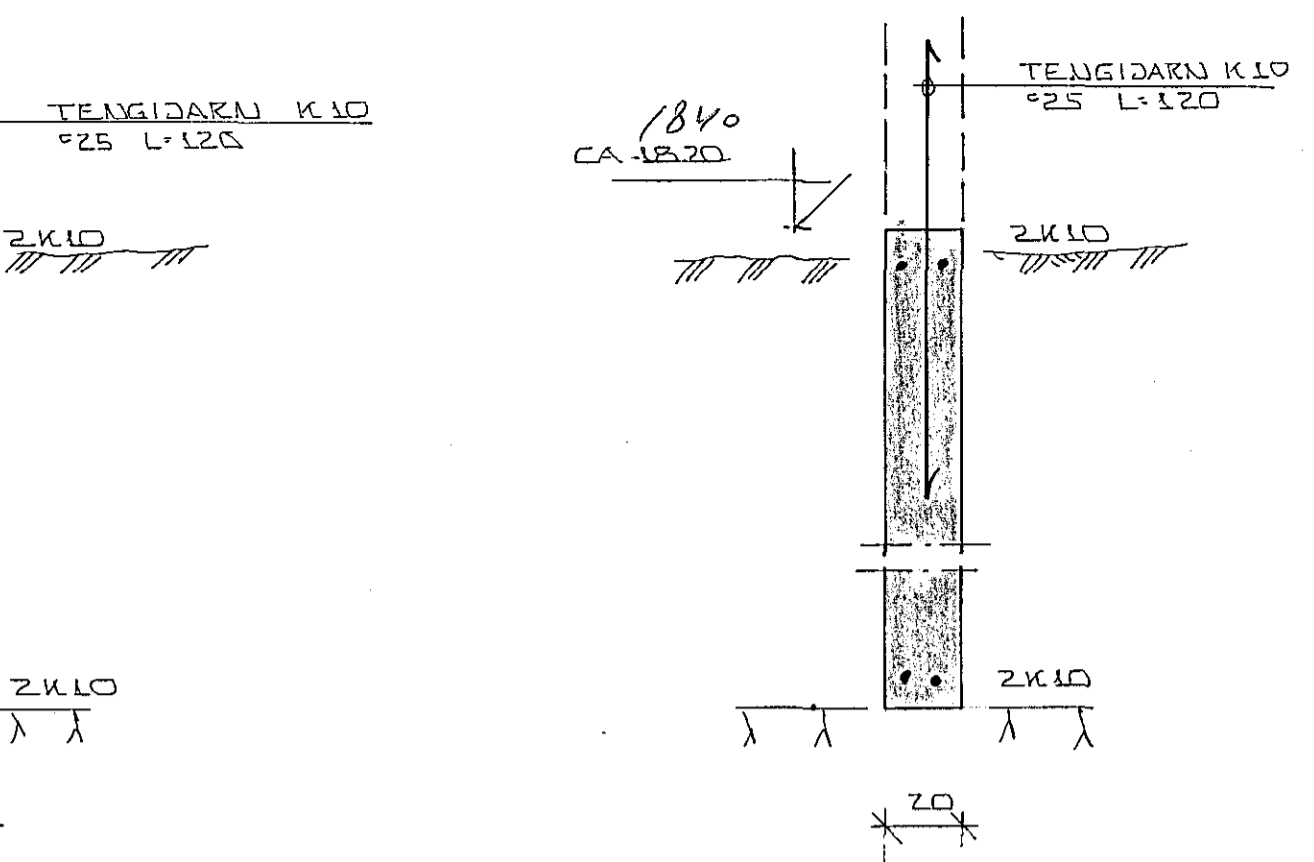


SNID C-C 1:20

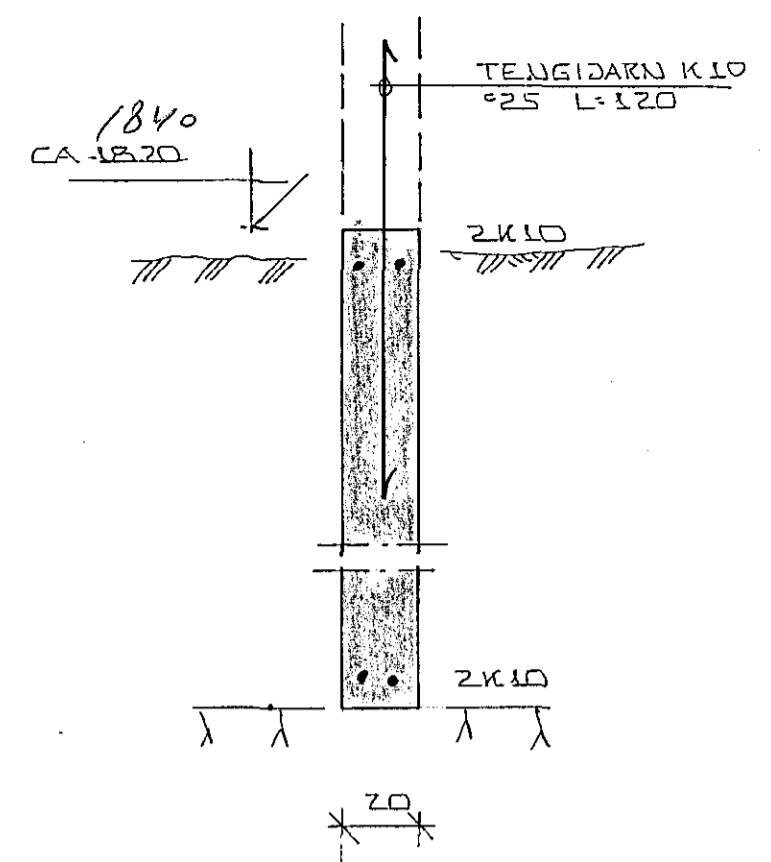


SNID D-D 1:20

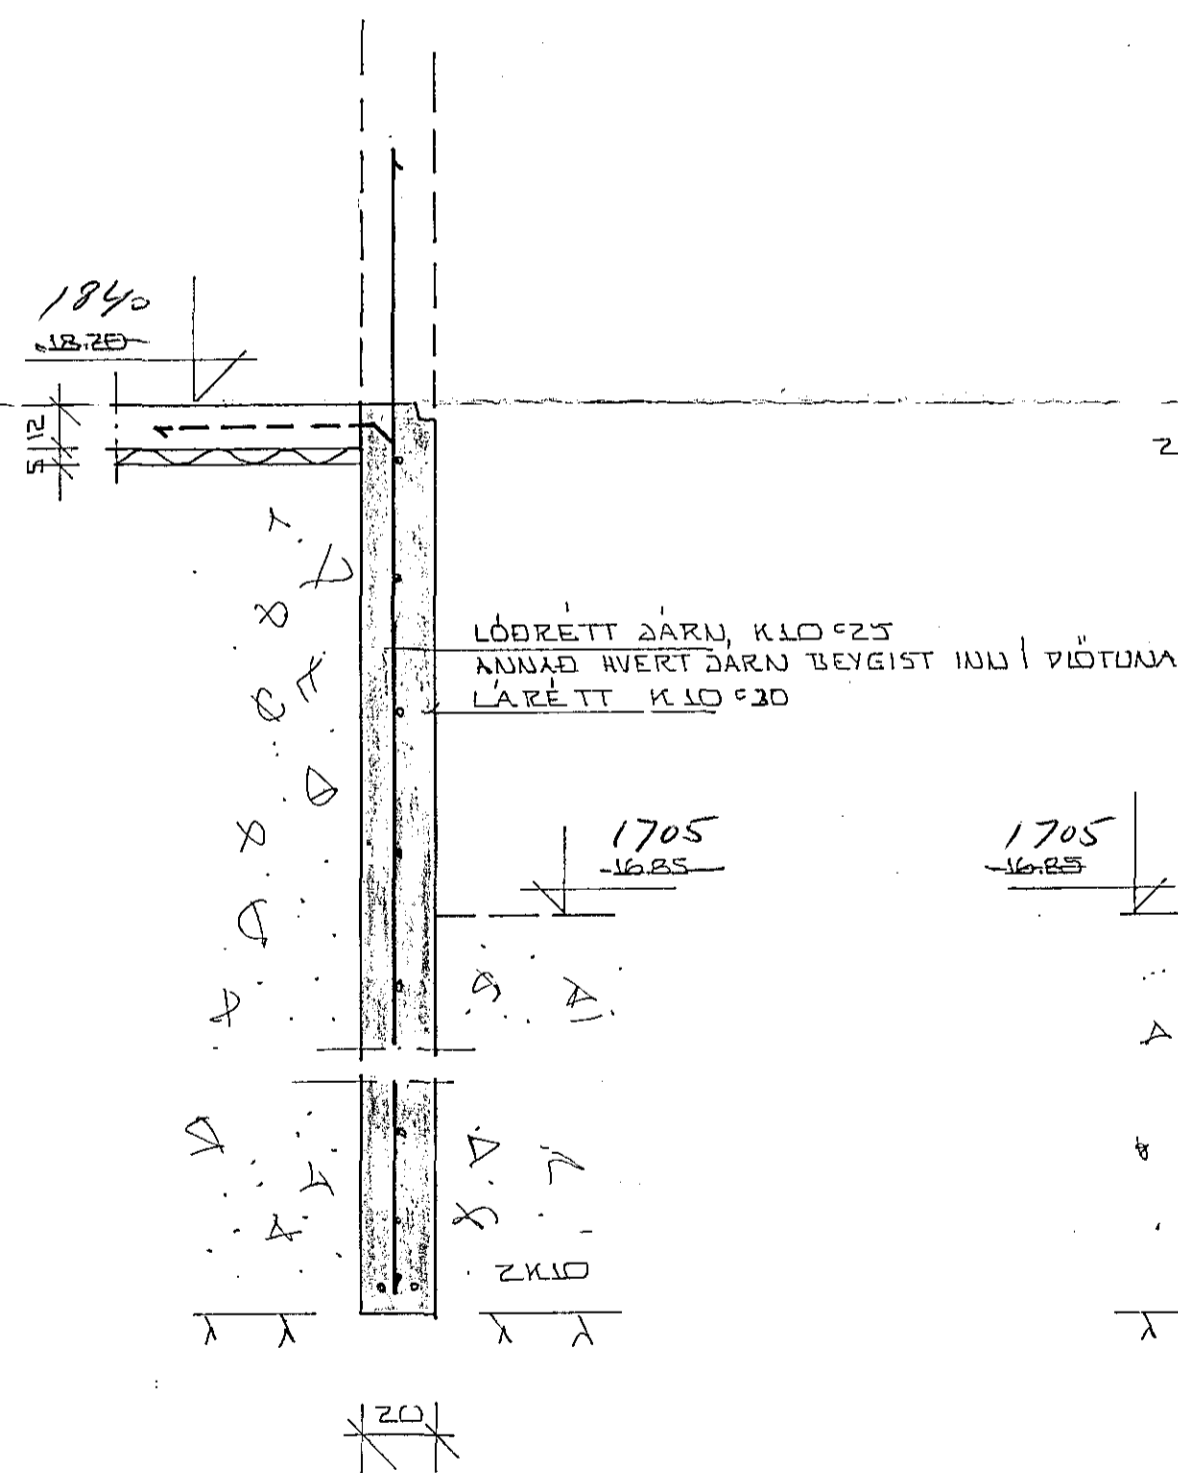


SNID E-E 1:20

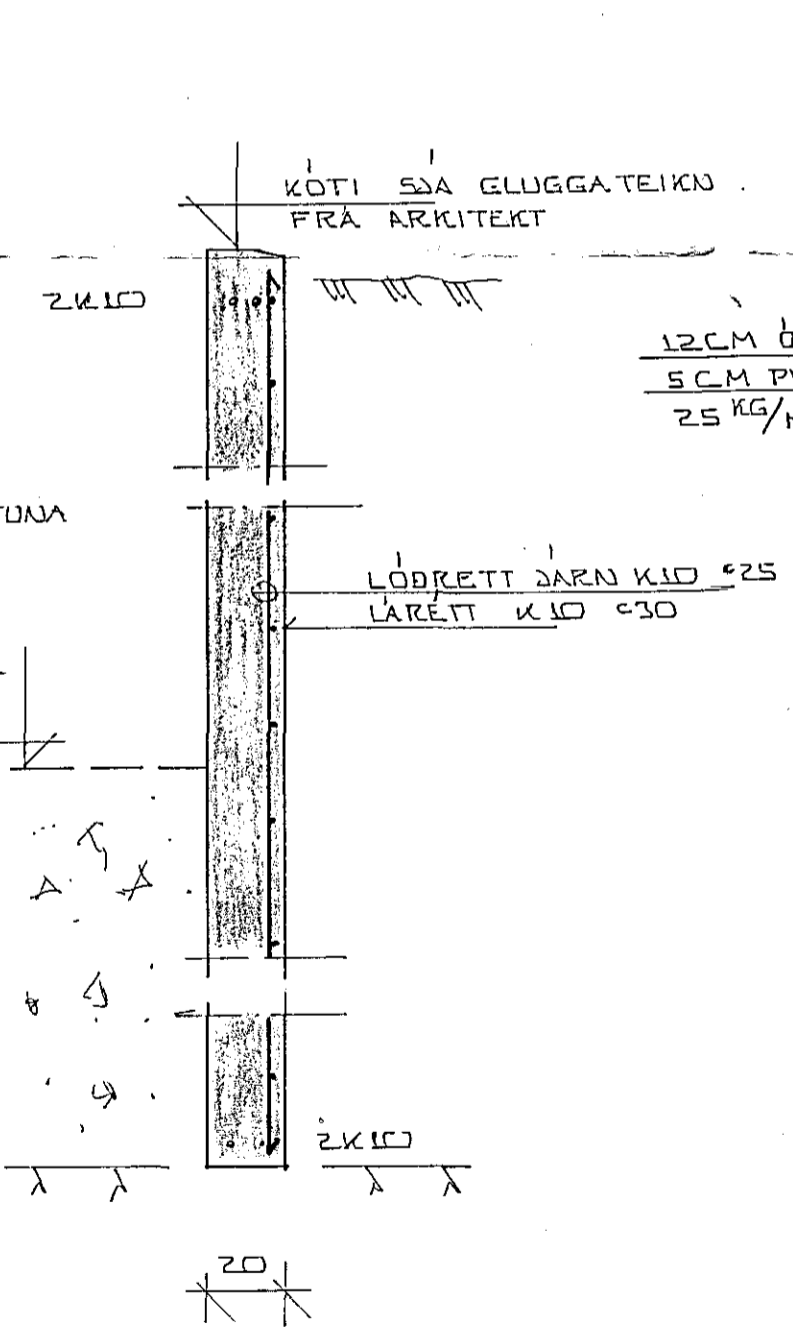

SNID F-F 1:20

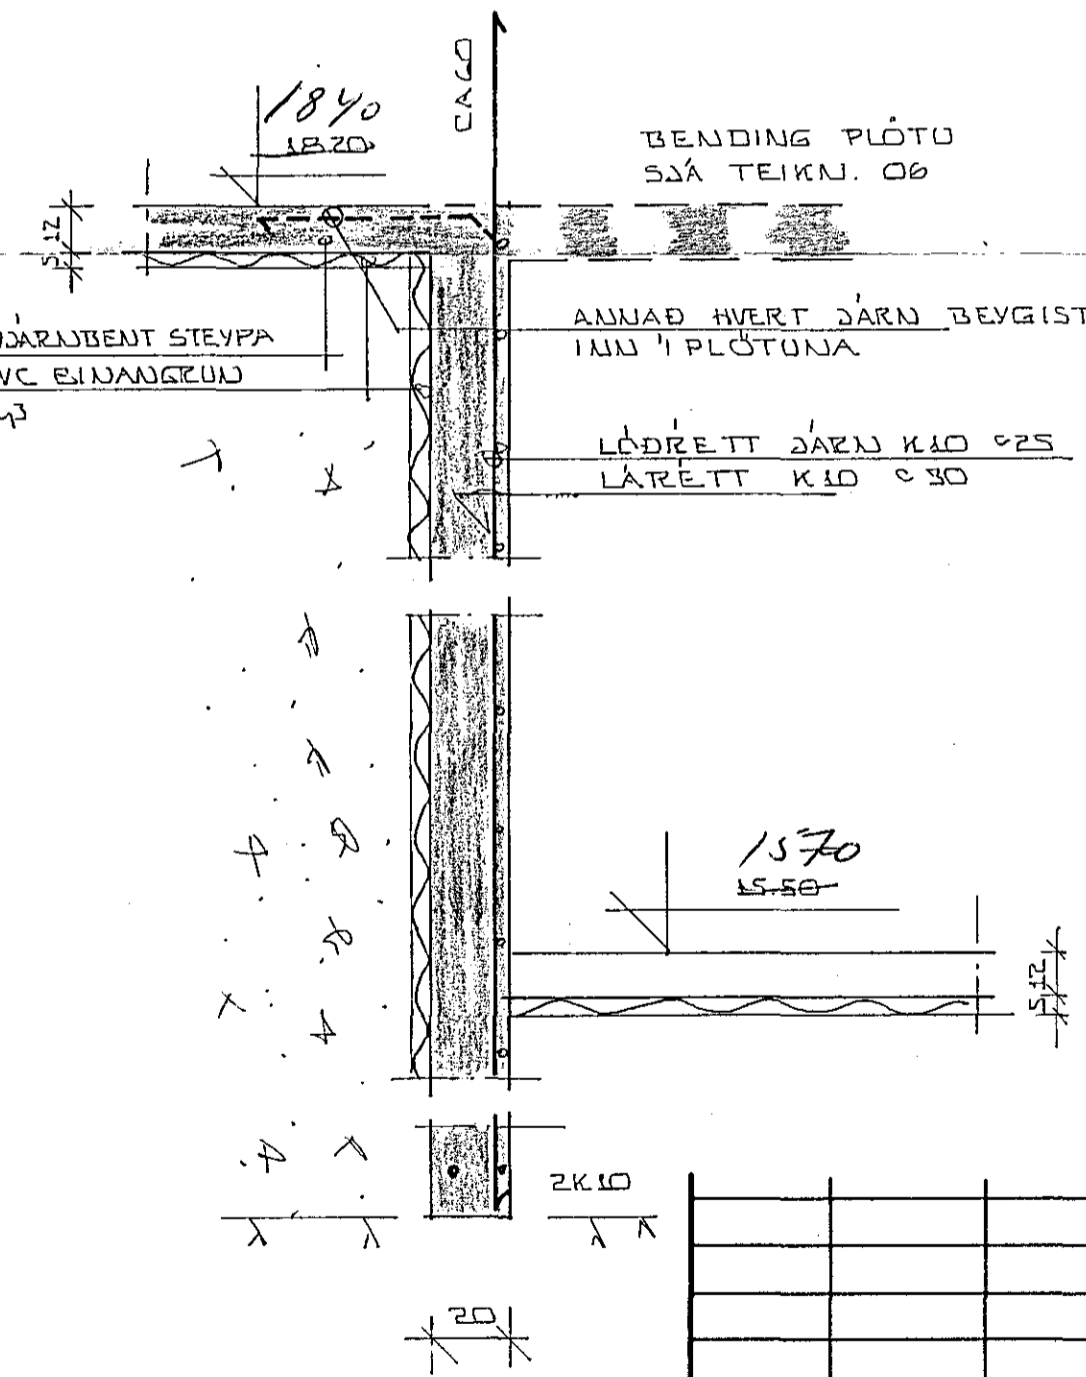


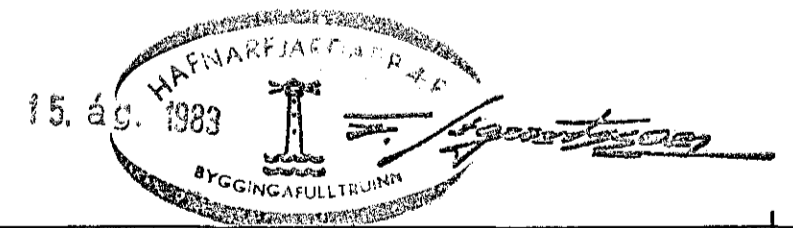

DR. NR.	DAGS.	EDLI BREVTINGAR	SIGN.
SEVANGUR SÍ HAFNARFIRÐI			DAGS. 21. JULI 83
SNID OG SÉRMYNDIR UNDIRSTÖÐUT			HANNAÐ
MÆLIKV. 1:20			TEIKNAD
SIGURÐUR ÞORLEIFSSON			VERK NR. 8335
STRANDGÖTU 11 HAFNARFIRÐI SÍMI 54751			BLAD NR. 03