

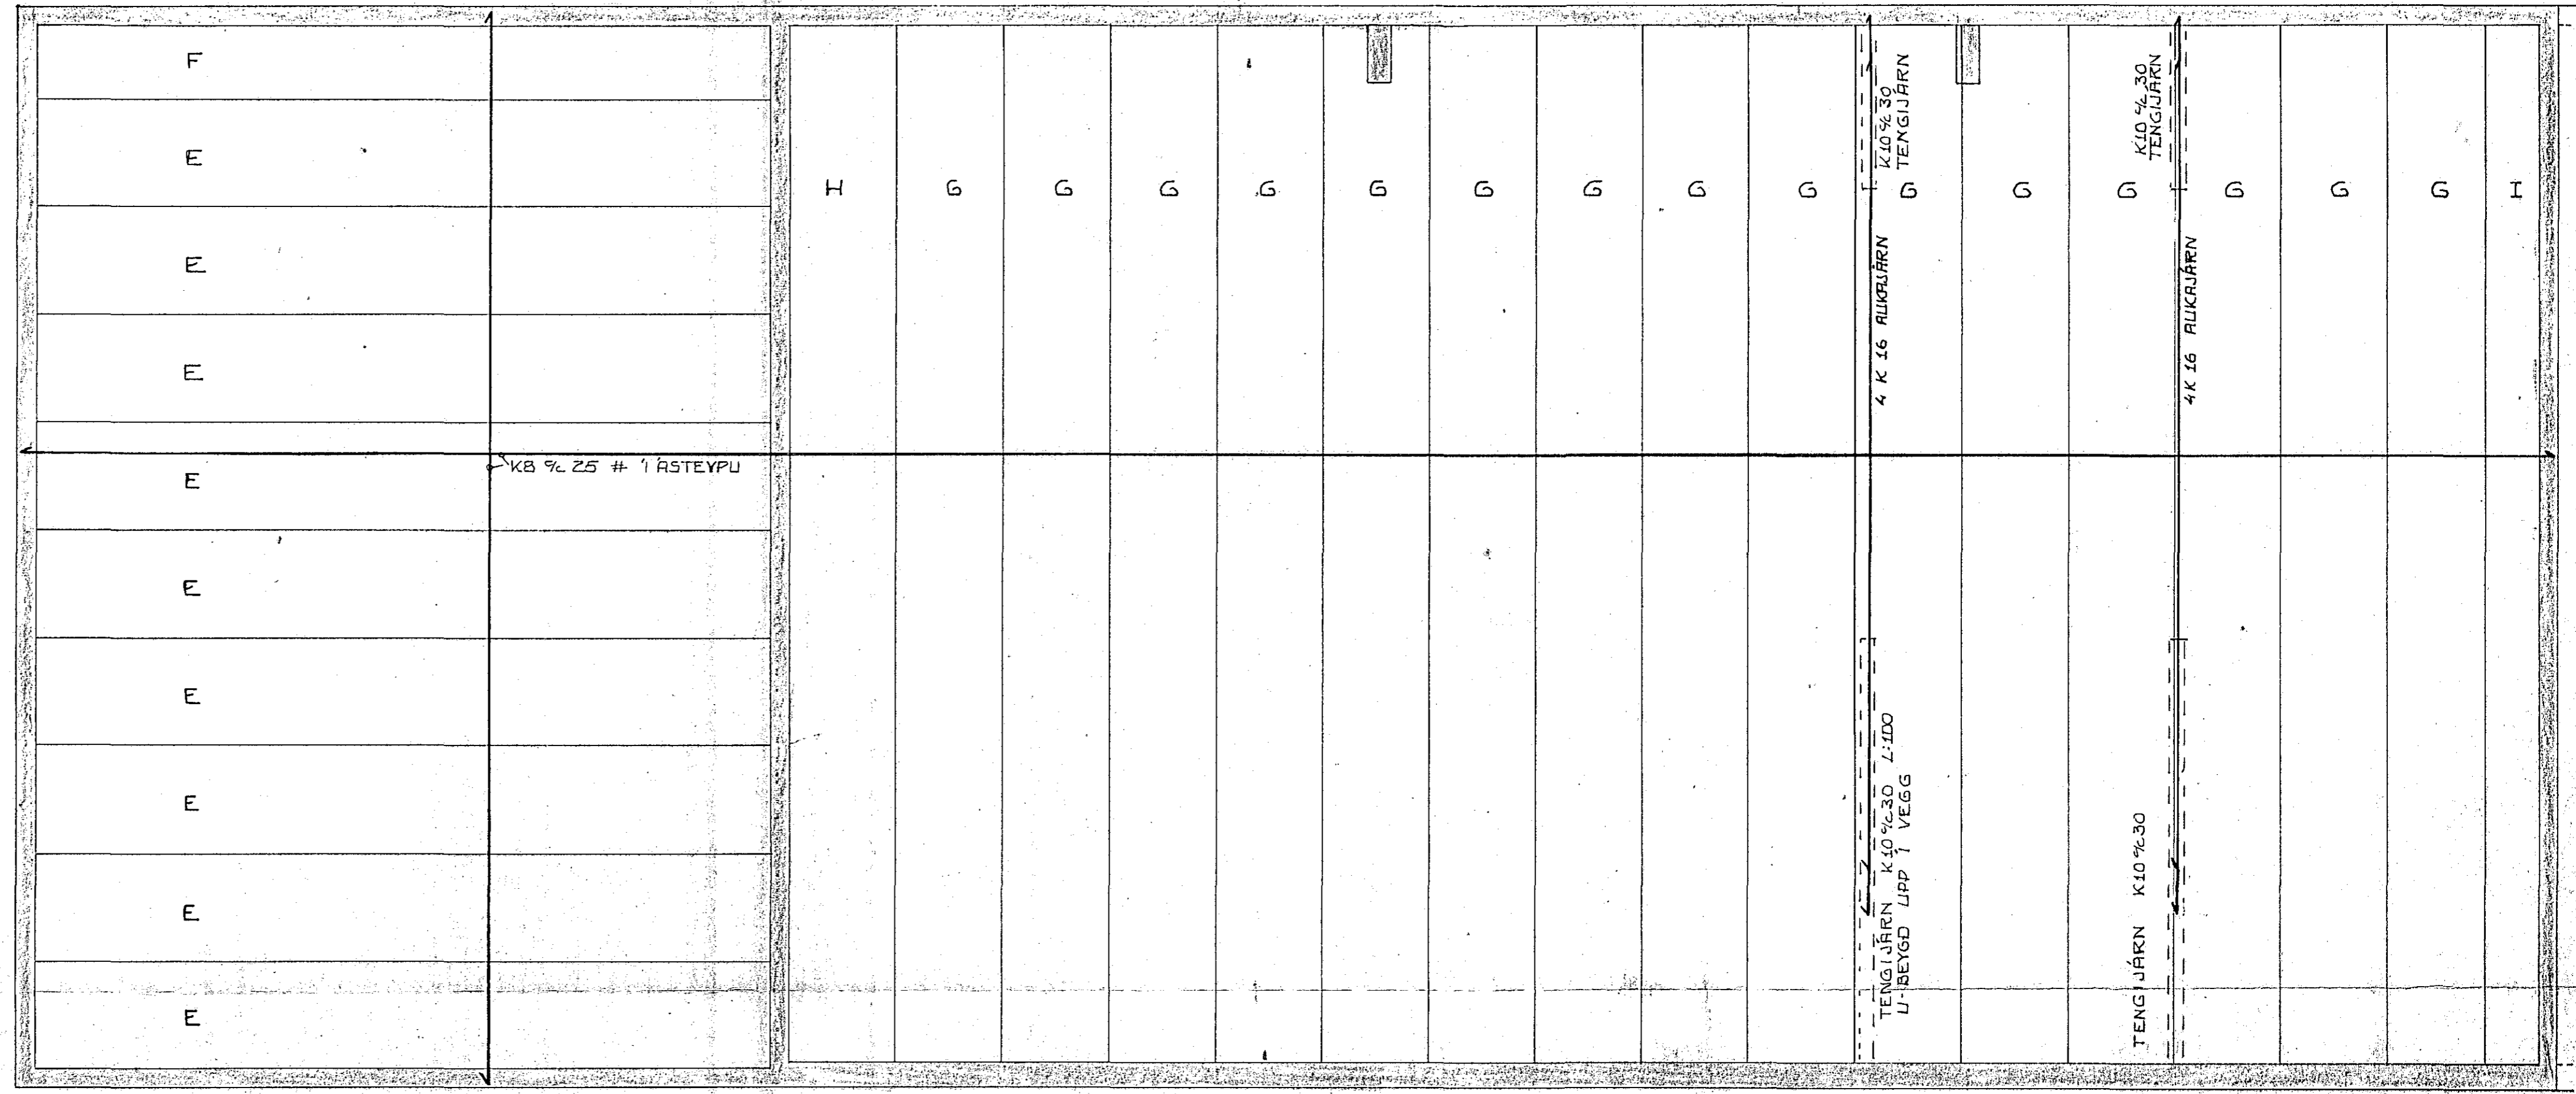
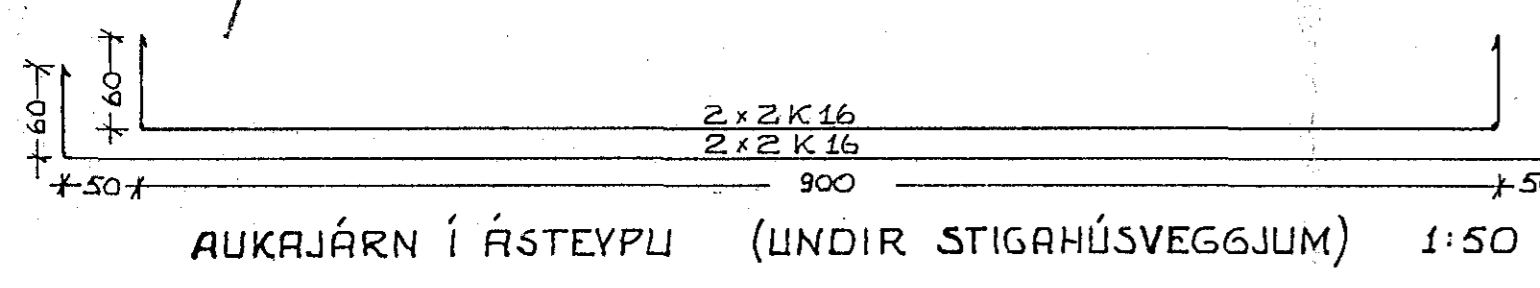
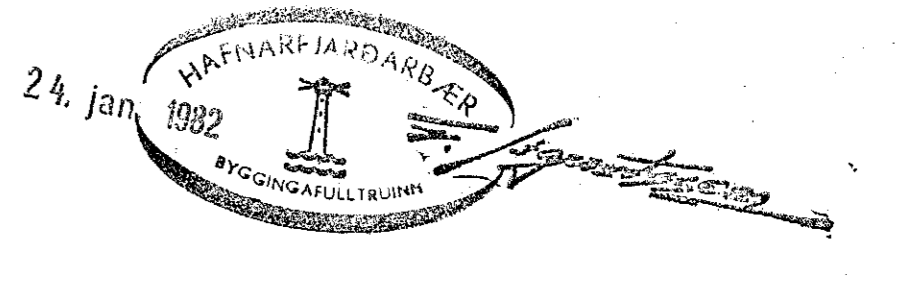
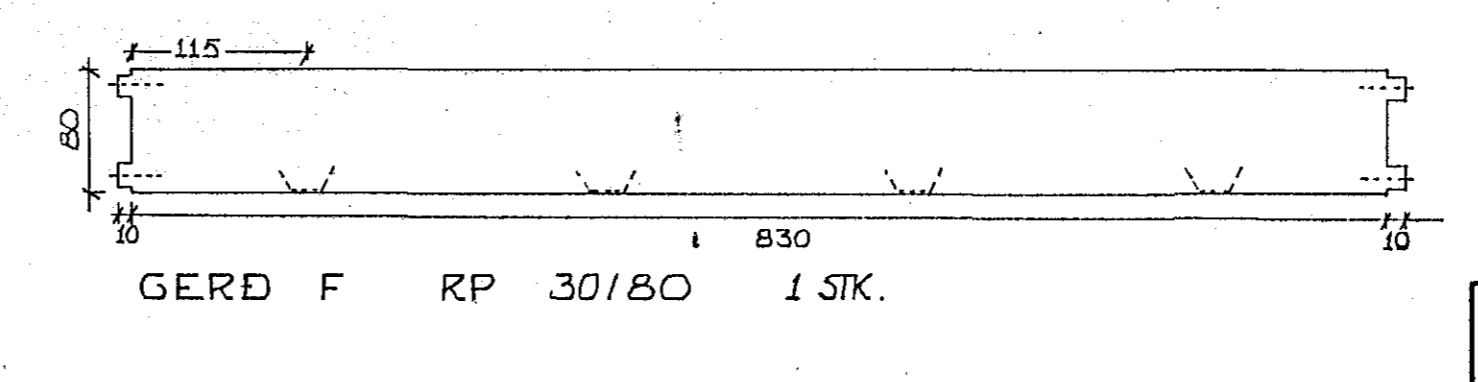
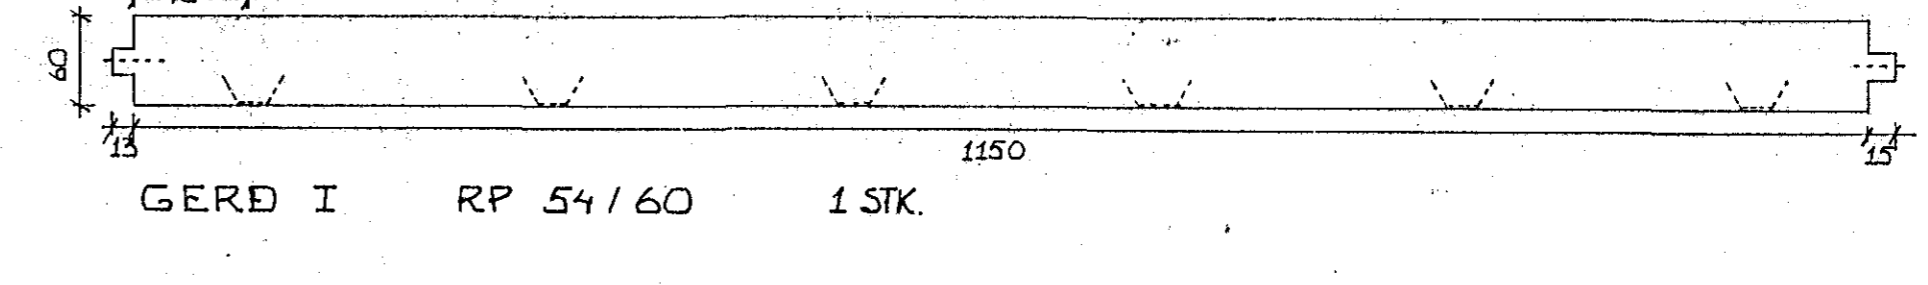
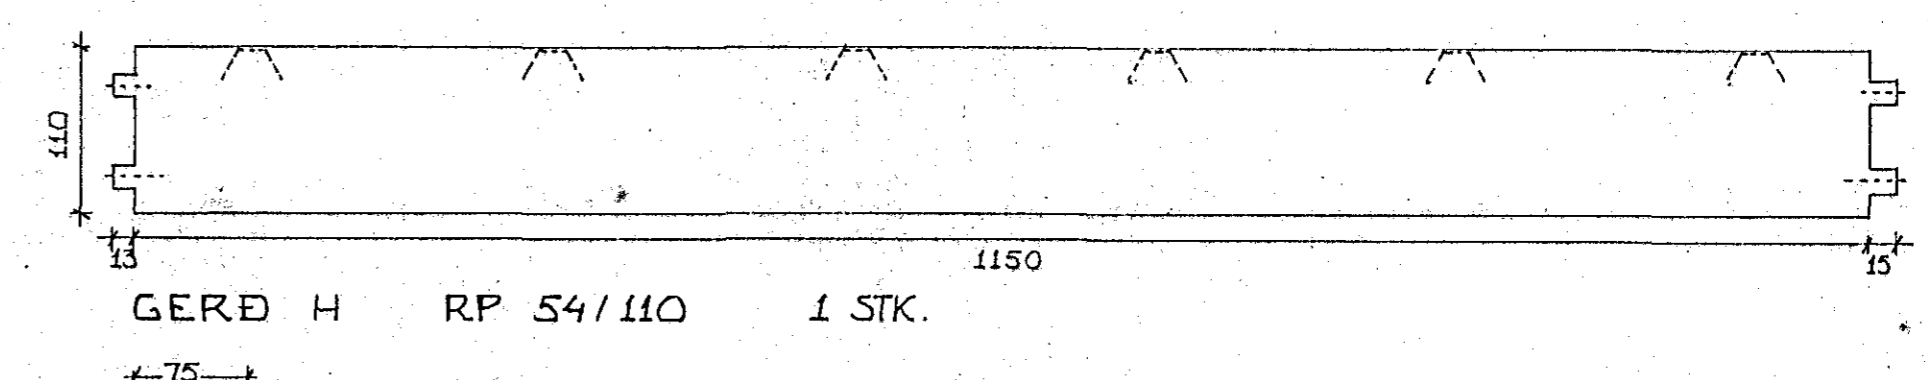
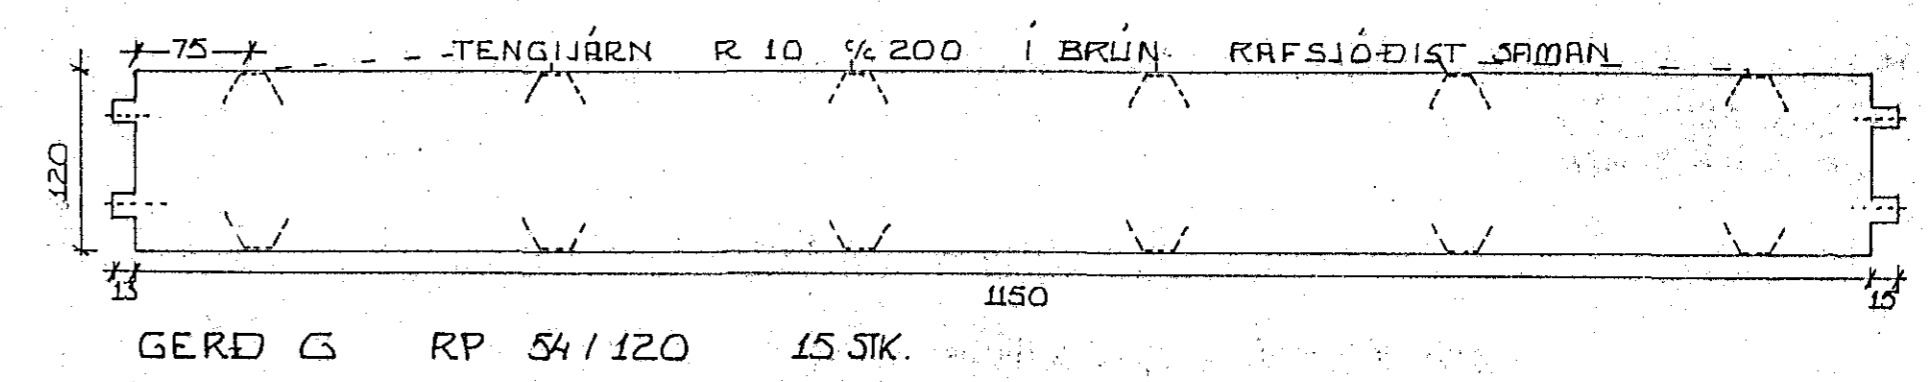
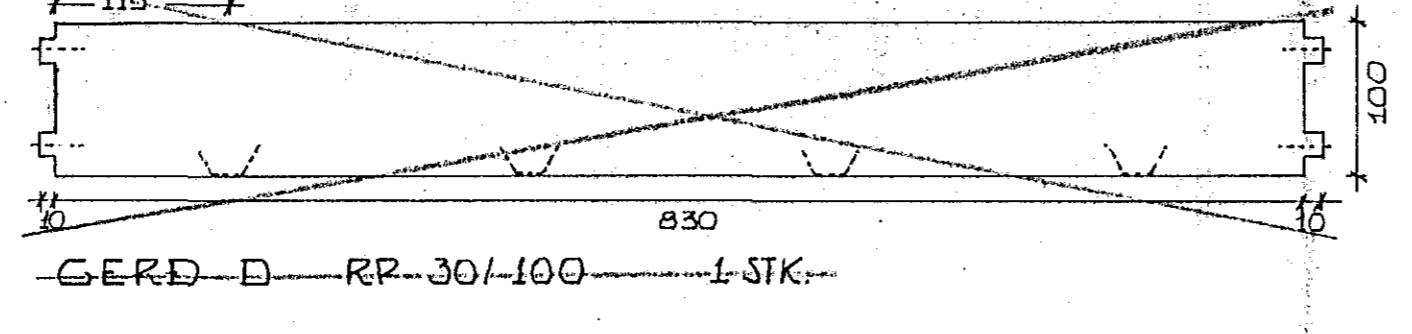
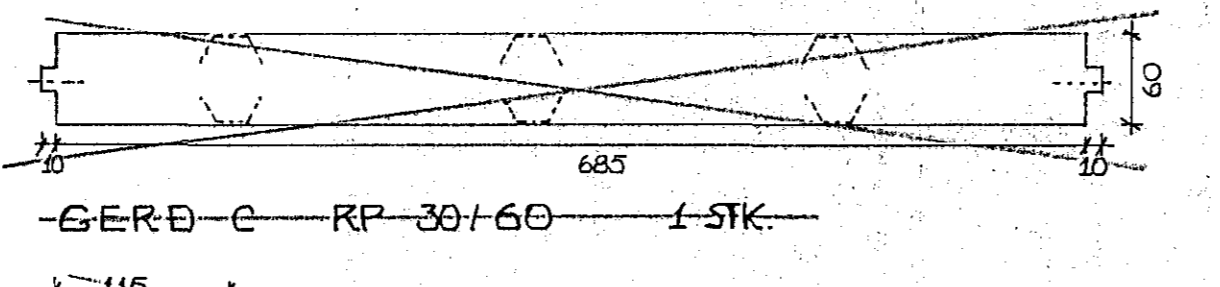


Breytt; sjá teikn 1.8 D.V.

RIFJAPLÖTUR Í GÓLF 1. HÆÐAR
NOTÁLAG 300 KG/M²
GRUNNMÝND 1:50

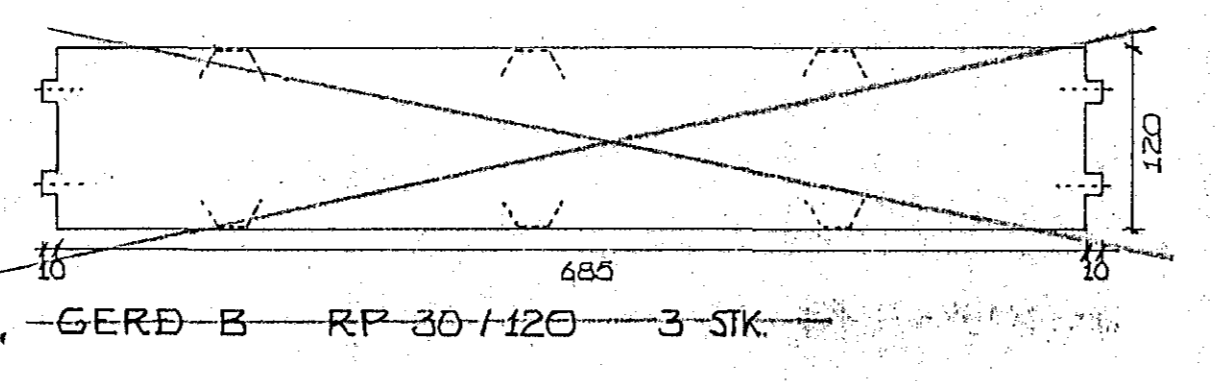

RIFJAPLÖTUR Í GÓLF 1. HÆÐAR NOTÁLAG 300 KG/M² GRUNNMÝND 1:50

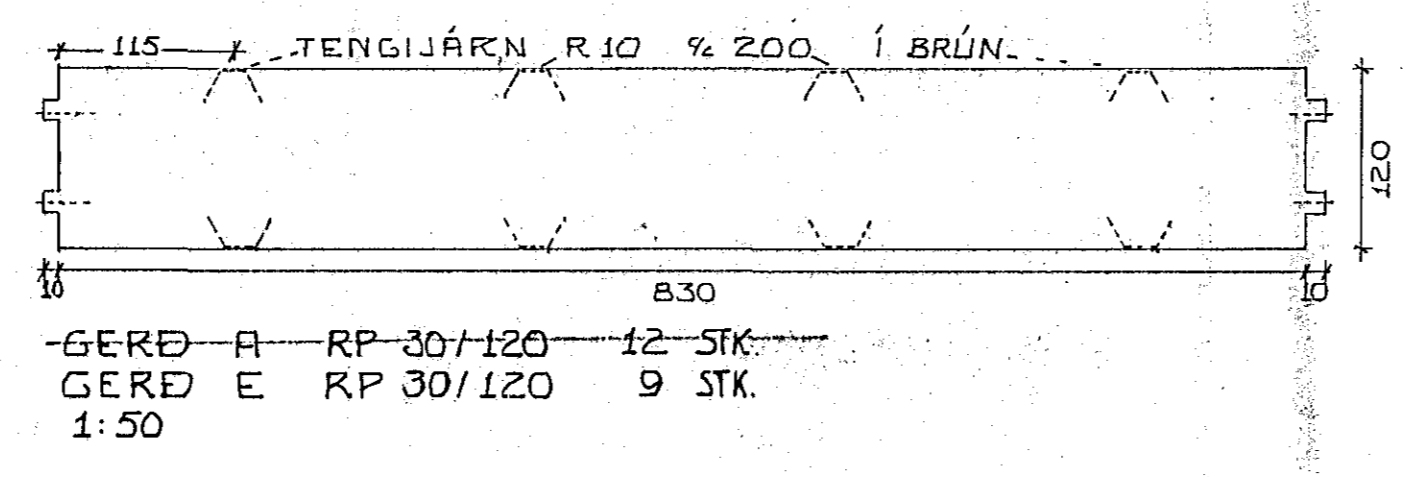

SKÚTAHRAUN 2, HAFNARFIRÐI	MÆLIKVARDI 1:50	VERK 8016	TEIKN NÚ 17
RIFJAPLÖTUR OG ÁSTEYPUBENDING MILLIGÓLF OG GÓLF 1. HÆÐAR	Hannað: Teiknað:	Virtarís: Samþ:	DAGS JAN '81
JÓHANN GUNNAR BERGÞÓRSSON VERKFR MVI	DREYTT		
STRANDGÖTU 11 - HAFNARFIRÐI - Sími 63315			