




PVERSNID Í GRYFJU 1:10

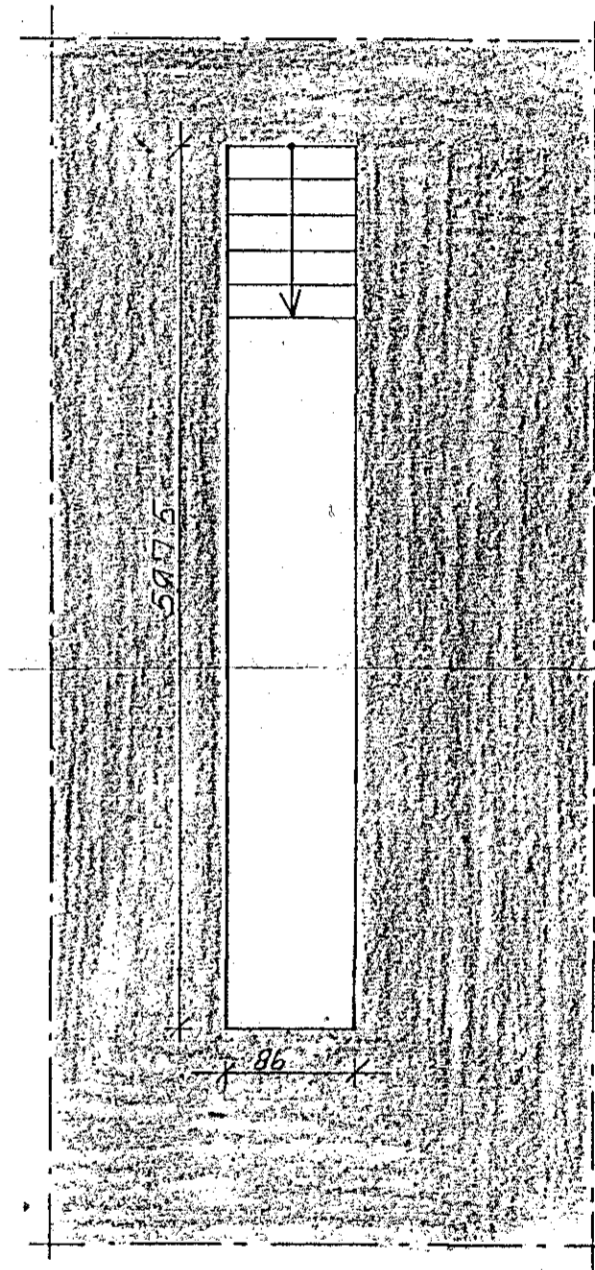

GRUNNMYND 1:50

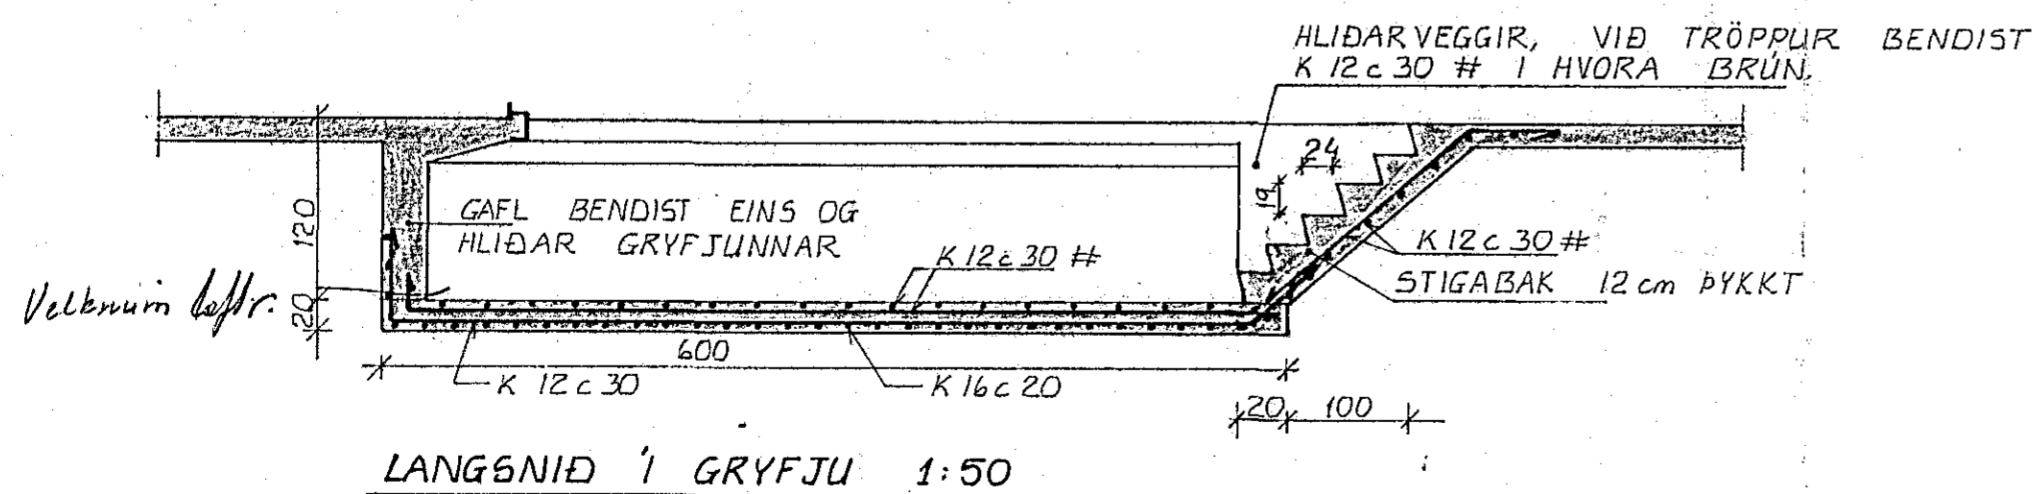

LANGSNID Í GRYFJU 1:50

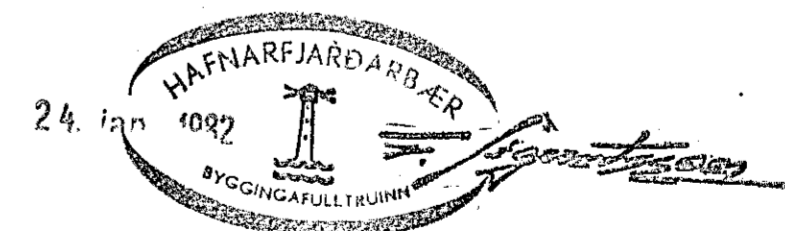

SKÚTAHRAUN 2, HAFNARF.	MÆLIKVARDI 1:10 1:50	VERK 8016	TEIKN NR 1.12.
SMLIRGRYFJA	Hannað: D.V. Teiknað: B.Z.	Yfirfarið: D.V. Samb:	DAGS OKT. '81
JÓHANN GUNNAR BERGÞÓRSSON VERKFR MVFI STRANDGÖTU 11 — HAFNARFIRÐI — Sími 53315	BREYTT		