




GÓLFBITAR 1:50

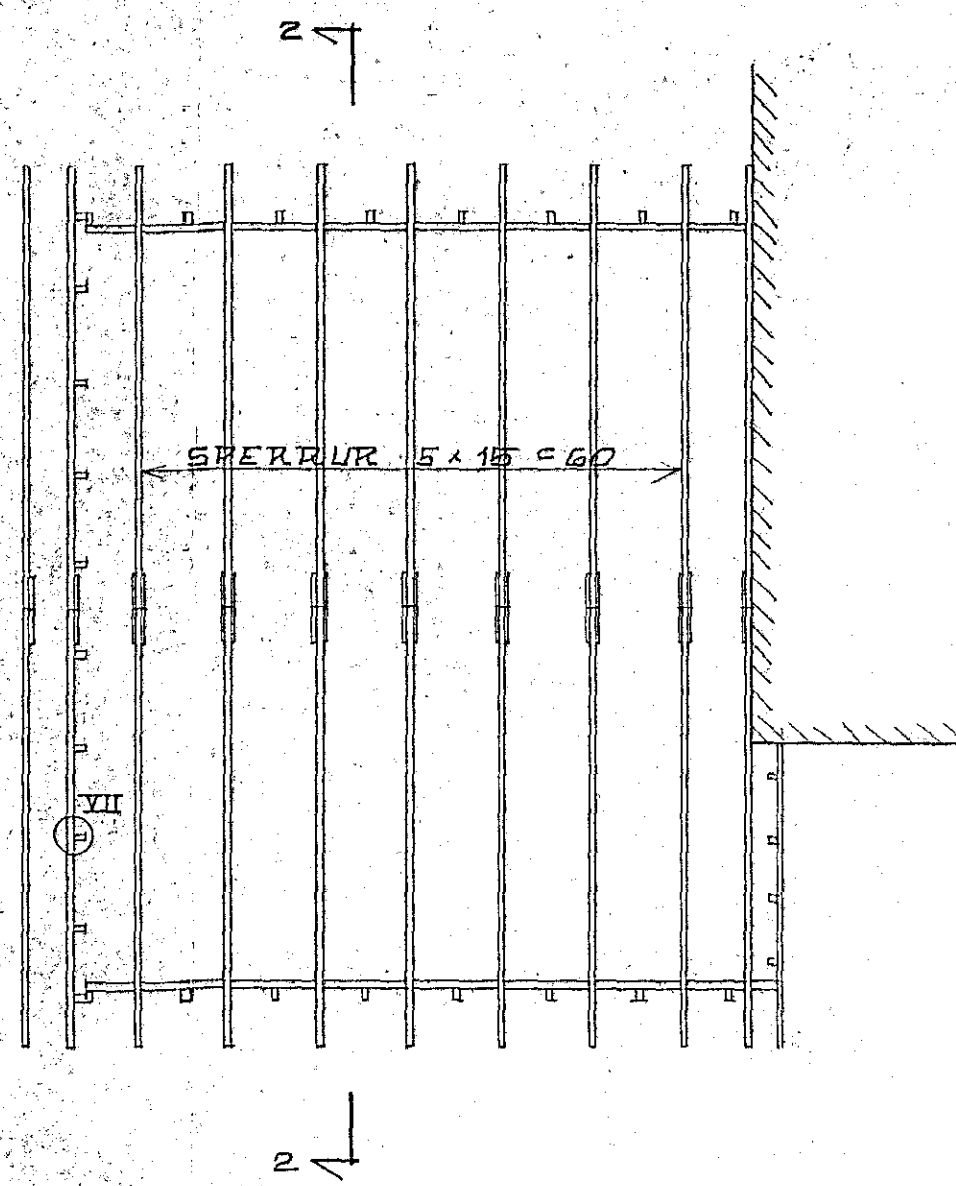


SPERRUR 1:50

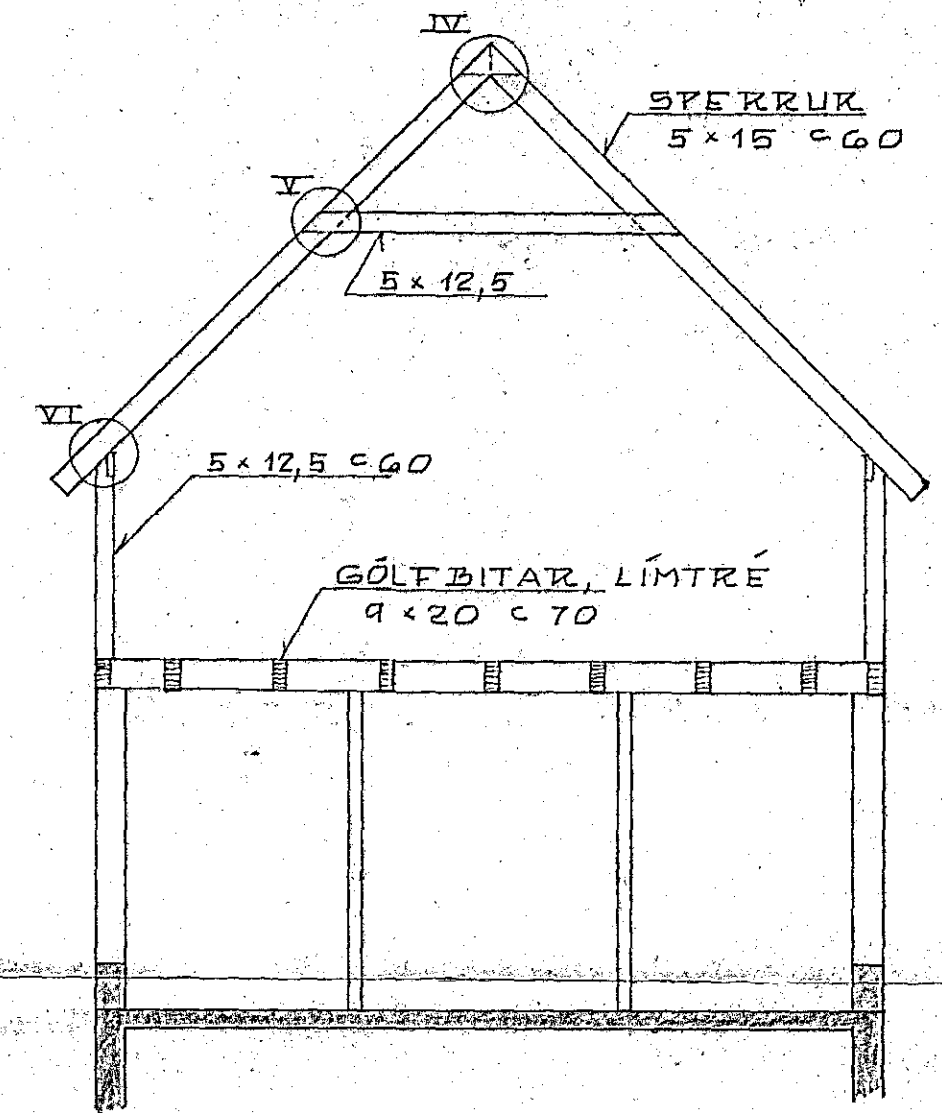

SNIED 2-2 1:50

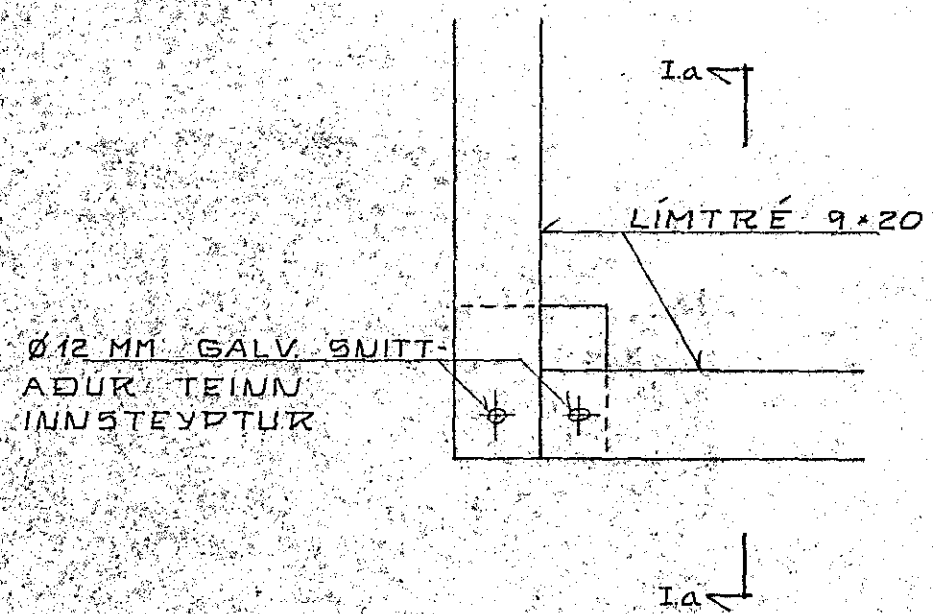


SÉRMYND I 1:10

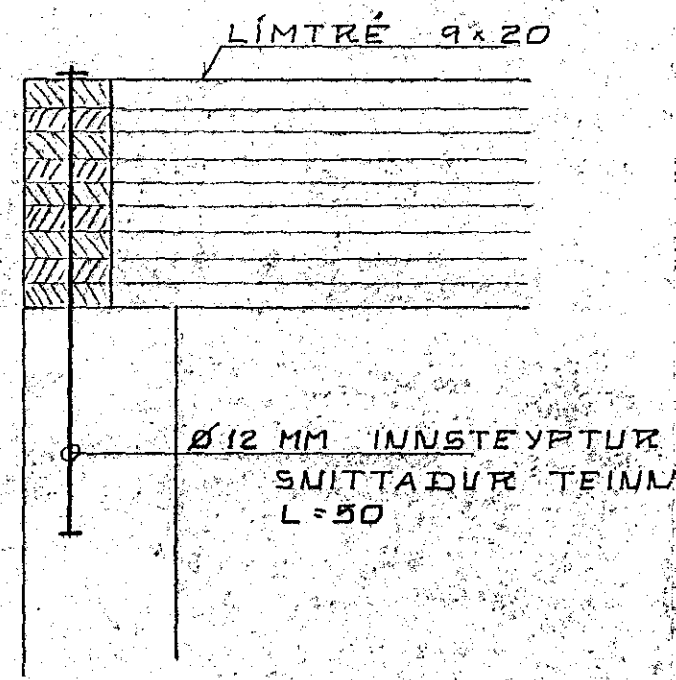

SNIED Ia-Ia 1:10

ÓNEFND MÁL ERU CM
SÉRMYNDIR SJÁ BL. NR. 3

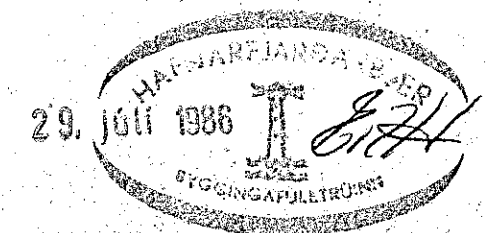

KRISTJÁN KNÚTSSON
TÆKNIFRÆÐINGUR EFTI S. 651647

LANGEYRARVEGUR, 12 HF	DAGS MARS '86
VIÐBYGGING	MKV 1:50/1:10
GÓLFBITAR OG SPERRUR	BL 2 AF
	VERK. 861-01

BREYTING: JÚNÍ '86, LÍMTRÉ; K.K.

BURÐARVIRKI.