


1x63A heimtaug
40mm pípa.
Mogul utilýsing
32mm.
Inntök loftnet.
og síma 32mm.

neðri hæð

Húsvita nr. 2937 Teikning nr. 2207
Samþykkt þ. 4-11 1983
f.h. RAUFVEITU HAFNARFJARÐAR
Jens Þorbjörn
Eftirlitsmaður rafhlagna

Tafla lengist fyrir 220V
Inntök samþykki 4.11.1983
f.h. RAUFVEITU HAFNARFJARÐAR
Alfred Kristjánsson

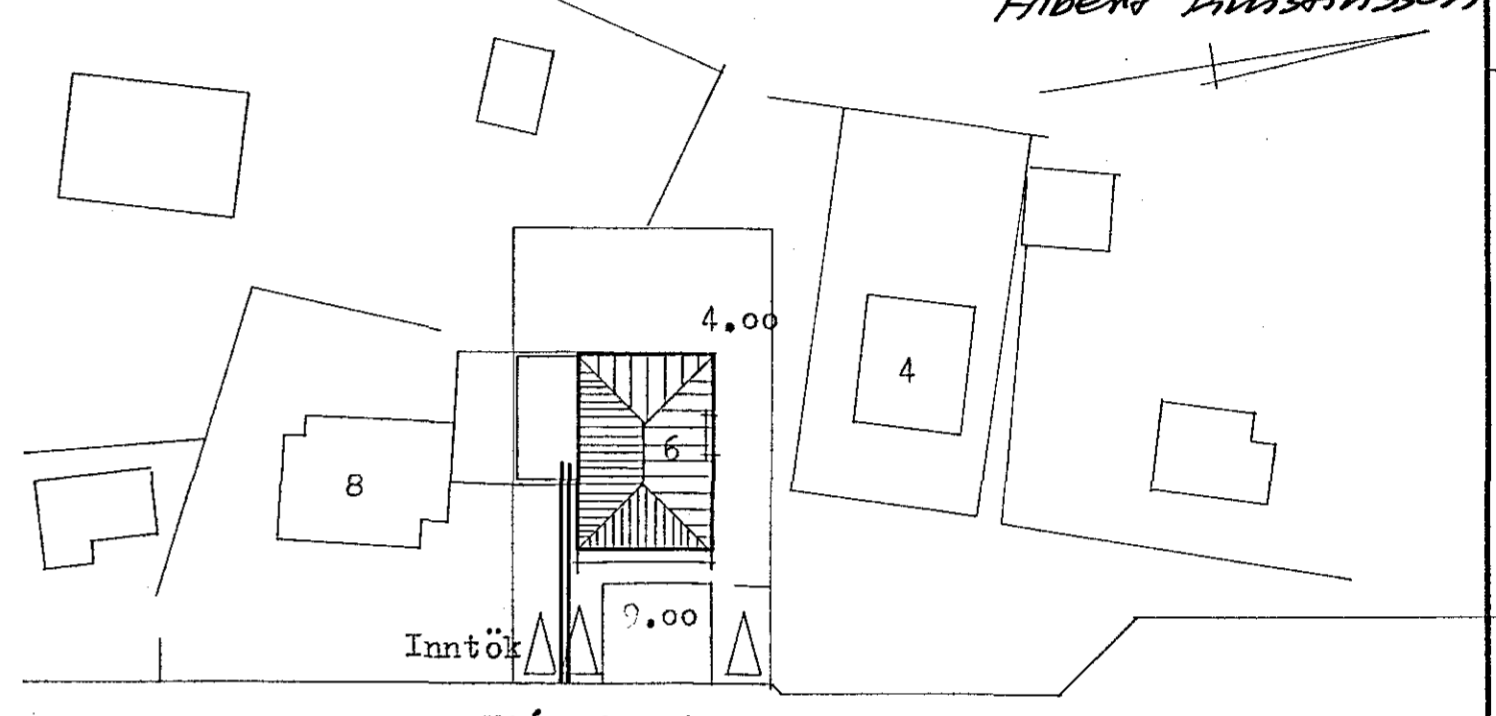

afstöðumynd

2207



TEIKNISTOFAN RÖDULL
ARMÚLA 36 - 105 REYKJAVÍK - SÍMI 27790

Hlíðarbraut 6 Hafnarfirði

RAFLAGNIR

| | |
|------------------|-------------------|
| TEIKN.: SG | DAGS.: Okt. '82 |
| REIKN.: Ásgr. | VERK: 82061 |
| YFIRF.: | BLAD: 4.01 |
| MKV: 1:50, 1:100 | Ásgrímur Jónasson |
| | Ásgr. Jónasson |