

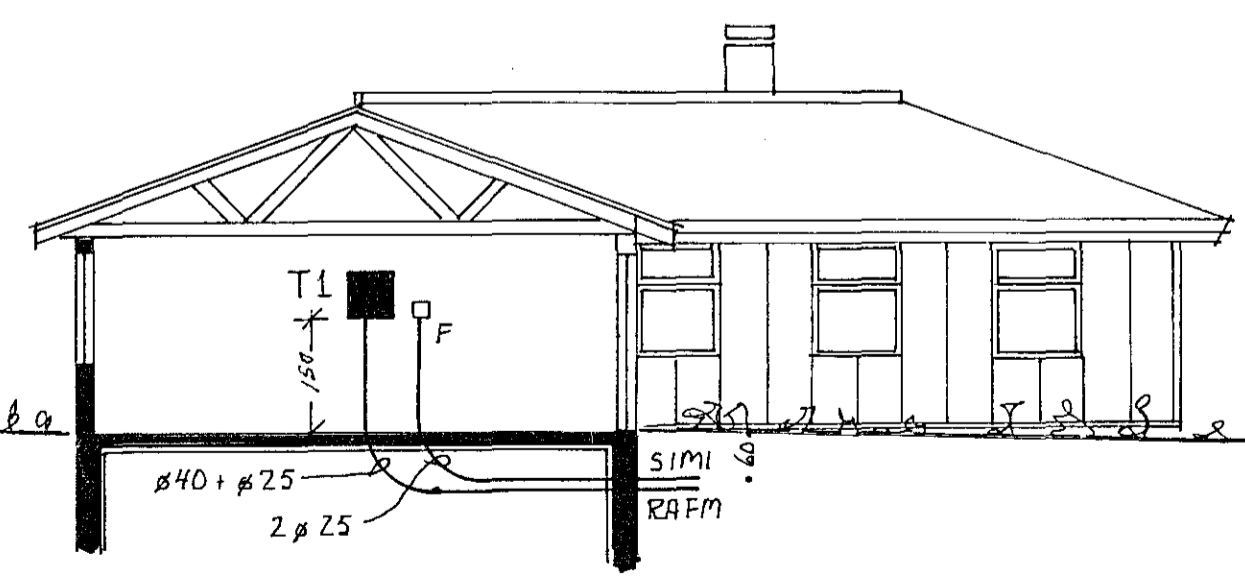


Húsvéita nr. 2966 Teikning nr. 2237
 Samþykkt þ. 22. 2. 1984
 f. h. RAUVEITU HAFNARFJÁRDAR
Jens Guðsson
 Eftirlitsmaður rafiagna

unntá teikning 22.12. 1984
 f. h. RAUVEITU HAFNARFJÁRDAR
Albert Þrastarsson

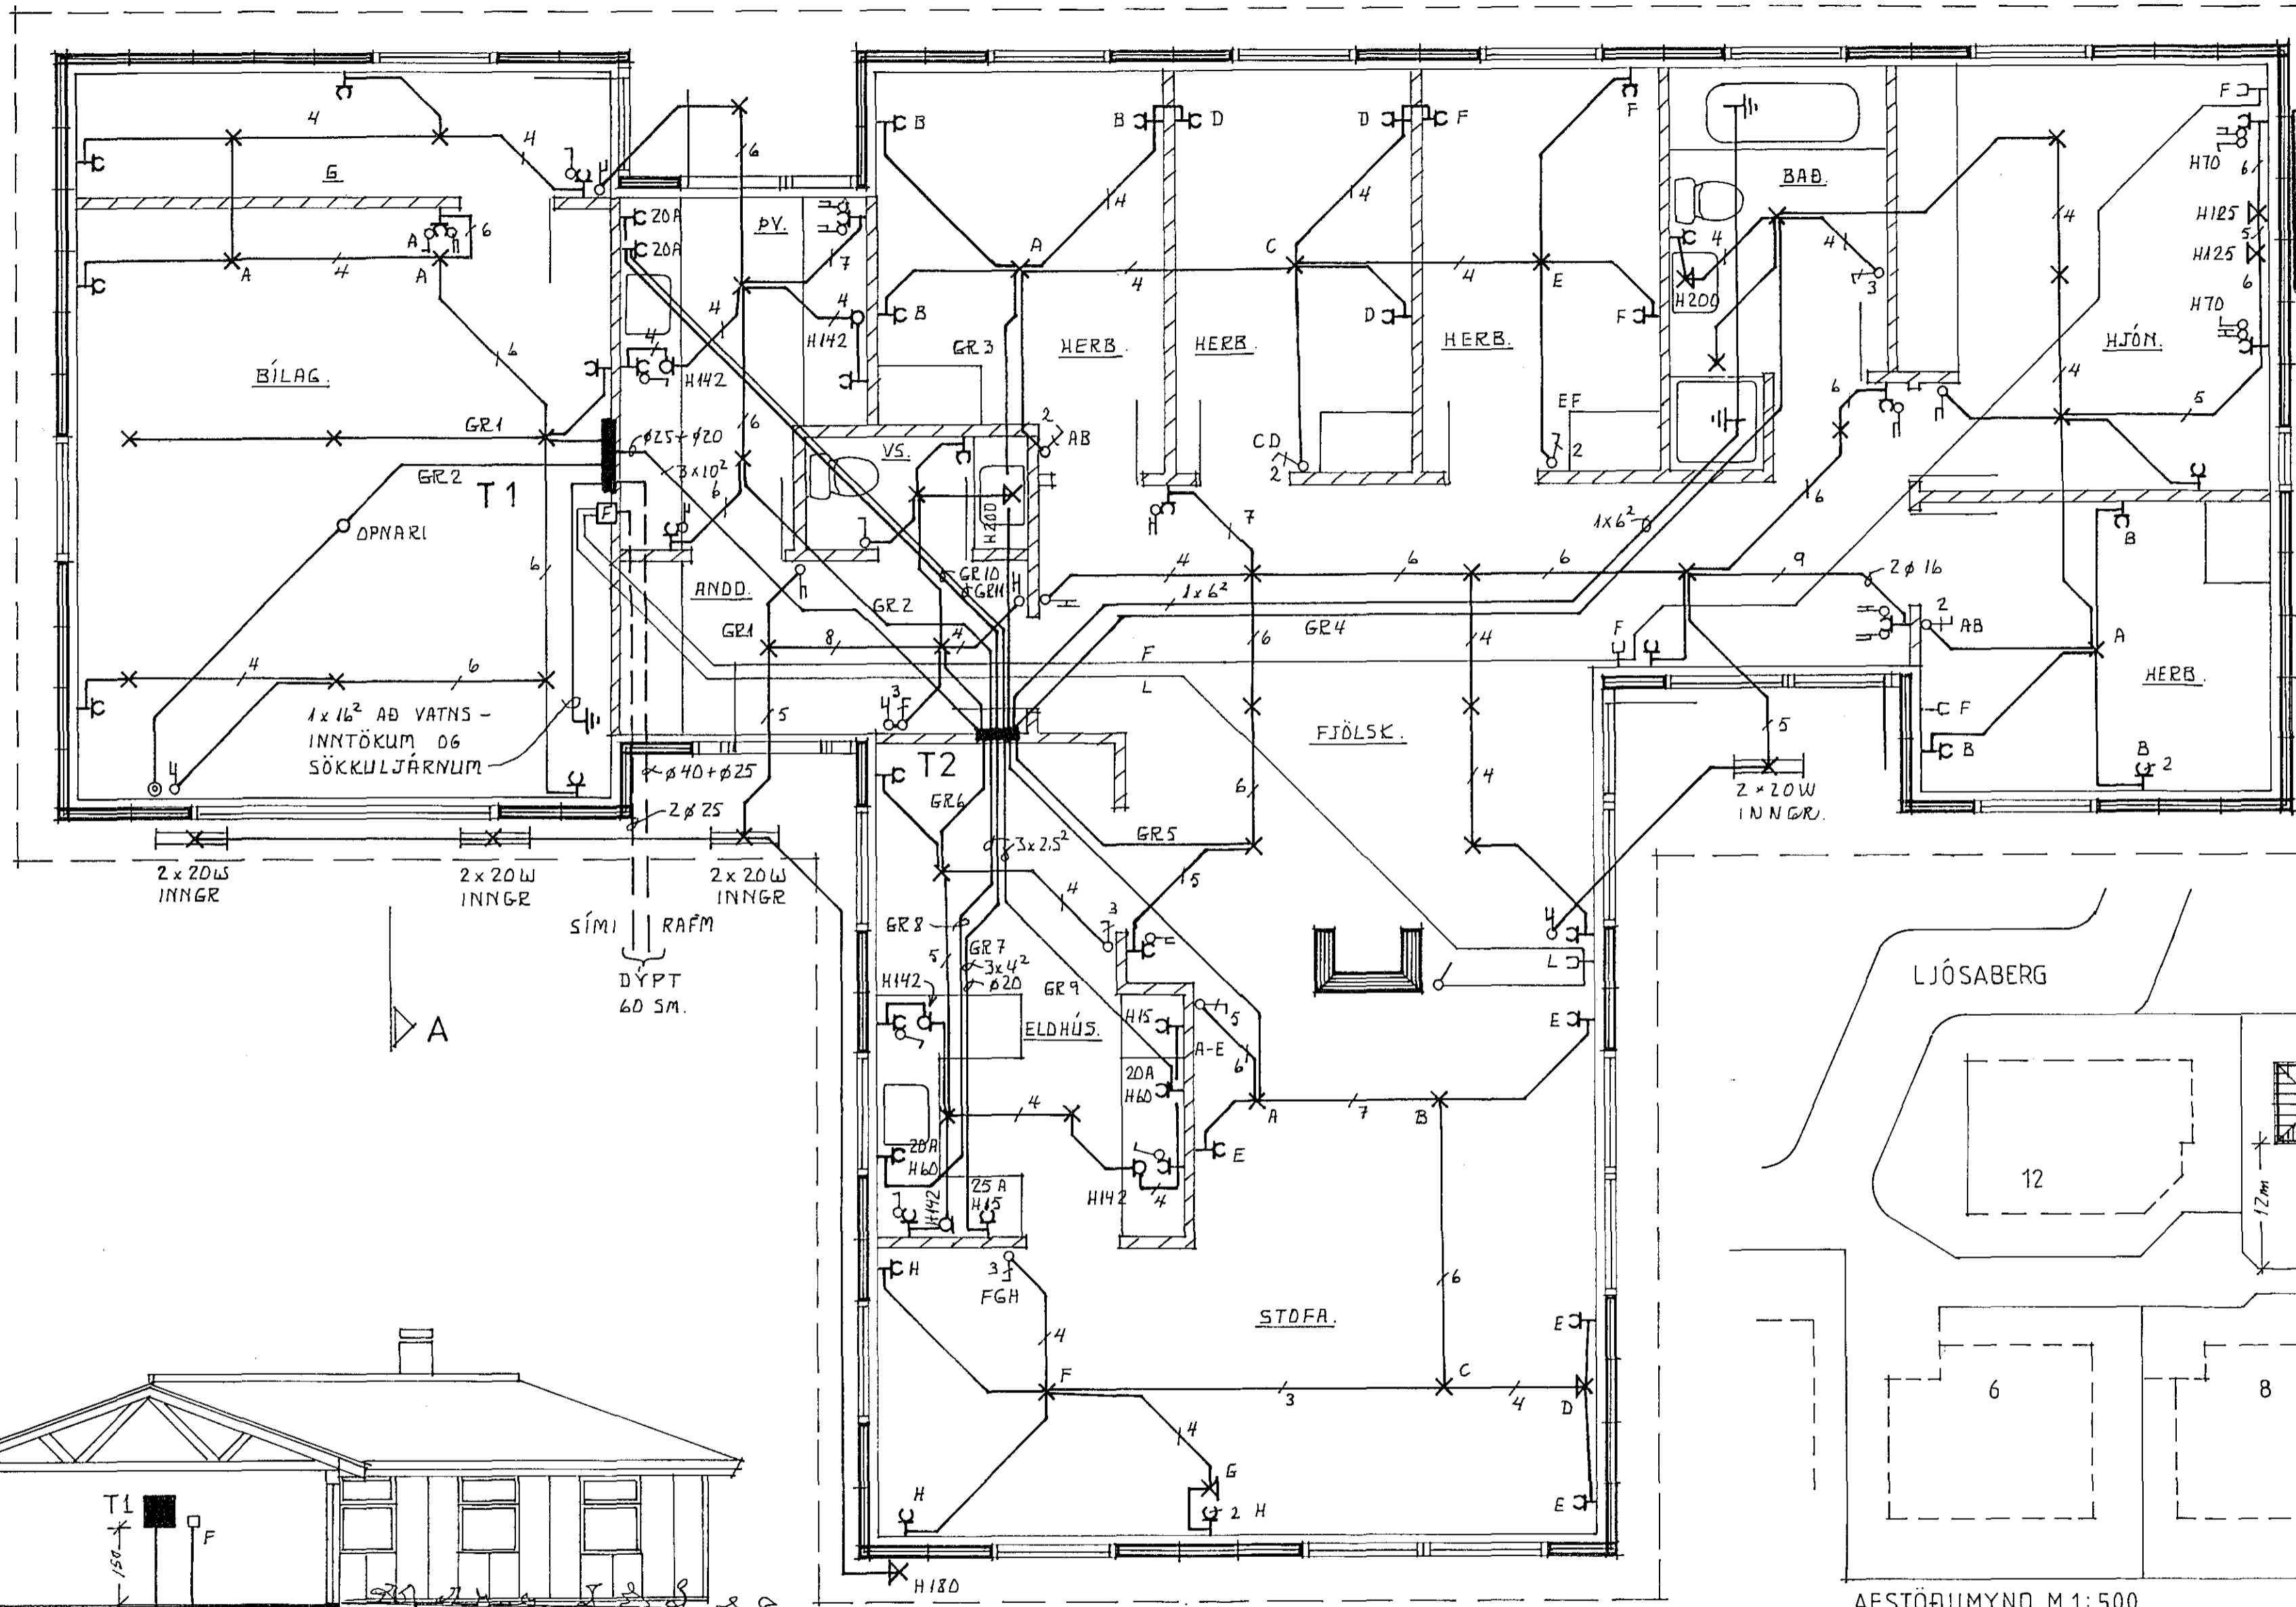

SNEIBING A 1:100

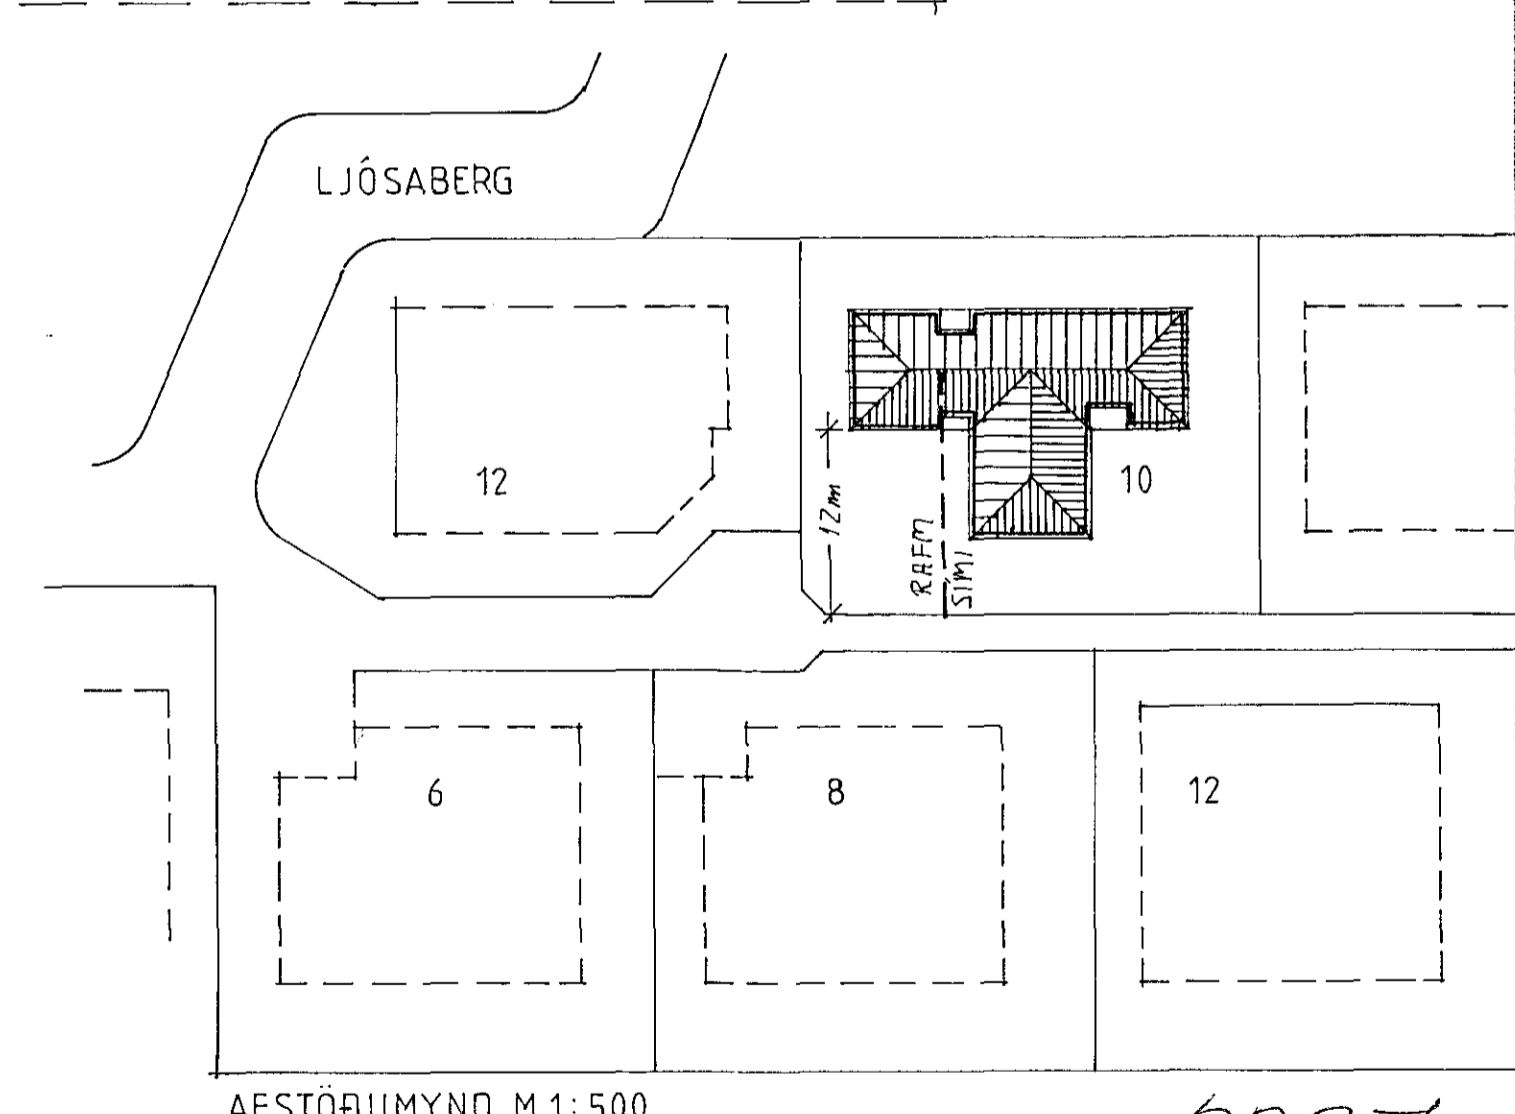

AFSTÖÐUMYND M 1:500

2237

LJÓSTÆKNI <small>Teiknistofa Skúlagotu 63 Reykjavík, sími 14041 Magnús Sigurðsson teknifræðingur ffr</small>	LJÓSABERG 10, HAFNARFIRÐI.	
	RAFLÖGN GRUNNMYND M 1:100	VERK NR. 735 LT 1128 BLAD 1 AF 2 23. 10. <i>Mbj</i>