



Einlinamynd.

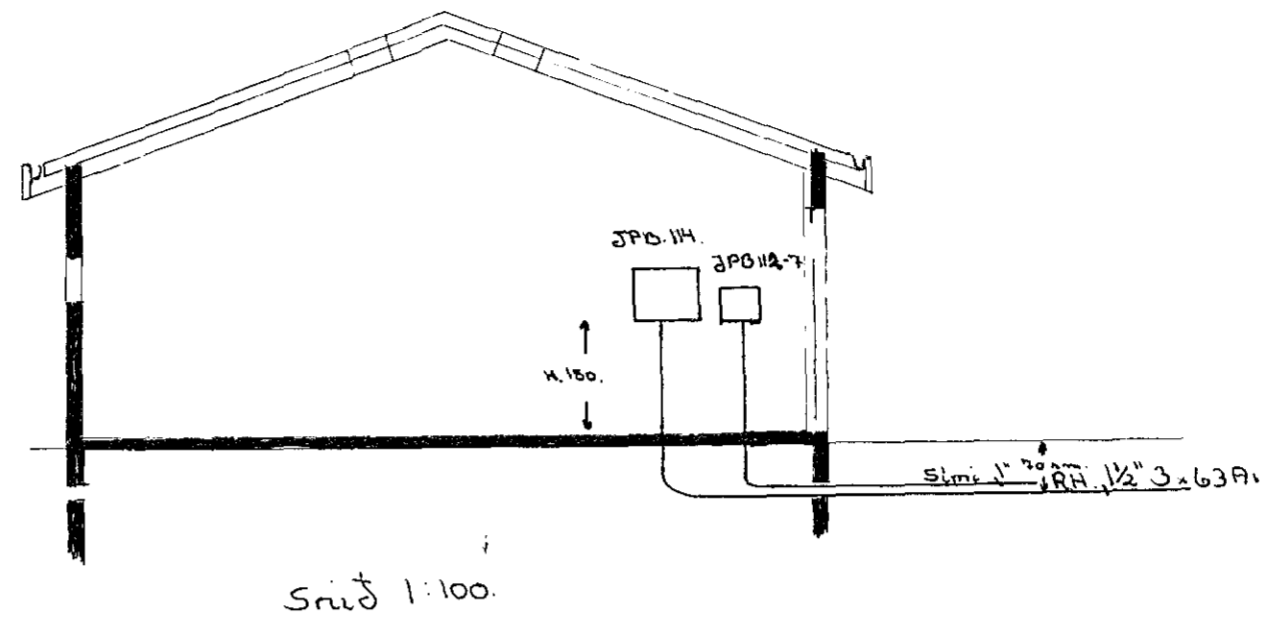

Húsnúmer nr. 3037 Teikning nr. 2309
 Samþykkt þ. 31-7 1984
 f.h. RAUFVEITU HAFNARFJÁRDAR
Jens Einarsson
 Eftirlitamaður raflegna

Lestök samþykkt 31.7. 1984
 f.h. RAUFVEITU HAFNARFJÁRDAR
Filbert Adrastínsson

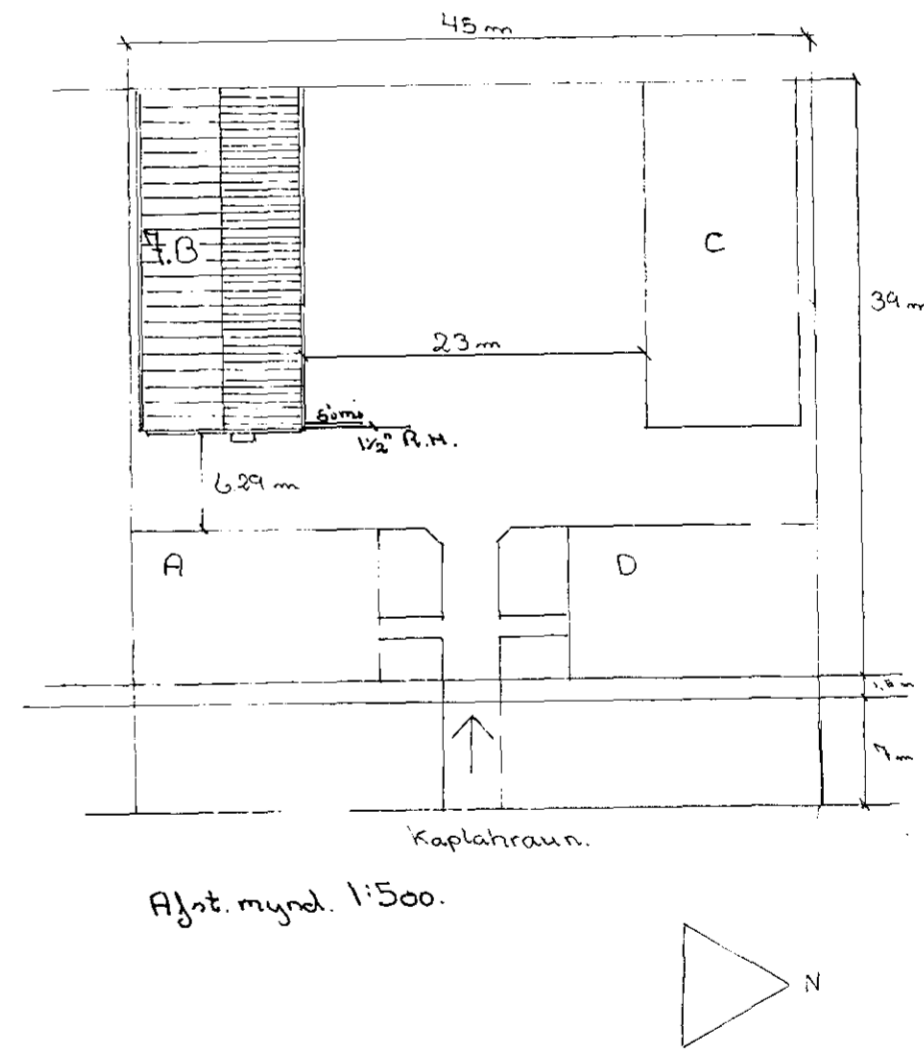

2309

Luther Einarsson.	Kapláhraun 7.B.
Samþ.	Einlinamynd. Snúðamynd. Afst. mynd.
Mkv: 1:100, 1:500.	
Bláð 2 af 2.	