


Hásvæito nr. 3103 Tölkning nr. 2362
 Samþykkt þ. 27. 2 1983
 Í.H. RABVEIU HAFNARFJARÐAR
Jens Guðlaugsson
 Eltíttisráðgjafi

19.8. 1984
 F.K.

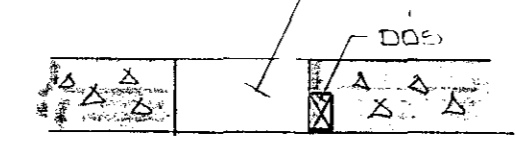

TEIKNAD SAMKVEMT UPPLÝSINGUM
 ZAFVERKTAKA

2362

HJALLABEART 15 VEITINGARSTAFUR ZAPLAGNATEIKNING HNSPEYPT ROR OG DÖSIR		HANNAD S		KVARDI 1:50	
TEIKNAD		S		DAGS. AGUST 83	
TEIKNAR Sig. St. Óðlaugsson		YFIRFARIÐ NR.		BL. 1/3 AF.	