


HELLISGATA 7

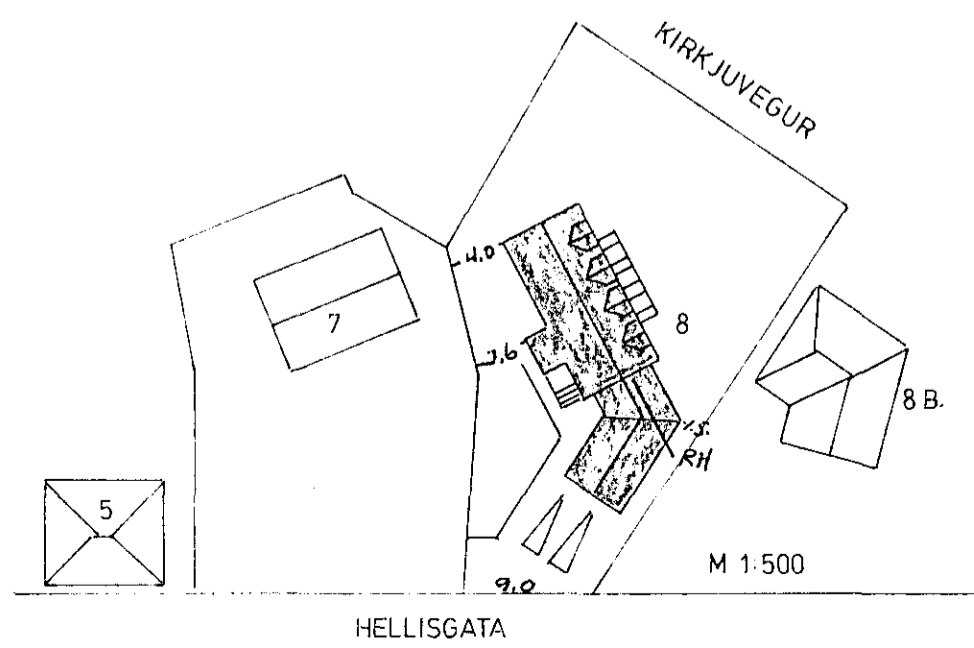

JJ RAFTEIKNINGAR DALSHRAUNI 13 HAFNARFIRDI S 651046

BREYTING	DAGS	TEIKN	SAMB
----------	------	-------	------

FROR	DAGS.	NAFN	KIRKJUVEGUR 8	KVARDI	
TEIKN	05-85	JG			
SAM					
AFSTÖÐU SNIÐ OG EINLINU MYNDIR			Nr. 102	BL 3AF3	MÁL.
			Jón Þorláksson S. 52829		