


KVISTUR

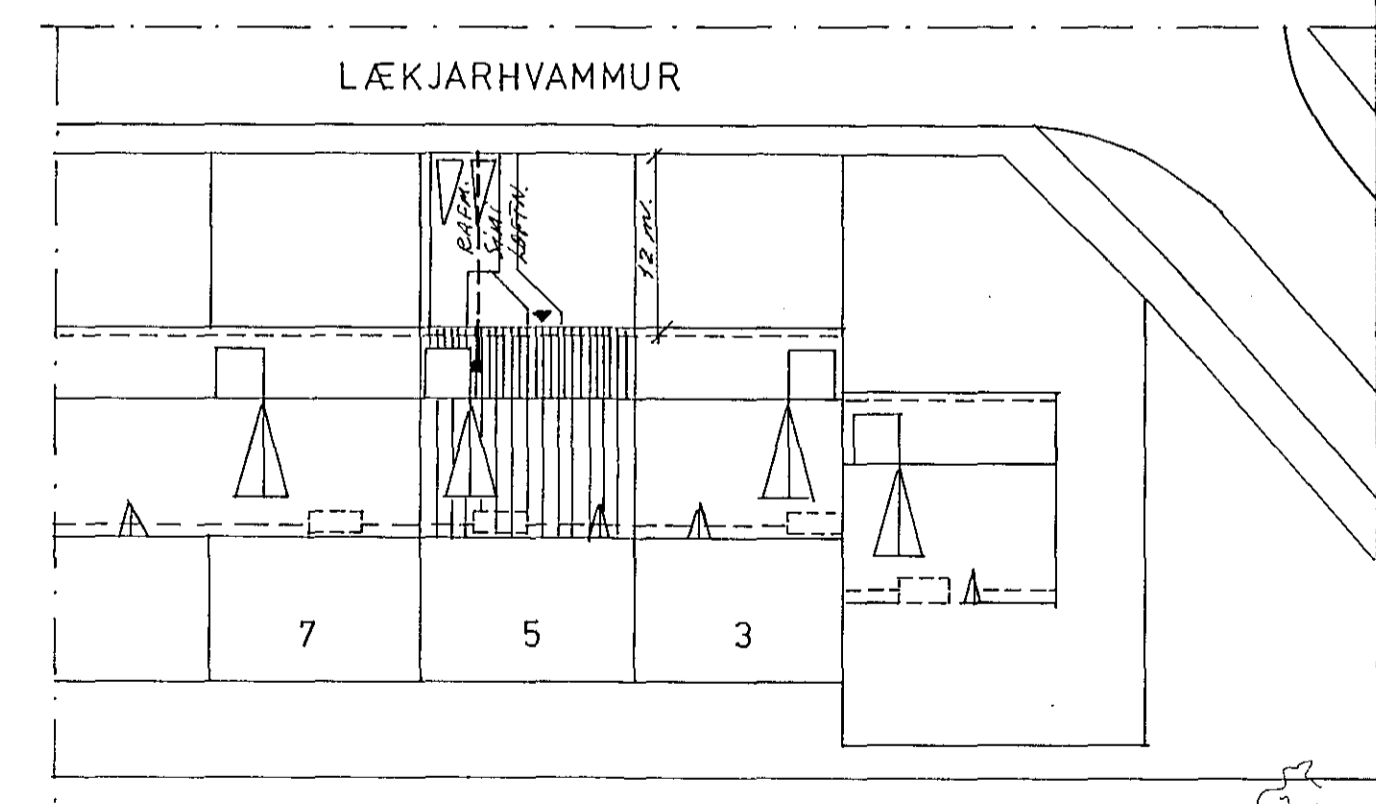

AFSTÖÐUMYND 1:500

<b>LJÓSTÆKNI</b> <small>Teiknistofa Skútagötu 63        Reykjavík, sími 14041        Magnús Sigurðsson        teknifræðingur tfti</small>	<b>LÆKJARHVAMMUR 5. HAFNARF.</b>	
	<b>RAFLÖGN</b> GRUNNMYND HÆÐAR 1:50 AFSTÖÐUMYND 1:500 KVISTUR 1:100	VERK NR. <b>LT 655</b> BLAD 2 AF 3 'AG 80 MSigurðsson