


KVISTUR 1:100

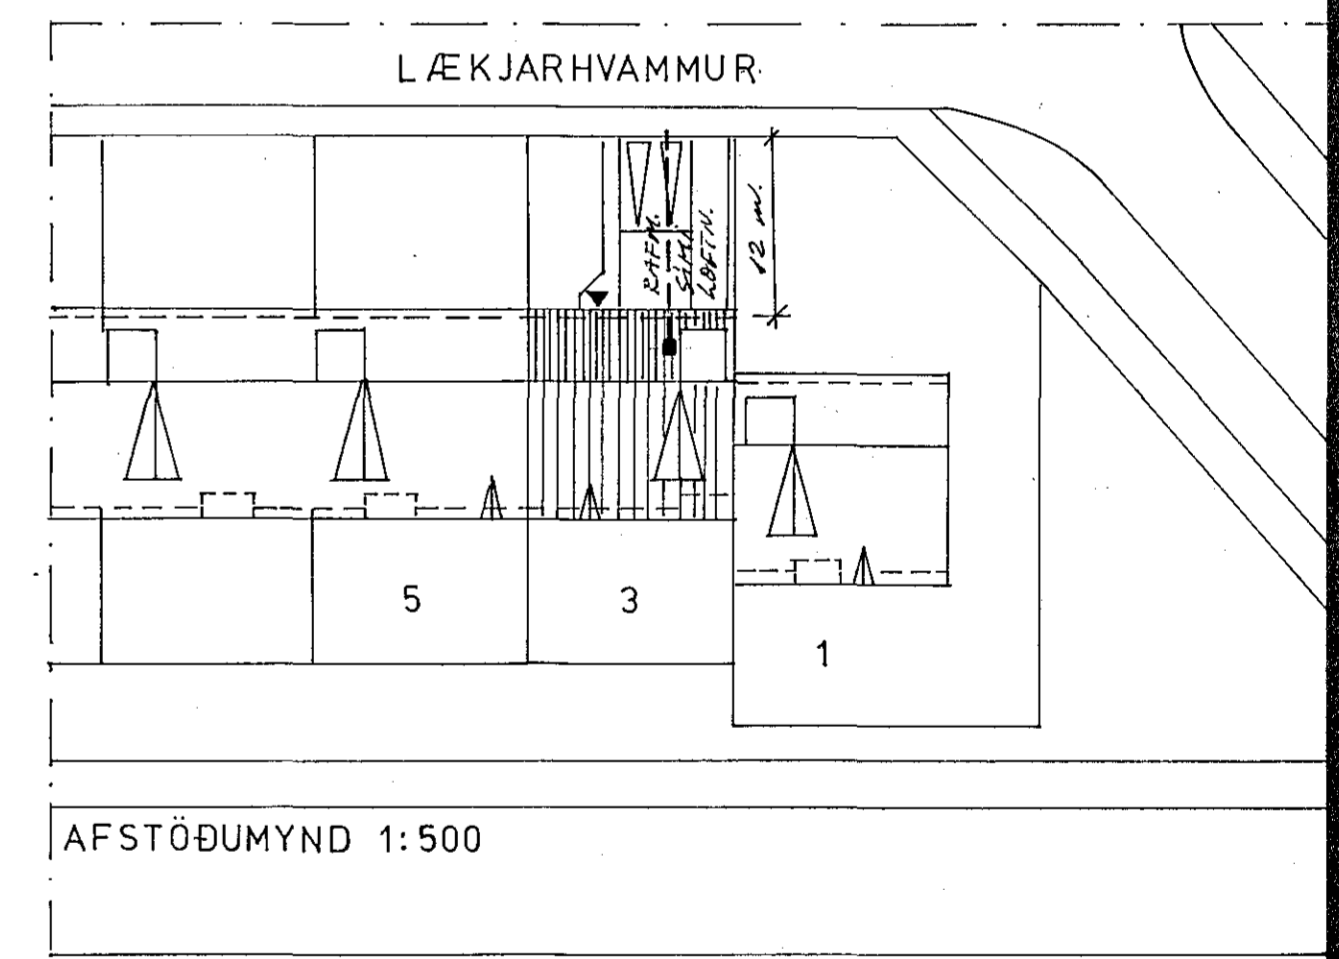

AFSTÖÐUMYND 1:500

LJÓSTÆKNI Tæknistofa Skúlagötu 63 Reykjavík, sími 14041 Magnús Sigurðsson tæknifræðingur ttfi	LÆKJARHVAMMUR 3. HAFNARF.	
	RAFLÖGN GRUNNMYND HÆÐAR 1:50 AFSTÖÐUMYND 1:500 KVISTUR 1:100	VERK NR. 653 BLAD 2 AF 3, JÚLÍ 80 M. Sigurðsson