



F  
E  
D  
C  
B  
A

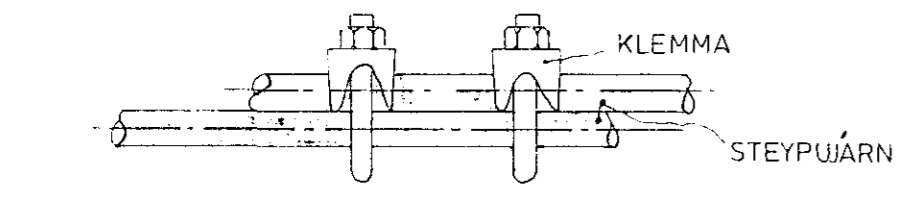

SAMTENG NEDSTU SOKKULJÄRNA  
ALLAN ÚTHRING SOKKULS

ATH Í STAD KLEMMI MÁ RAFSJÓÐA  
STEYPUJARN SAMAN.

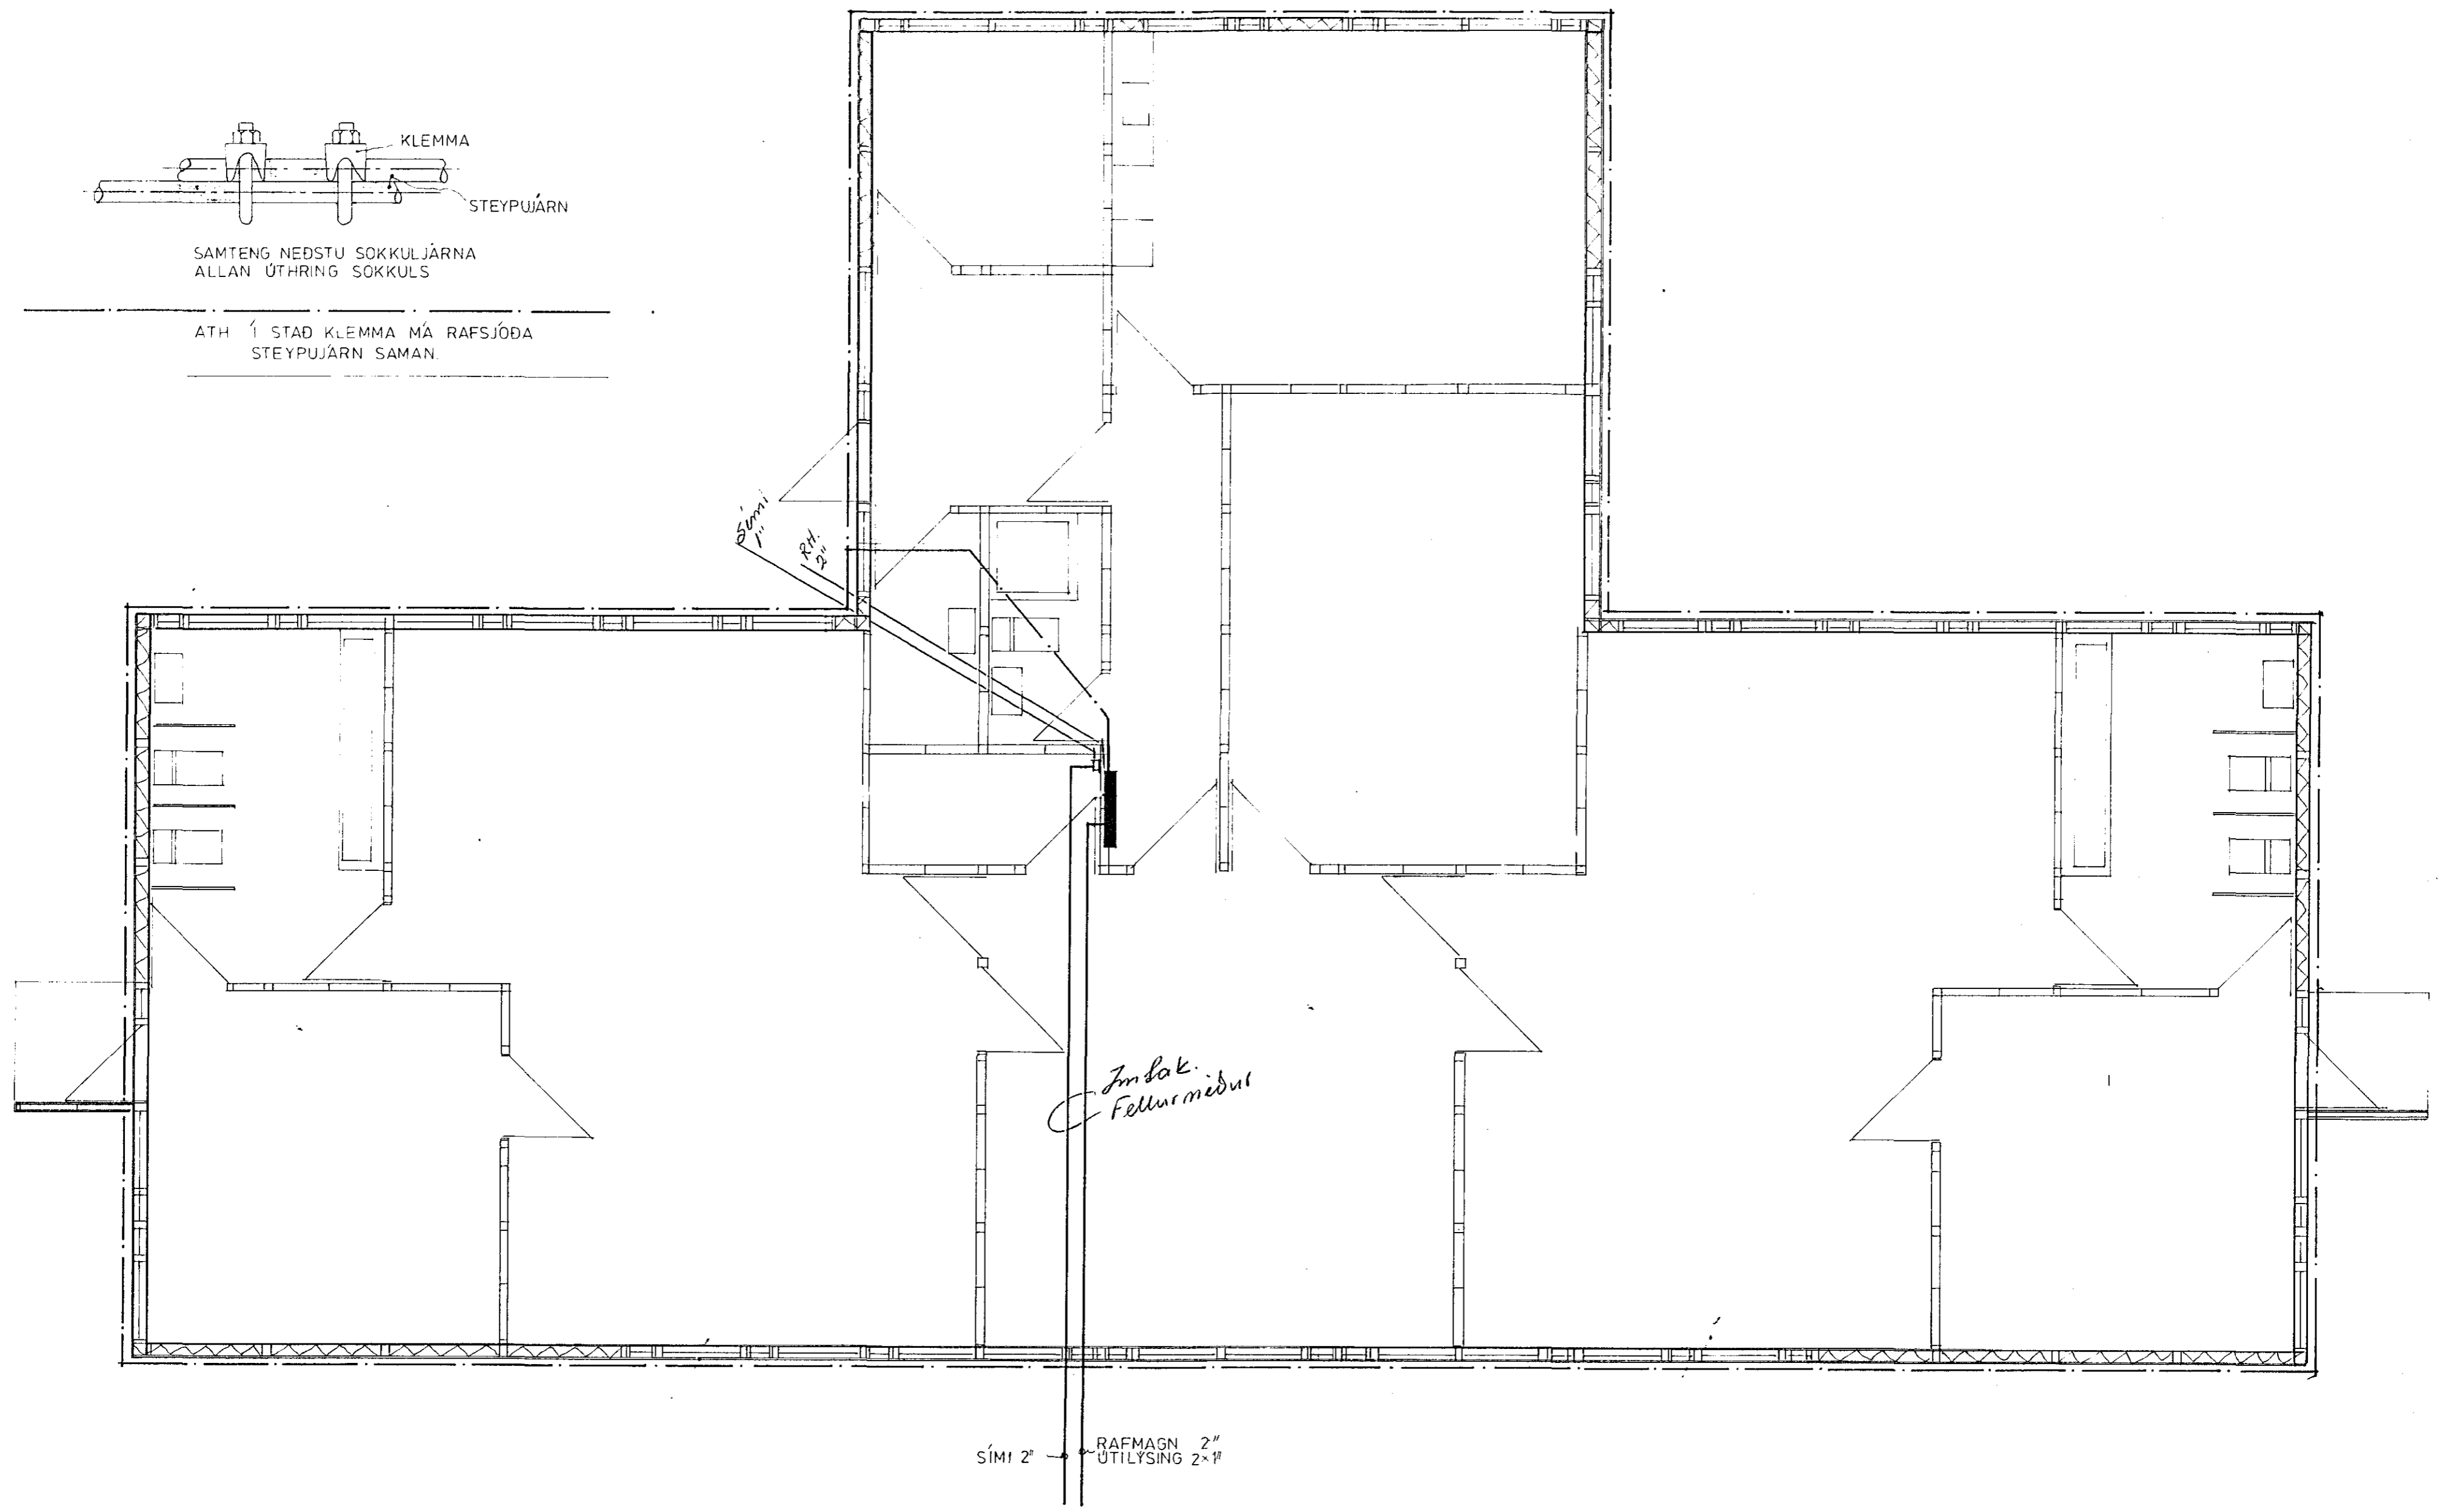

SÍMI 2" RAFMAGN 2"  
ÚTILYSING 2x1"

*Imbók.  
Fellur meður*

FLOKKUN	TEIKN.	NR.	LEIKSKÓLI V. NORDURVANG, HAFNARFIRÐI	
VERK	BLAD	FRH BL	RAFLÖGN Í GRUNNPLÖTU	
	2	3		
KVARDI	1 50			
HÁNNAD	TEIKNAD	YFIRF		
JA	JA	AVF		
AKURDAGUR	OKT. 1981			
			<b>RAFTAKN h.f.</b> GLERÁRGOTU 20 SÍMI 96-19766	

8 7 6 5 4 3 2 1