


AFSTÖÐUMYND 1:500

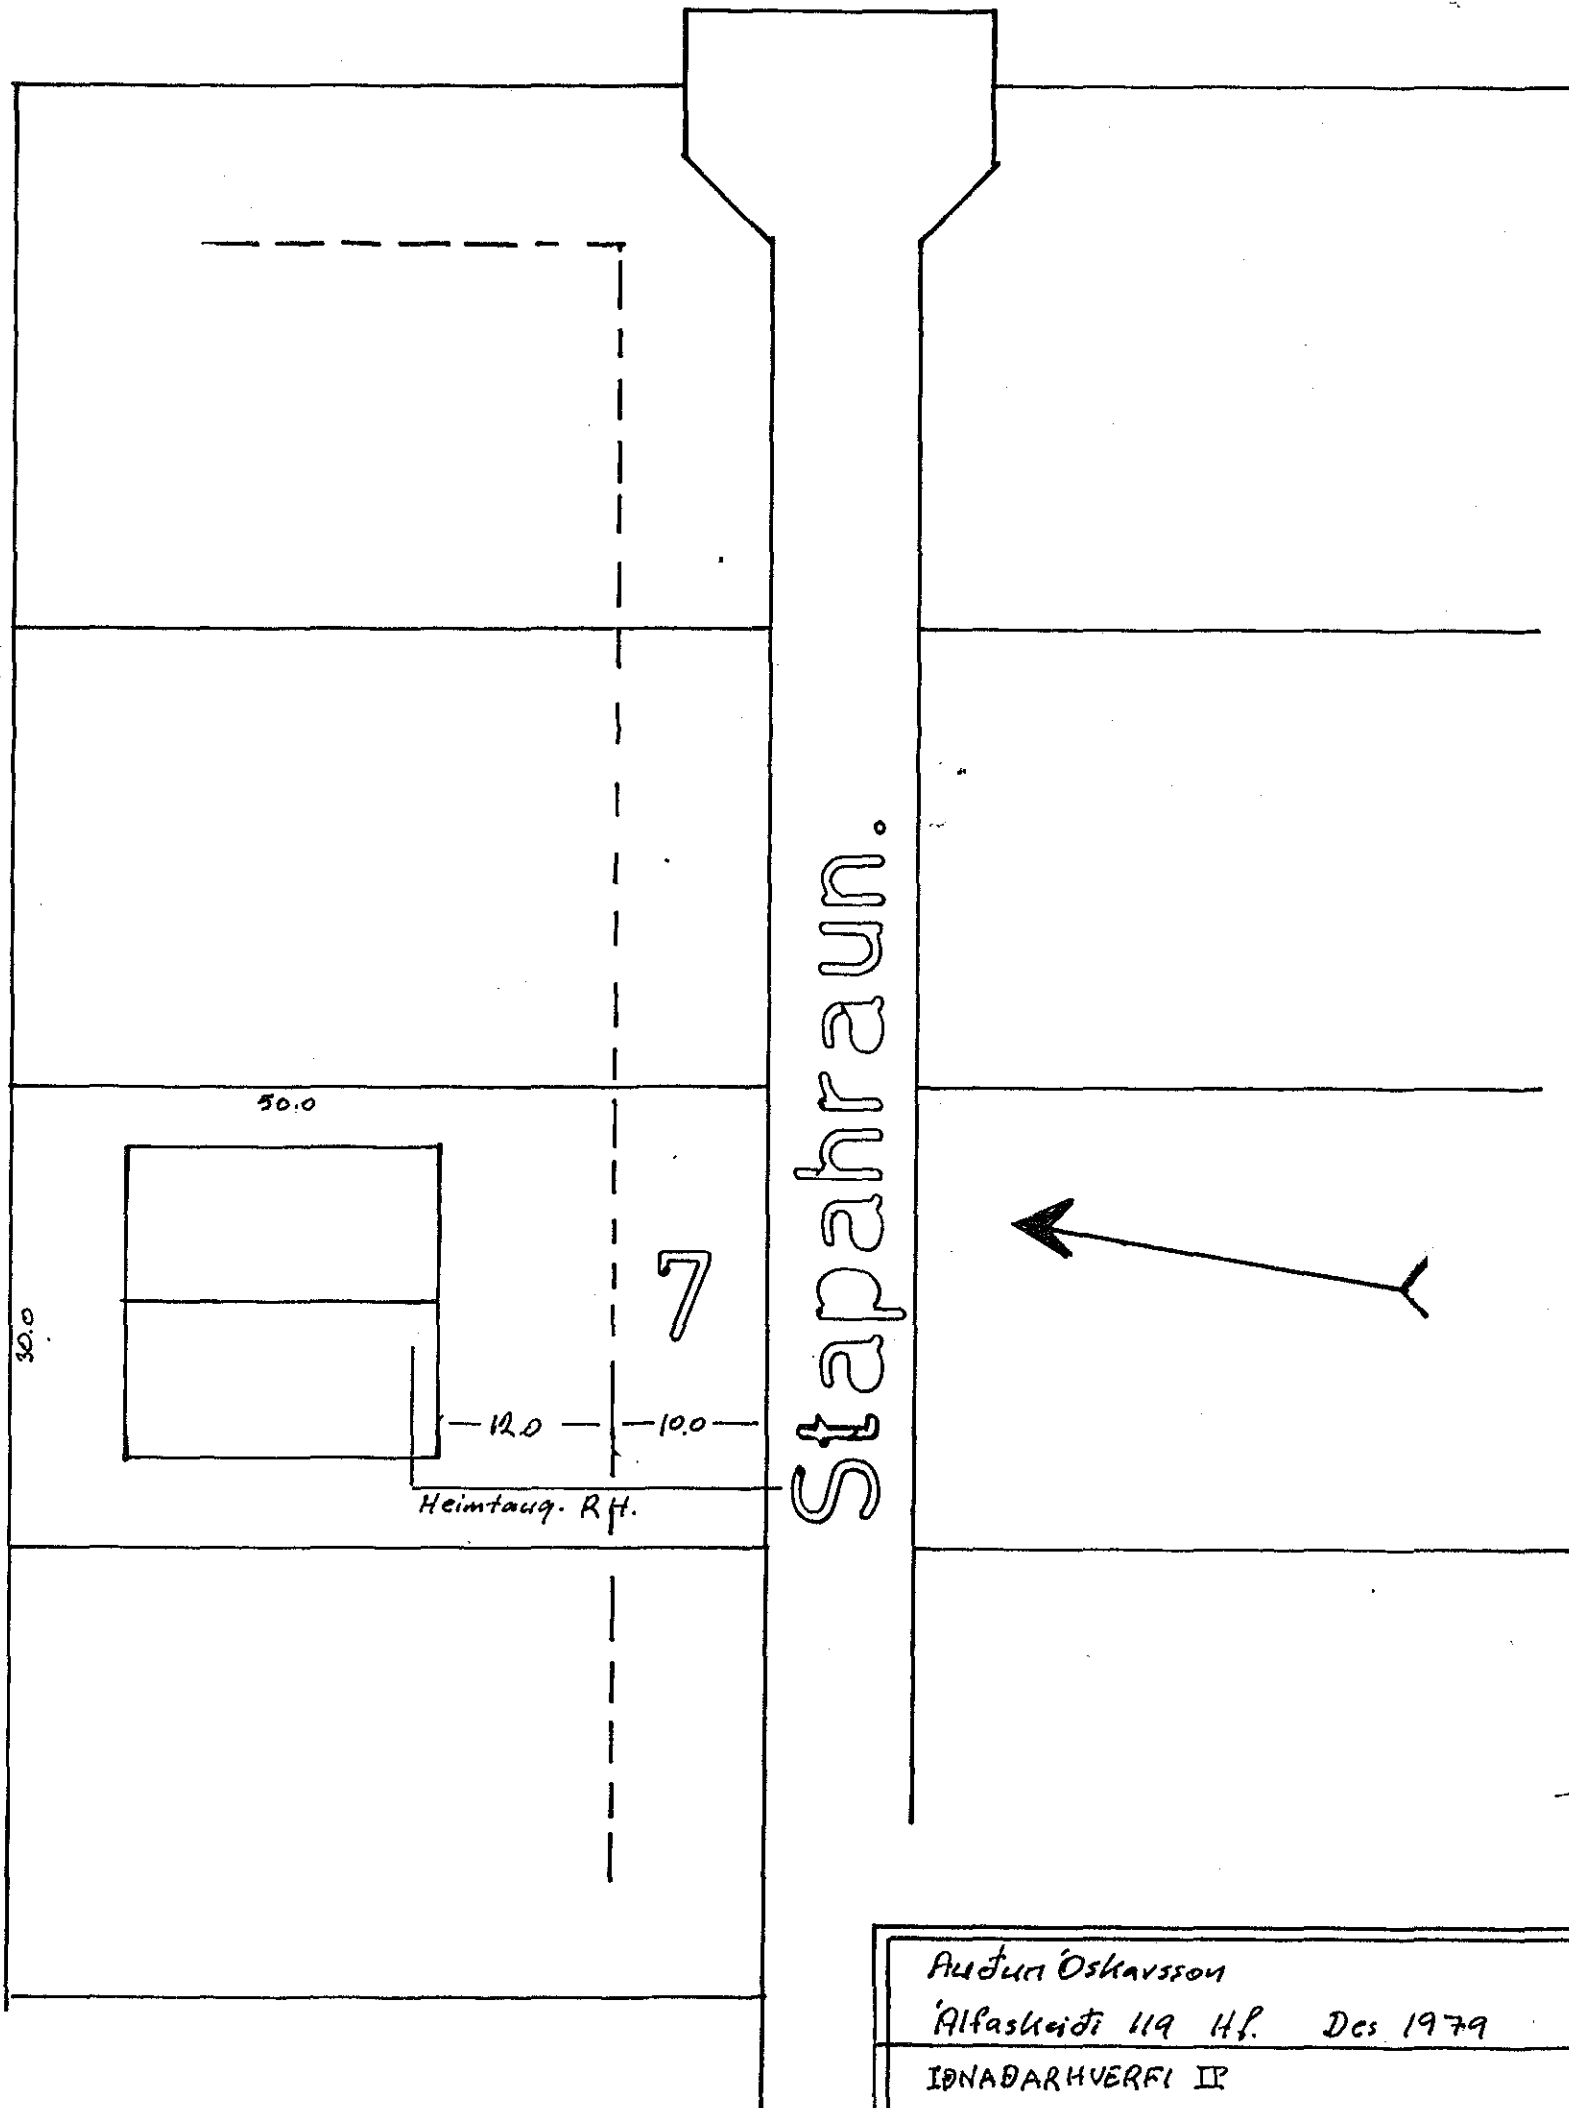

Audun Óskavsson

Alfaskendi 119 Hf. Dec 1979

ÍDNADARHVERFI II

Stapahraun 7.

ÍDNADARHÚS
TREFJA HF.