


AFSTÖÐUMYND M 1:500

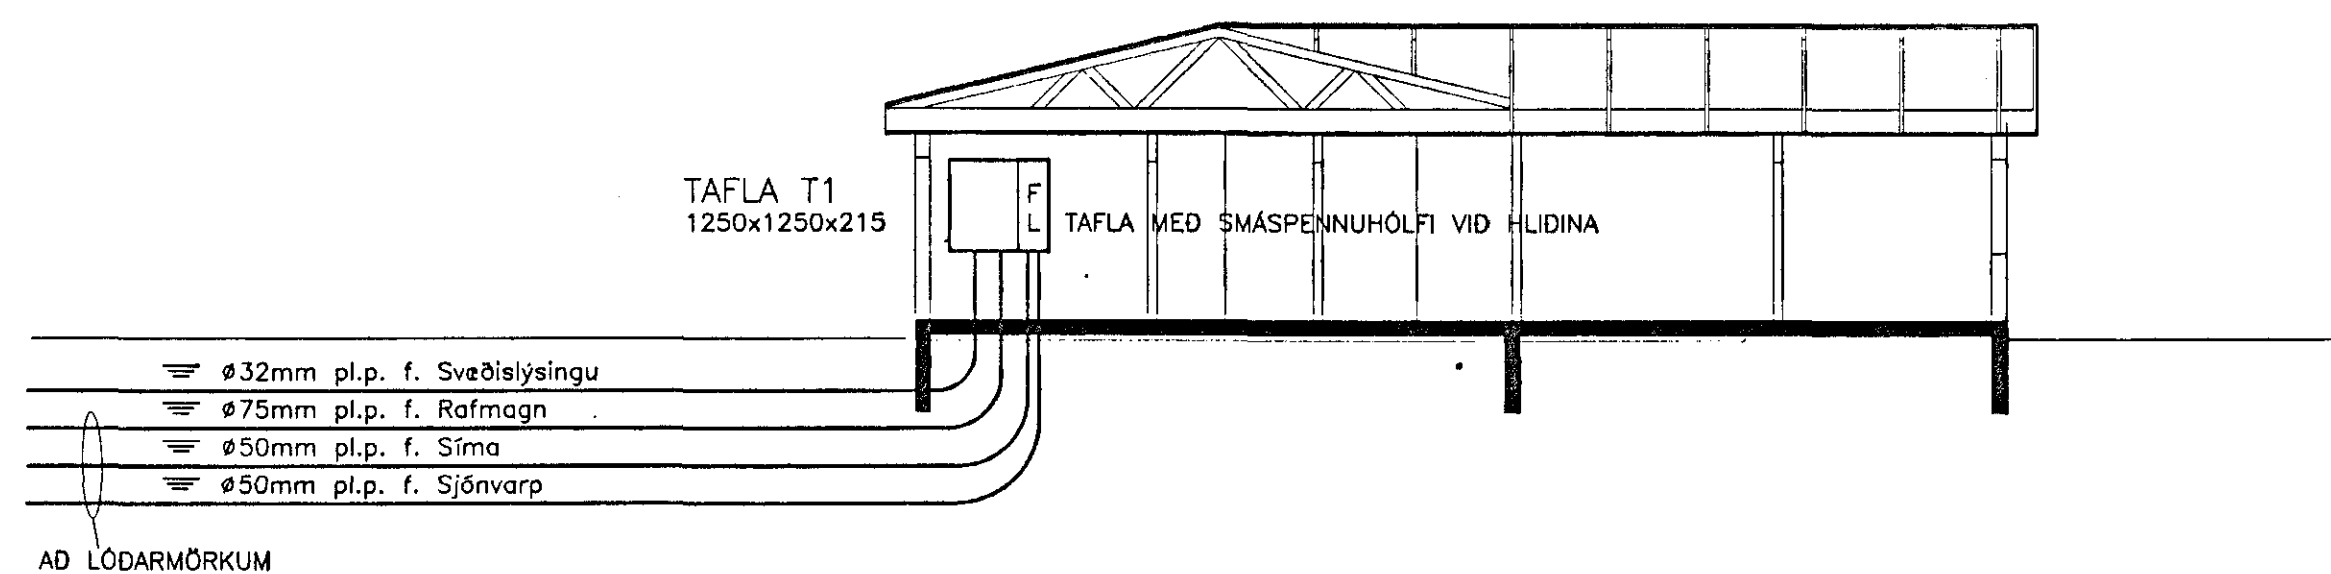

SNID A-A | INNTAK M 1.100

						LEIKSKÓLINN NORDURBERG NORDURVANGI 13, HAFNARFIRÐI AFSTÖÐUMYND OG SNID Í INNTAK		SKV. 1:500; 1:100
						TERA S/R		TEKNI. NR. 1
						RAFMAGNSVERKFRÆÐISTOFA		SKEMM. NR. B
B	02.04.16	Reyndarteikning	T.S.	T.S.	Frank Sverrisson	220110-2139		
A	00-01-14	ÚTBODSTEIKNING	S.E.	T.S.	Frank Sverrisson	220110-2139		
ÖTÖ.	DAGS		TEIKN.	RAHNAÐ.	SAÐYKKT	KINNITALA		