




Sniðmynd A-A, mkv. 1:50

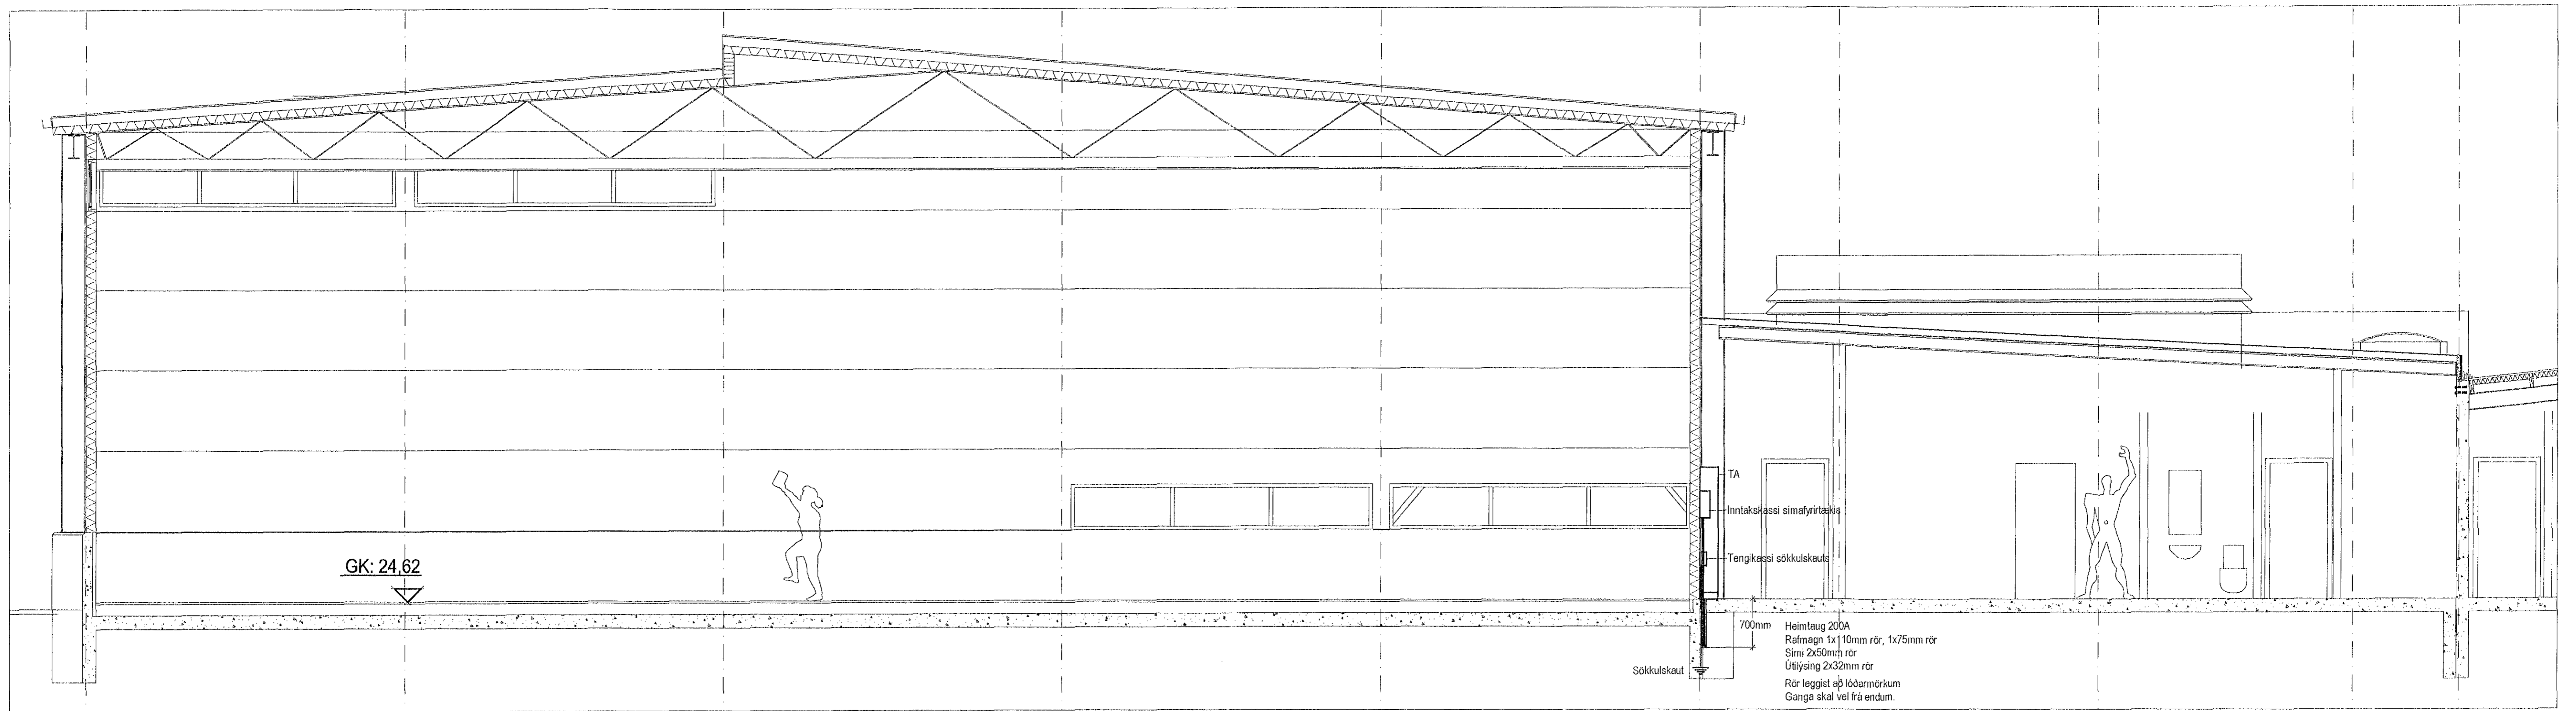

Grunnmynd, mkv. 1:200

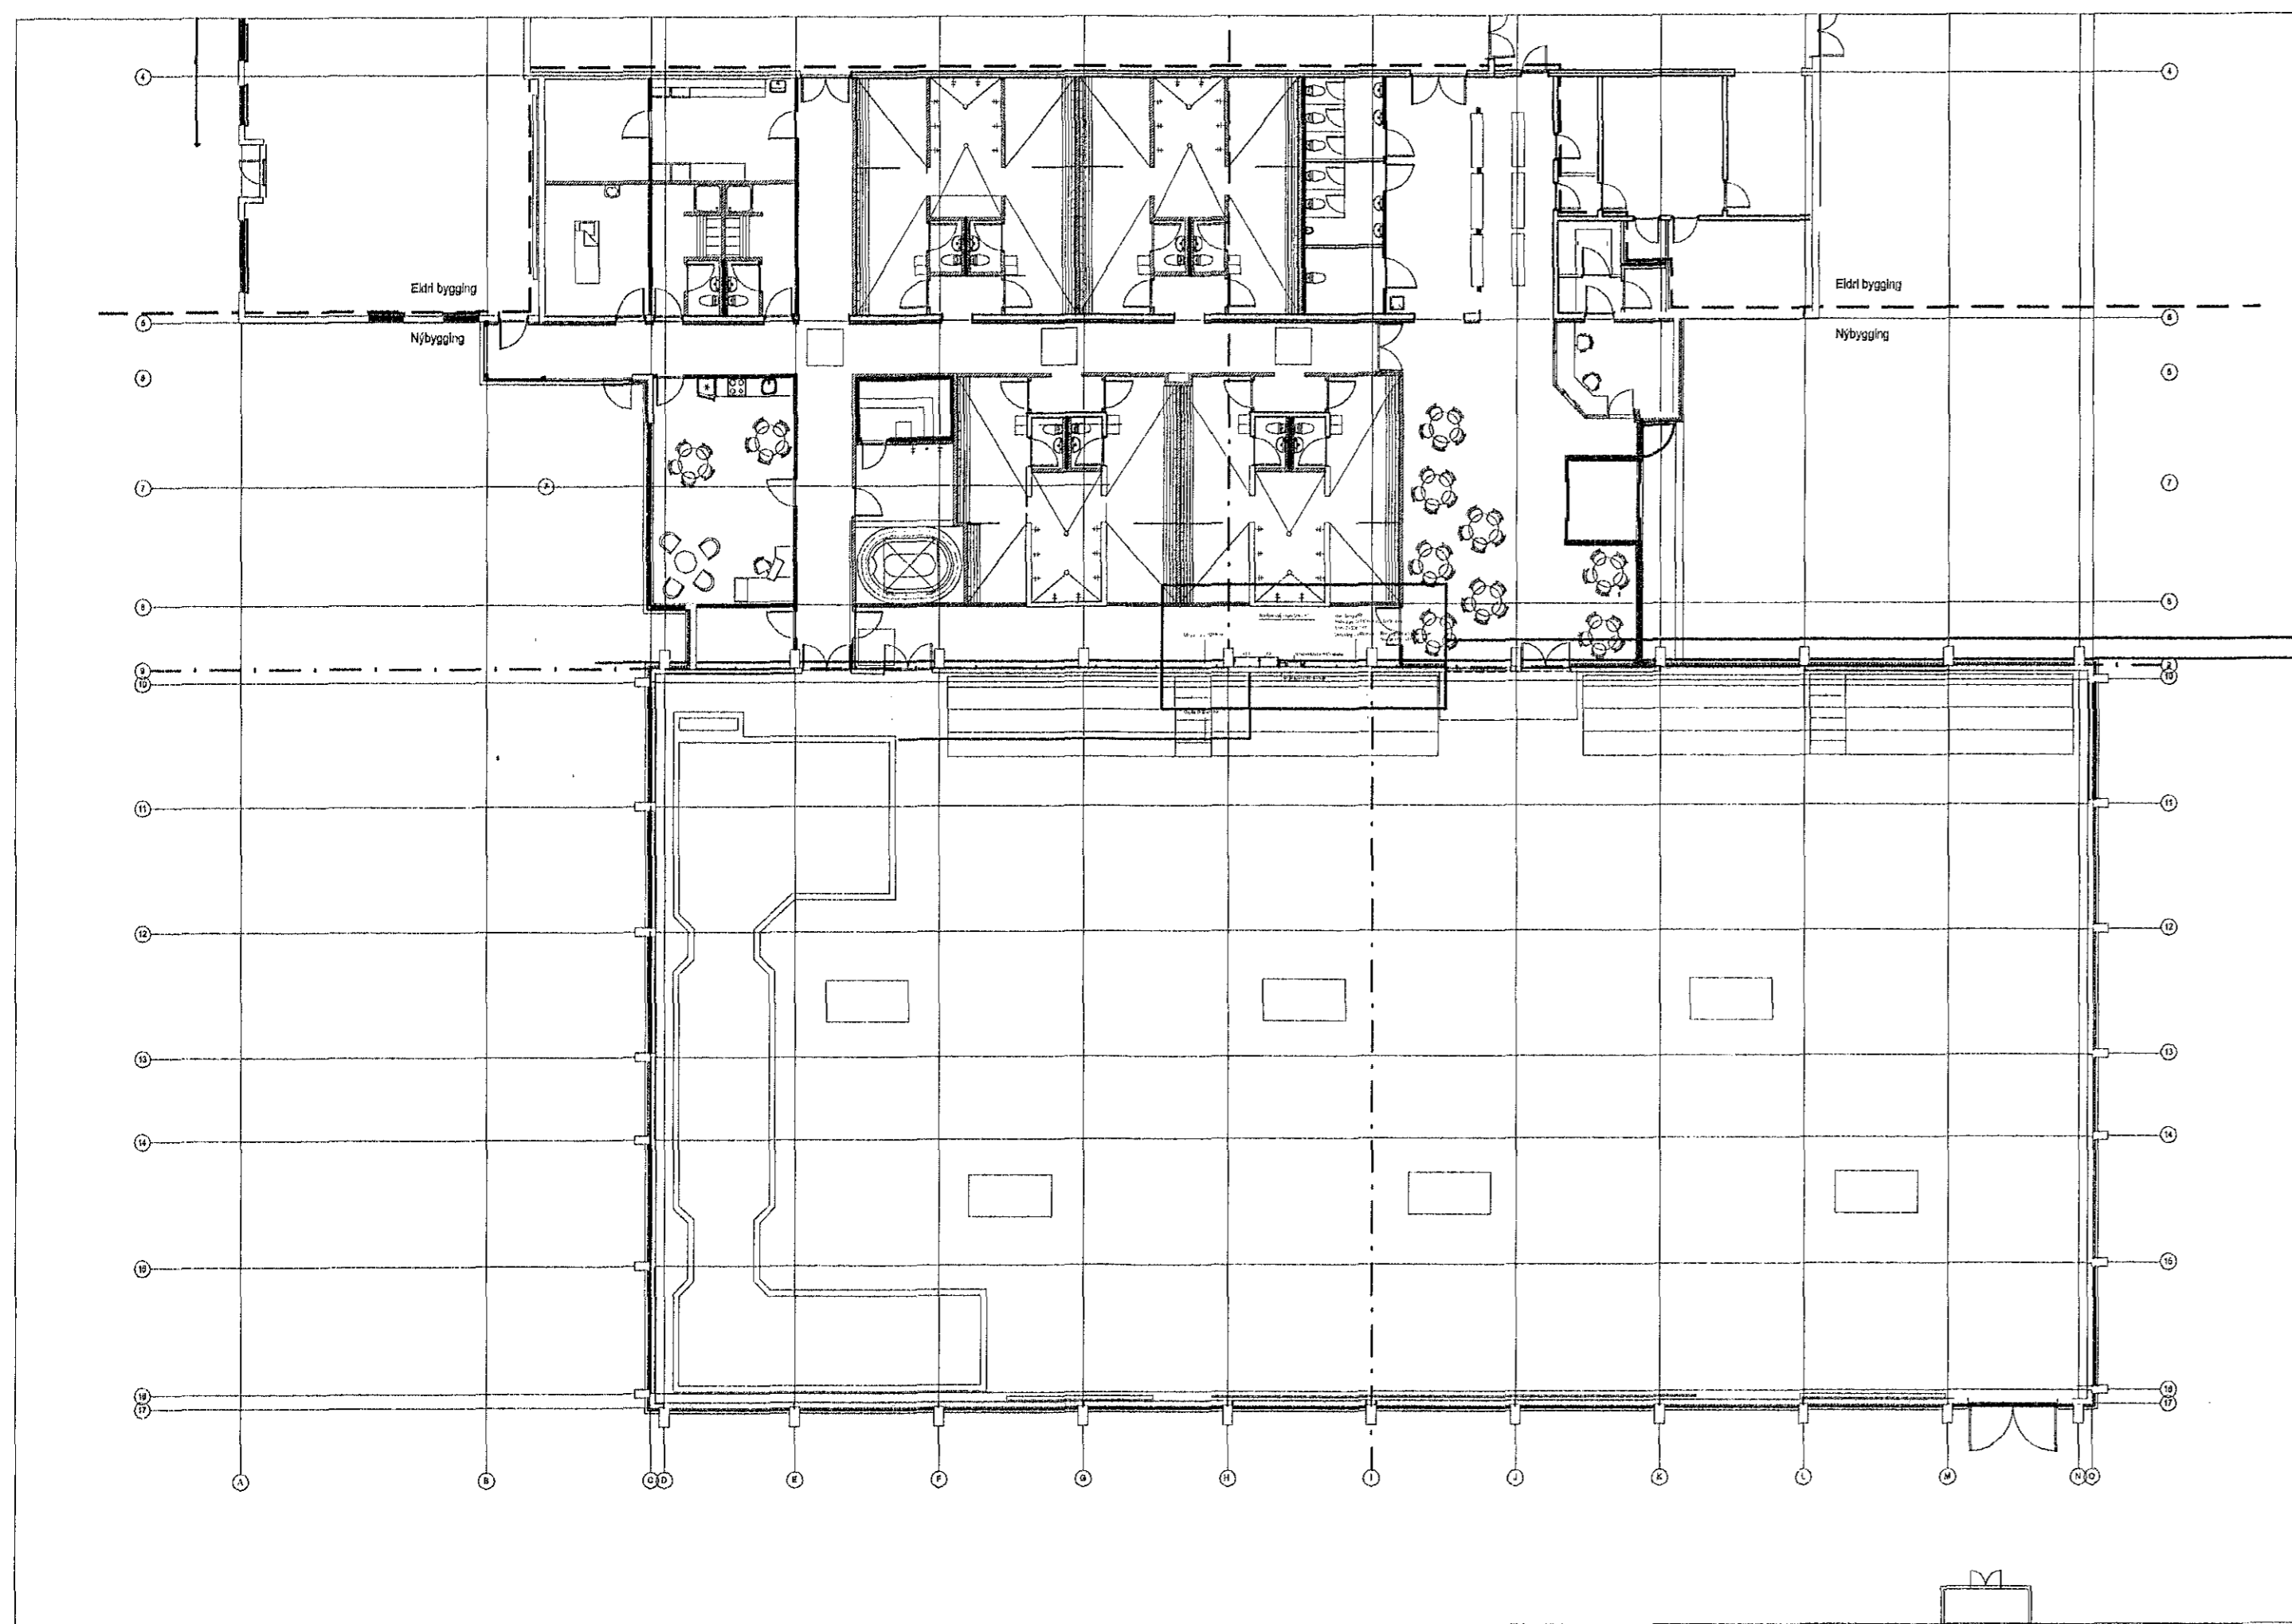

Grunnmynd, mkv. 1:50

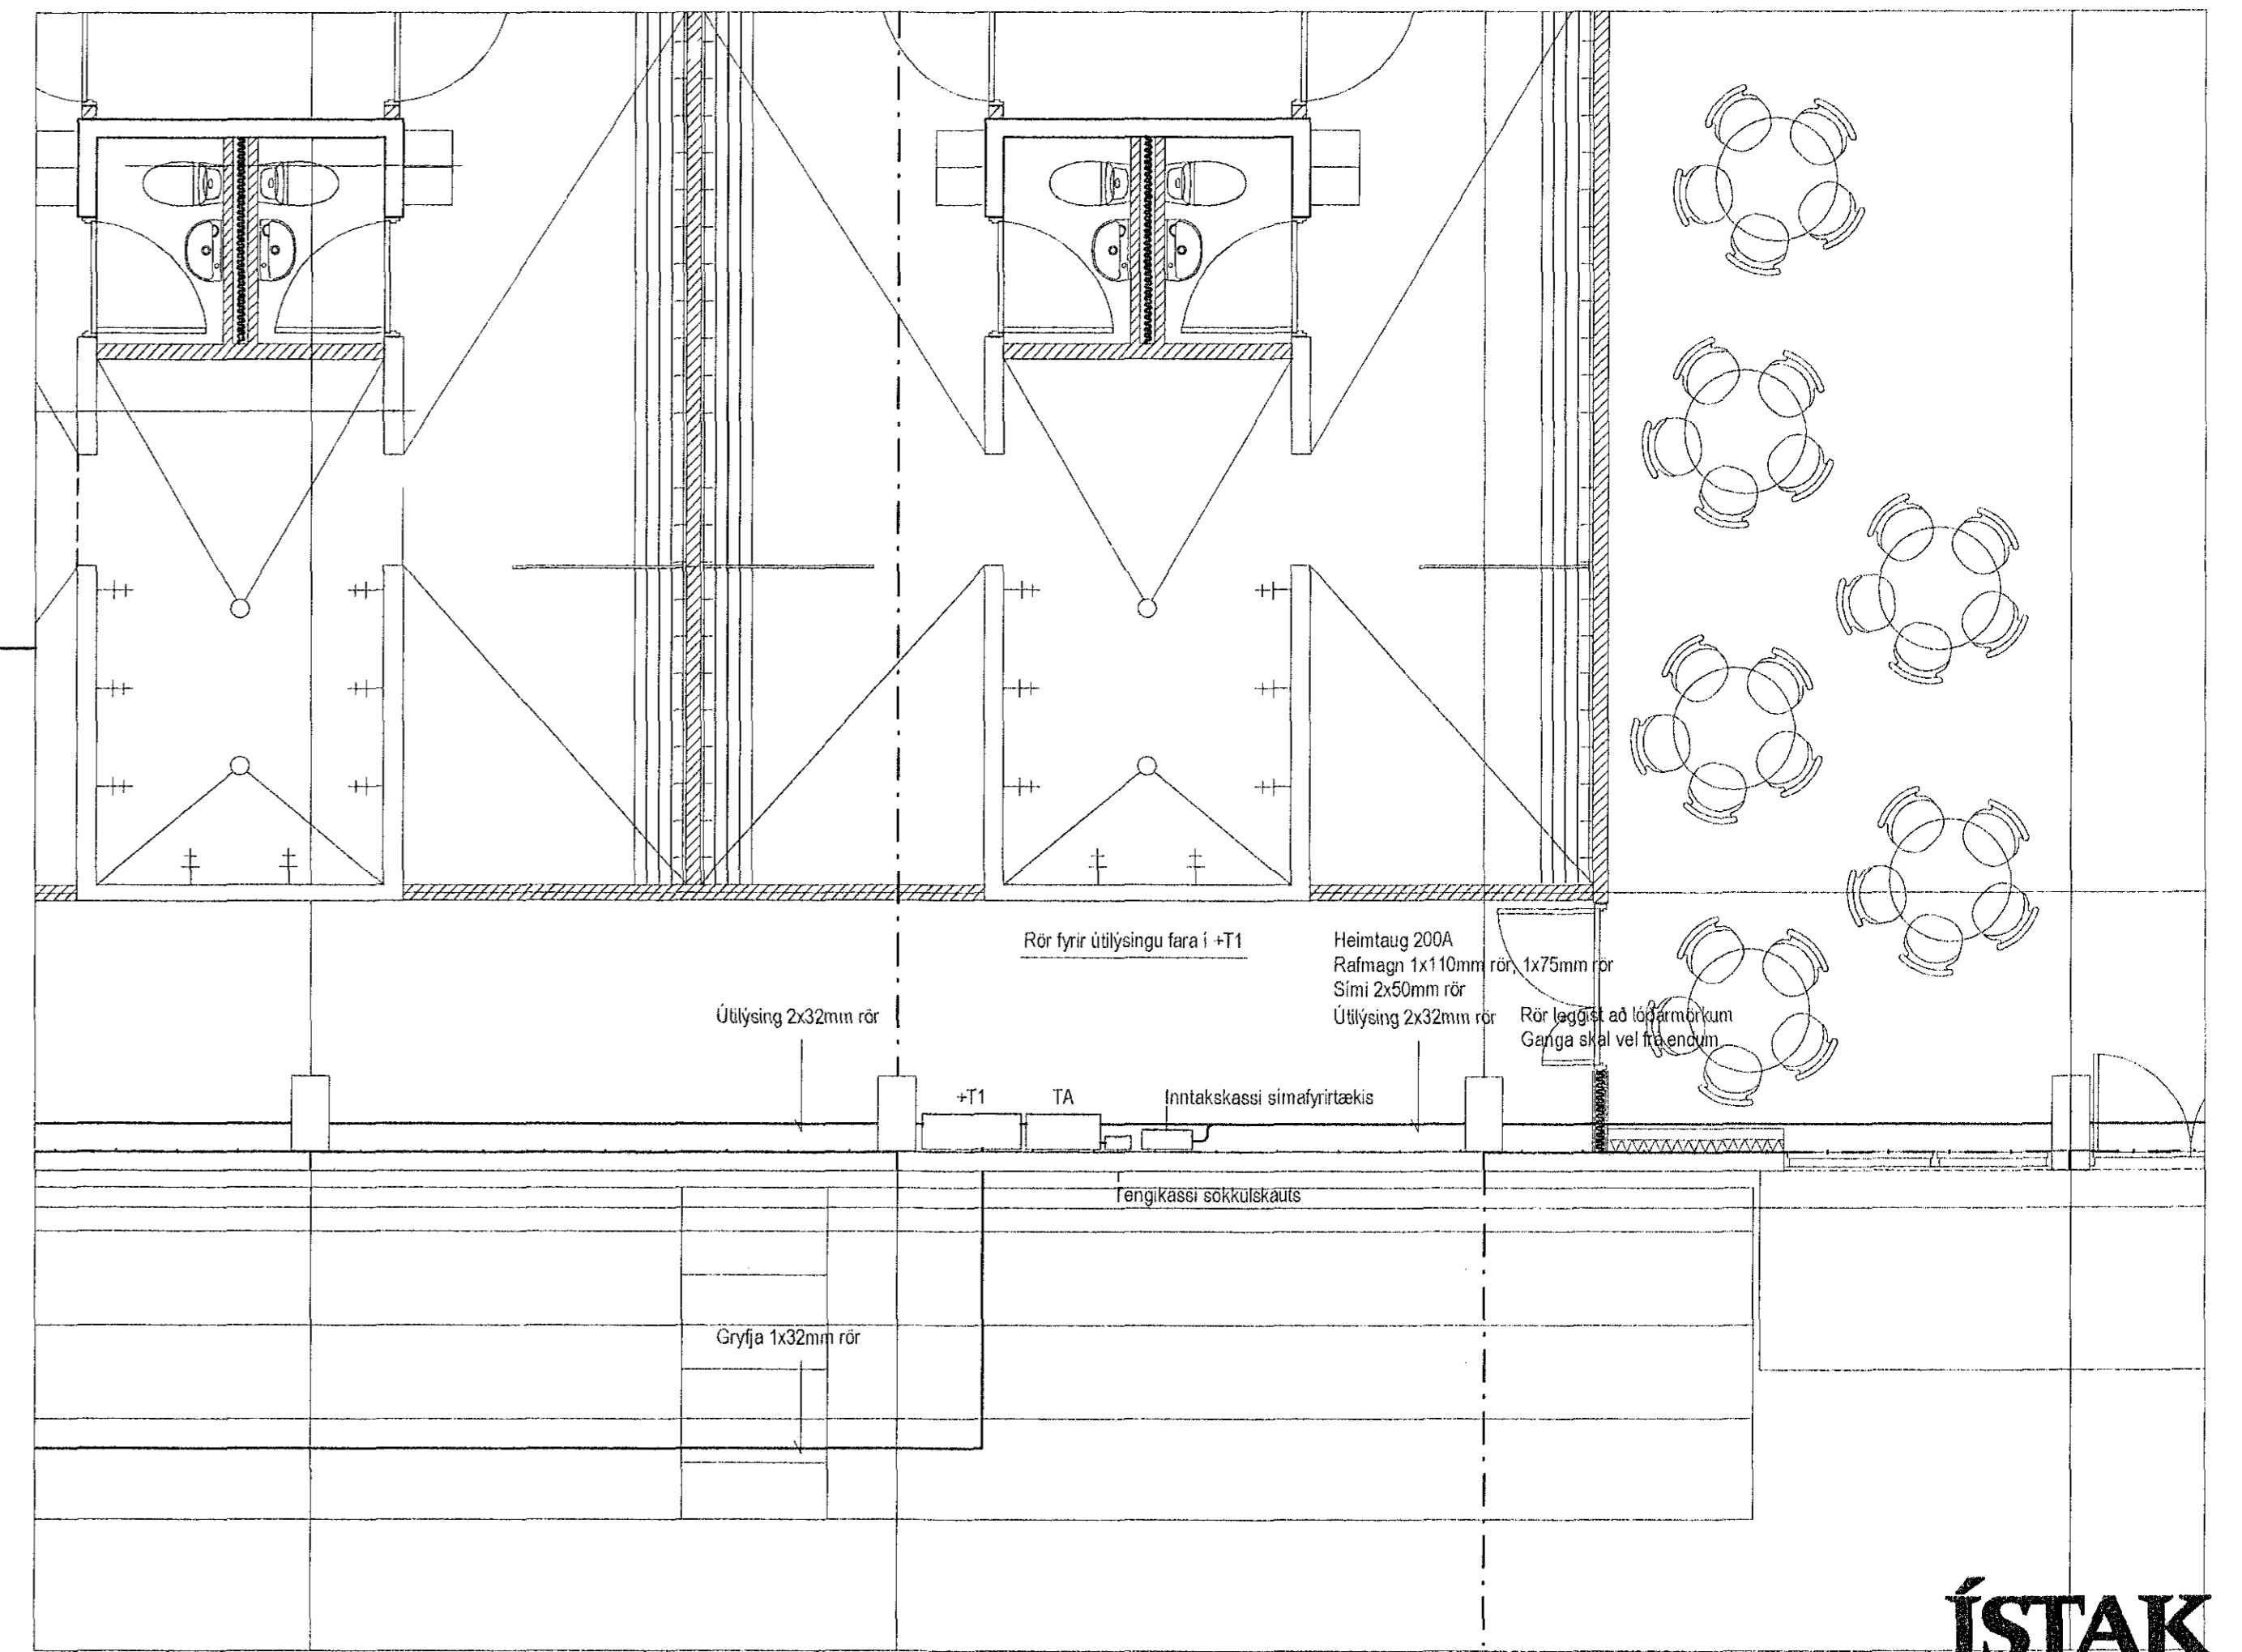

ISTAK

	BREYTING A DAGS 01.10.2001 Breytingar á texta.	BREYTING B DAGS 09.04.2002 REYNDARTEIKNINGAR	BREYTING C DAGS	BREYTING D DAGS	TEIKNAR ags	PRF RTS	TÖLVAHEITI 1097-002 . DWG	VERKHEITI BJARKARHÚS, HAUKAHLAUNI 1, 220 HAFNARFJÖRDUR		TEIKNINGIR 56-1097-1-002
	MELISTONNUR 0 5 10 15 20 25 30 cm	MELIKVÆÐI 1:50 / 1:200	SAMRÁÐGAFI David E. Sölvason Kt. 100356-3339	VERKHEITI GRUNNMYND OG SNID AF HEIMTAUG	FRANNAÐ ags	GRENASÁVEGUR 3 • 108 REYKJAVÍK 520 9900 • FAX 520 9901	DAGS 18.09.2001	BREYTI B		