
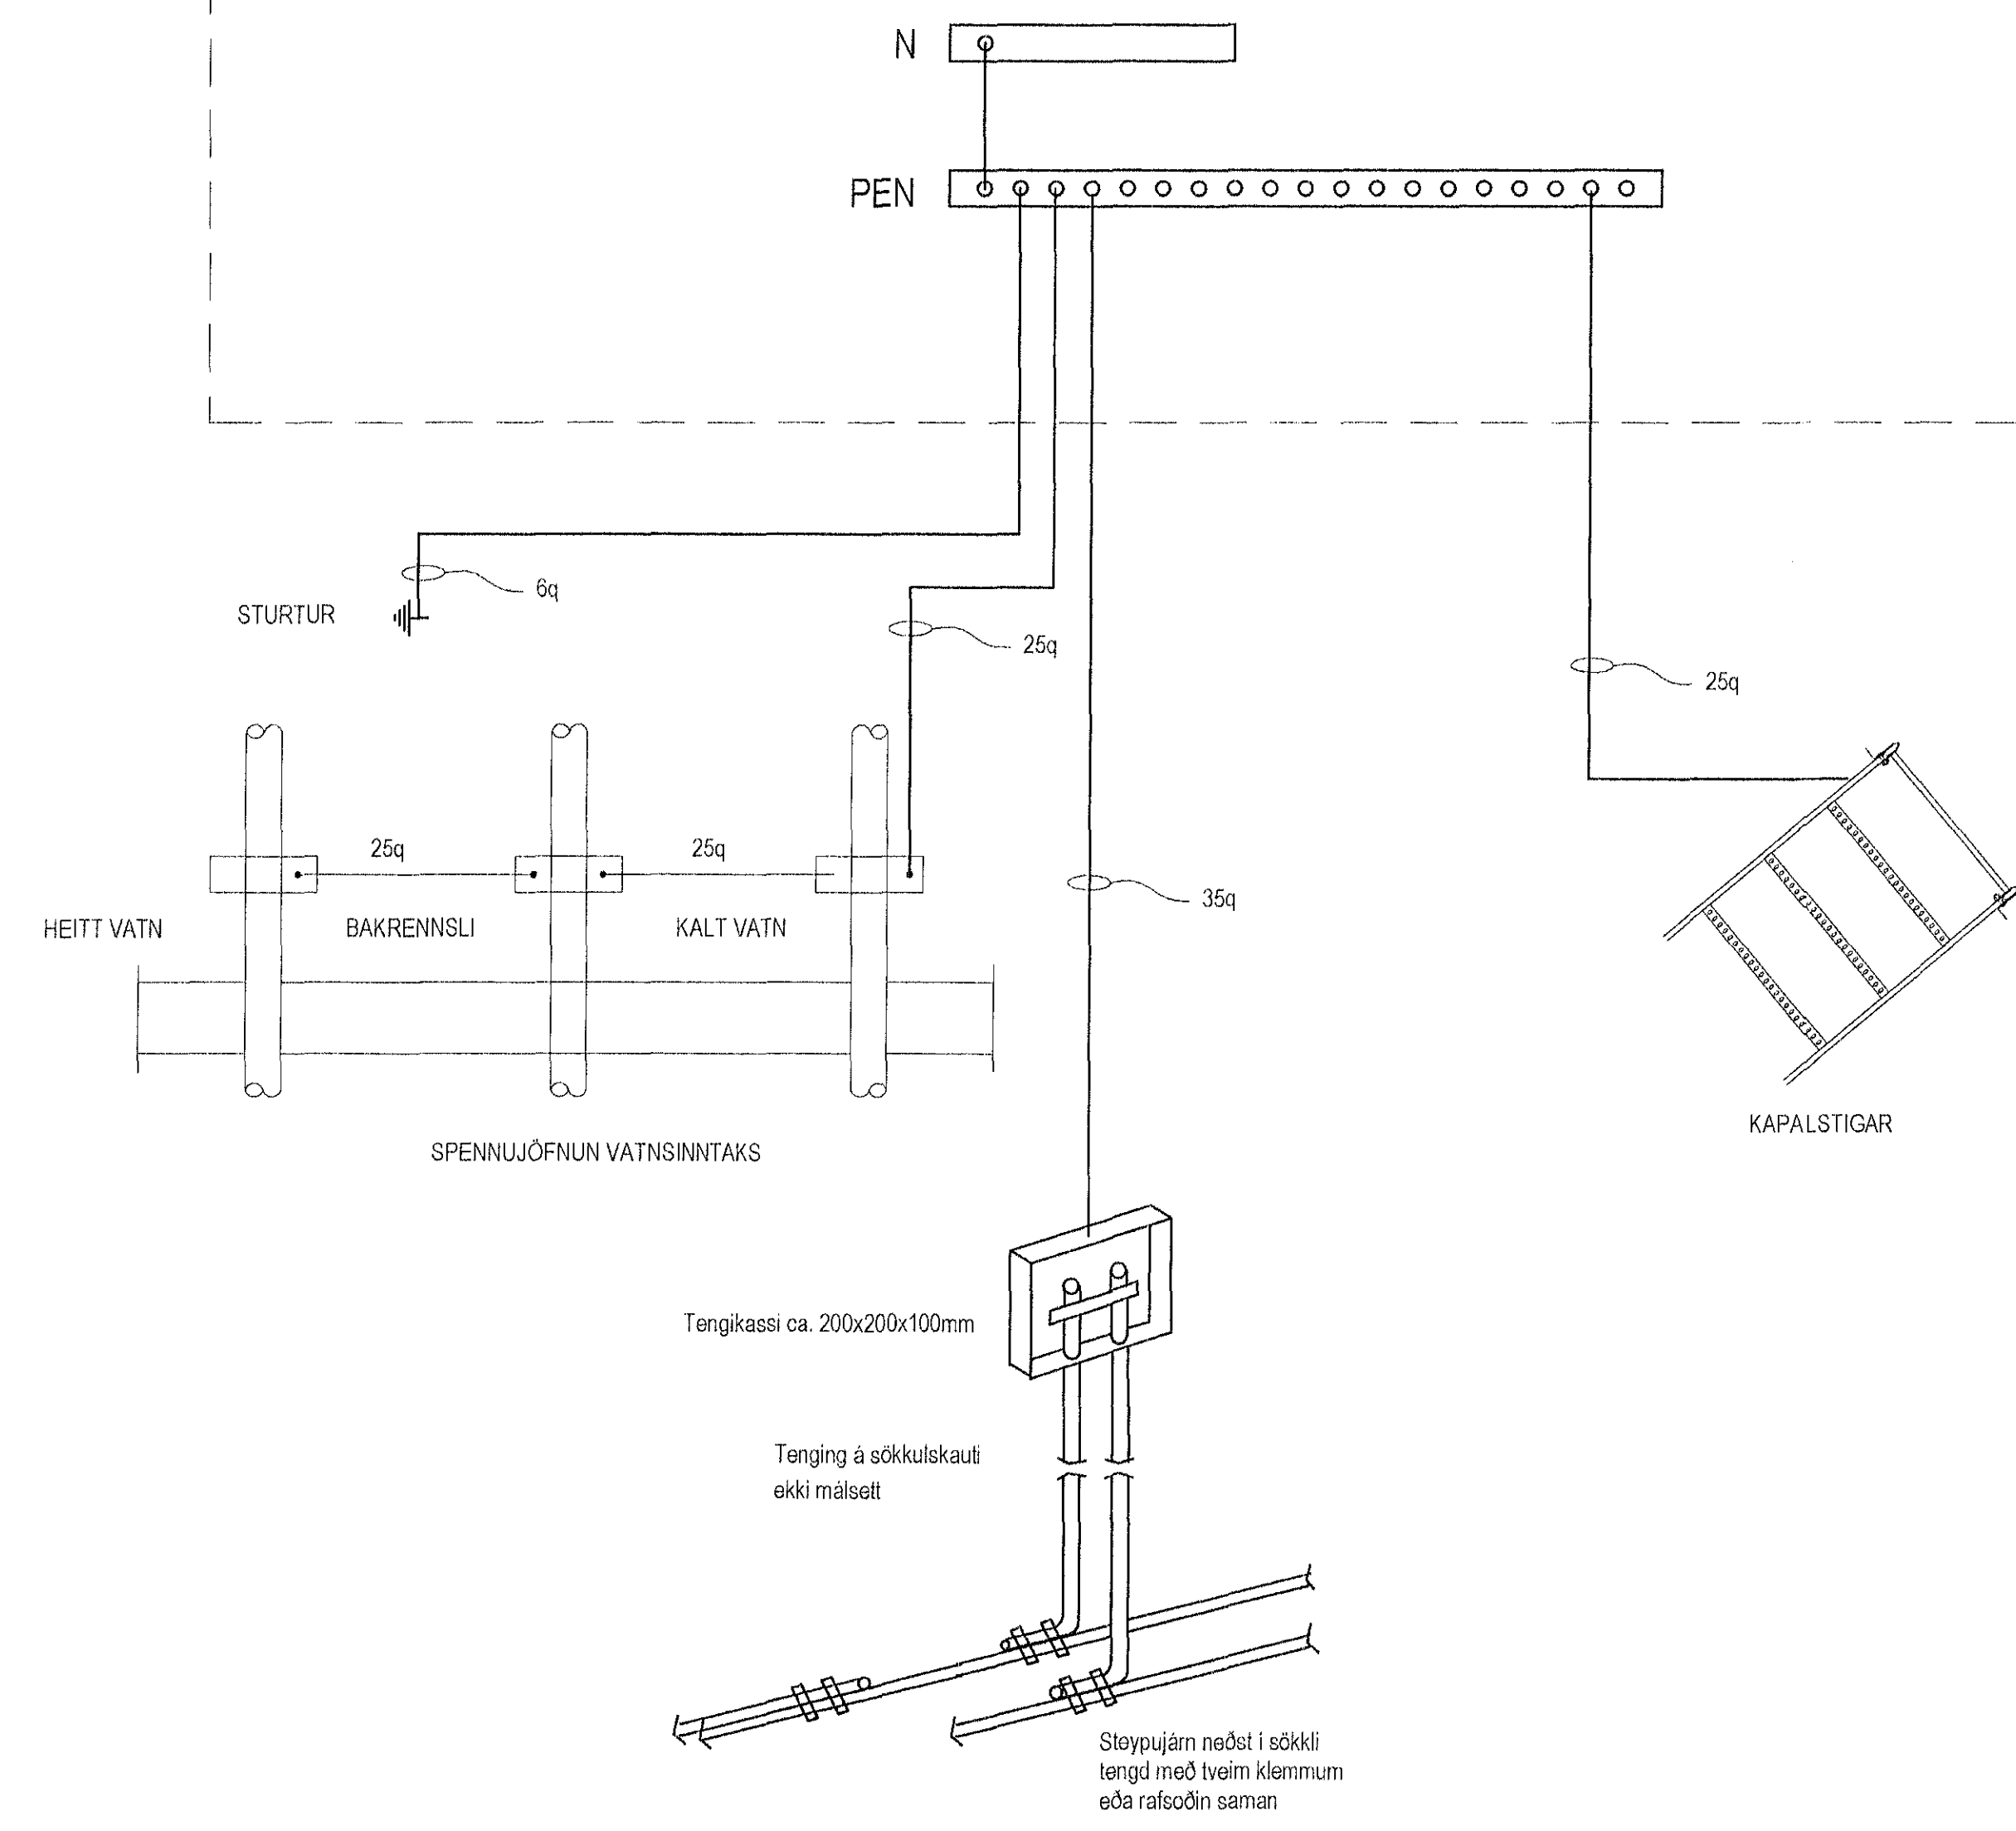


ADALTAFLA TA

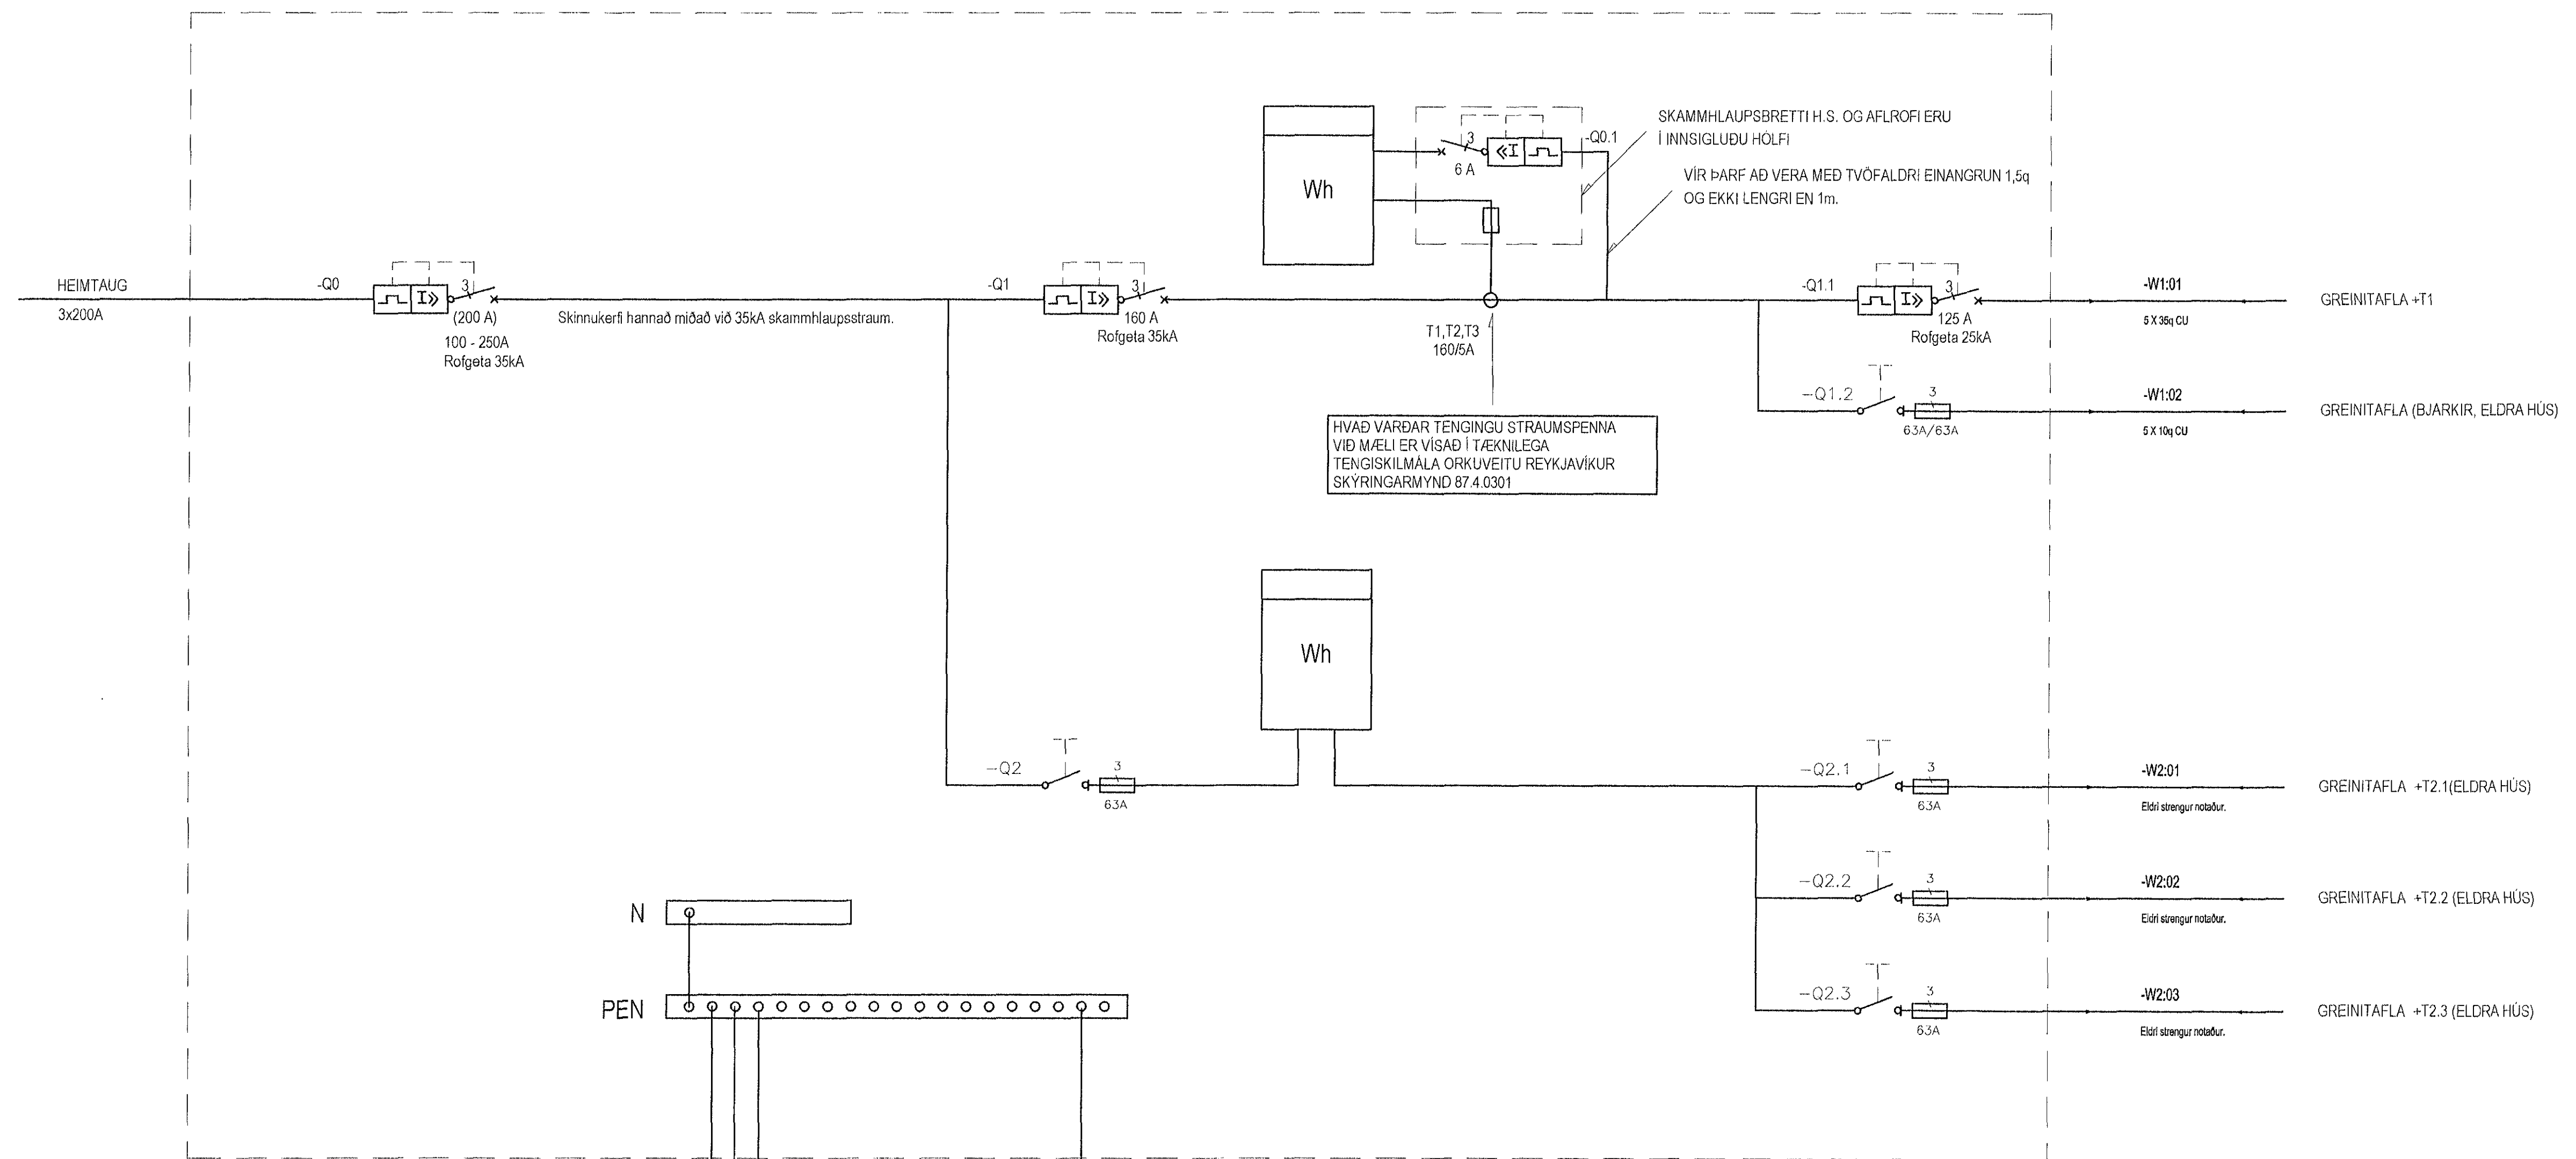

ÍSTAK

	BREYTINGA DAGS 08.01.2002 Tæknibreyting	BREYTING B DAGS 09.04.2002 REYNDARTEIGNINGAR	BREYTING C DAGS 9	TEIKNAD ags	VYRF RTS	TÖLVUHEITI 1097-005 . DWG	VERKJAFI BJARKARHÚS, HAUKAHLAUNI 1, 220 HAFNARFJÖRÐUR		RAFTÆKNISTOFAN	TEIKNING NR 56-1097-1-005
MELISTOKUR	0 5 10 15 20 25 30 cm	MELIKNÁRI ENGINN	SAMBYKKT David E. Sölvason Kr. 100356-3339	VERKJAFI EINLINUMYND TA	HANUÐ ags	GREINISVEGUR 3 520 5900	108 REYKJAVÍK FAX: 520 5901	DAGS 19.09.2001	BREYTI B	