


Sneiðing A-A

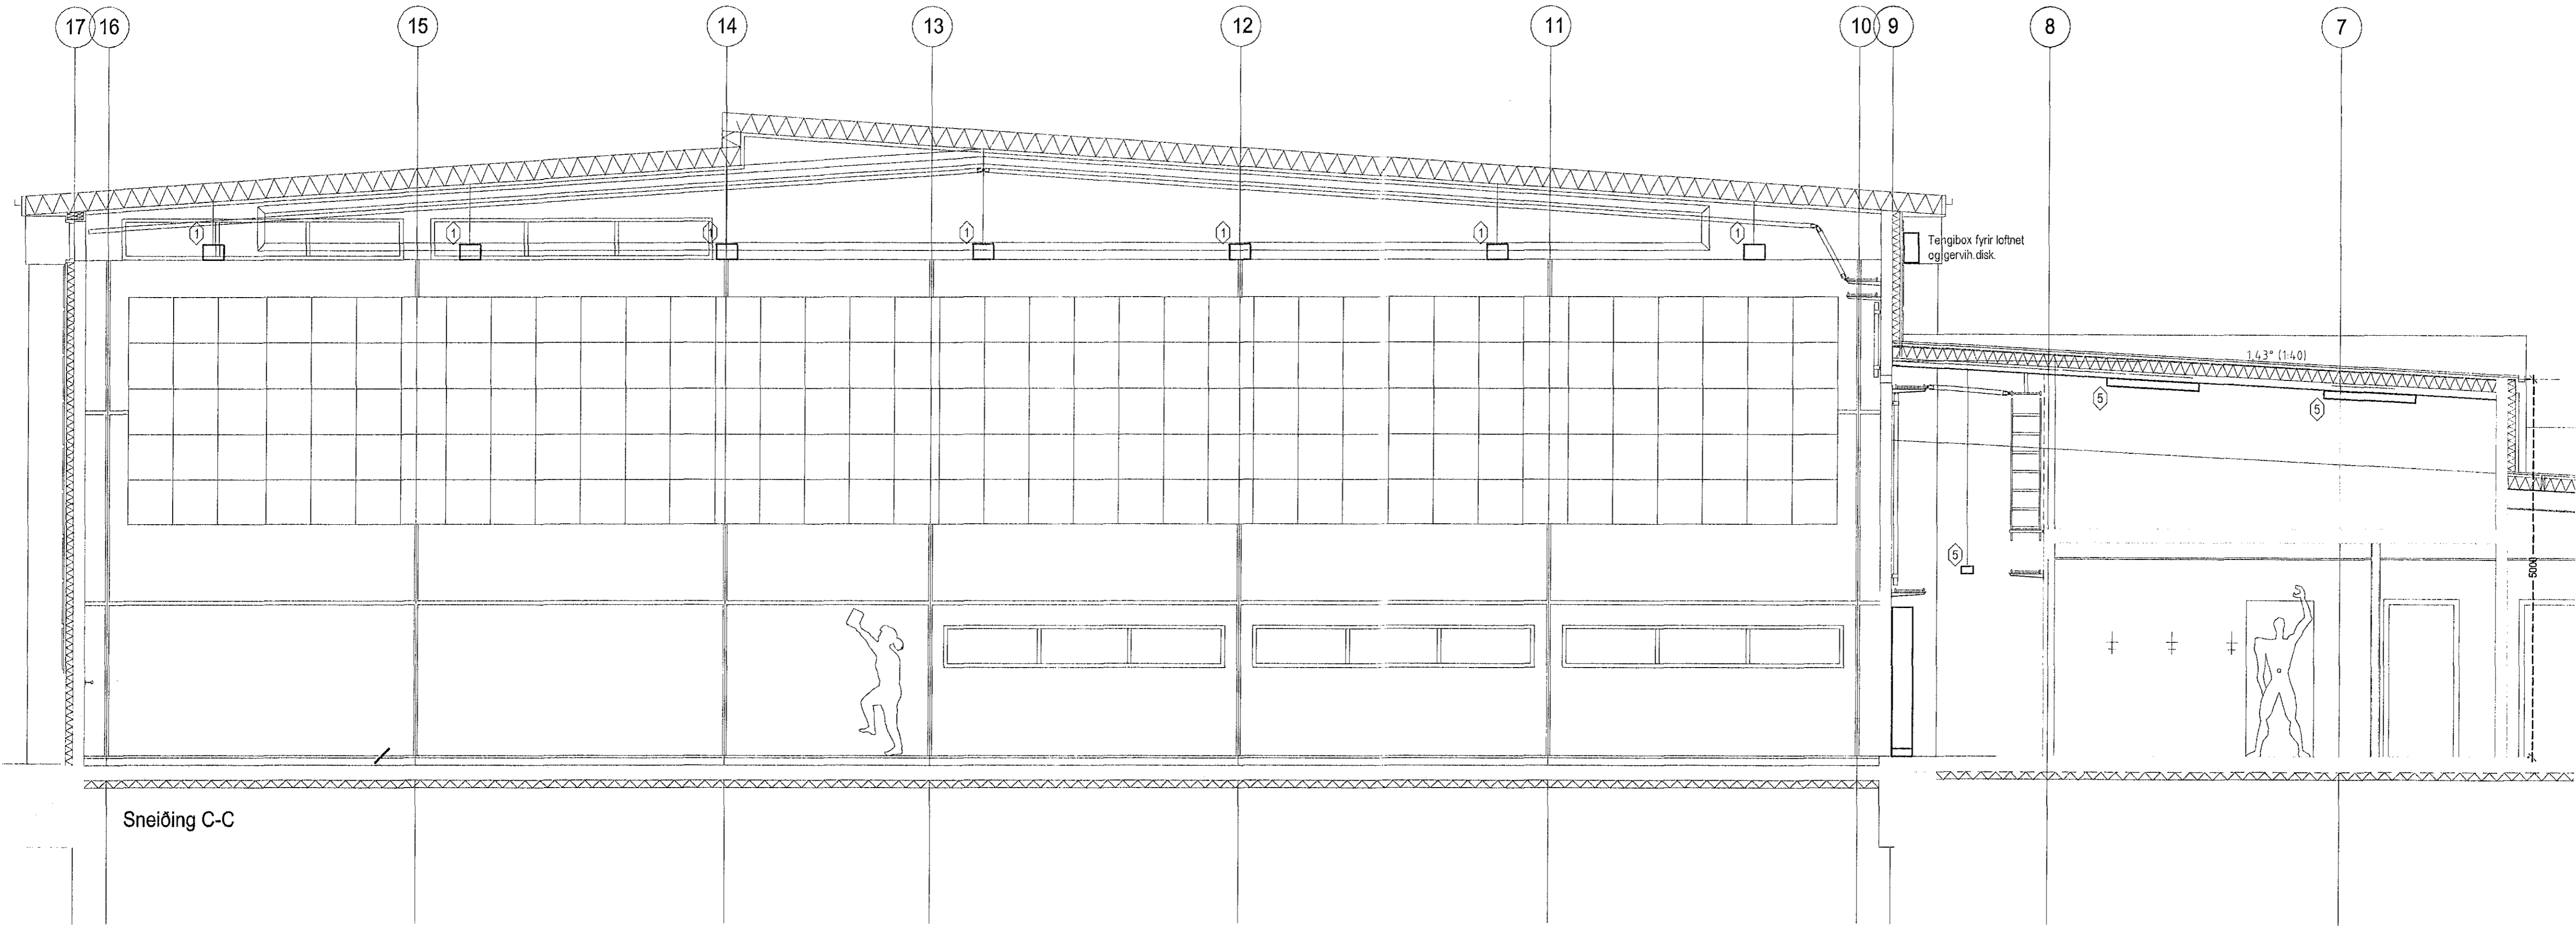

Sneiðing C-C

ÍSTAK

	BREYTING A DAGS 10.01.2002 VIÐBÆTUR	BREYTING B DAGS 10.04.2002 REYNDARTEIKNINGAR	BREYTING C DAGS	BREYTING D DAGS	TEIKNAD ags	VÆRIF RTS	TOLLVÆÐI 1097-011, DWG	VERNHEITI BJARKARHÚS, HAUKAHRÁUNI 1, 220 HAFNARFJÖRÐUR		RAFTÆKNISTOFAN	TILKUNING NR. 56-1097-1-011
	MÆLISKUR 0 5 10 15 20 25 30 cm	MÆLIVARÐI 1:50	SAMBYRKT Davíð E. Sólvason Kt. 100356-3339	VERNHLUTUR SNIÐMYNDIR - SALUR	STAÐNÁM ags	GRENÁSVEGUR 3 • 108 REYKJAVÍK 520 9900 • FAX 520 9901	DAGS 13.12.2001	BREYTI B			