



Skýringar:
SK = Skammhlaupseining

56-1097-1-140 | 56-1097-1-141

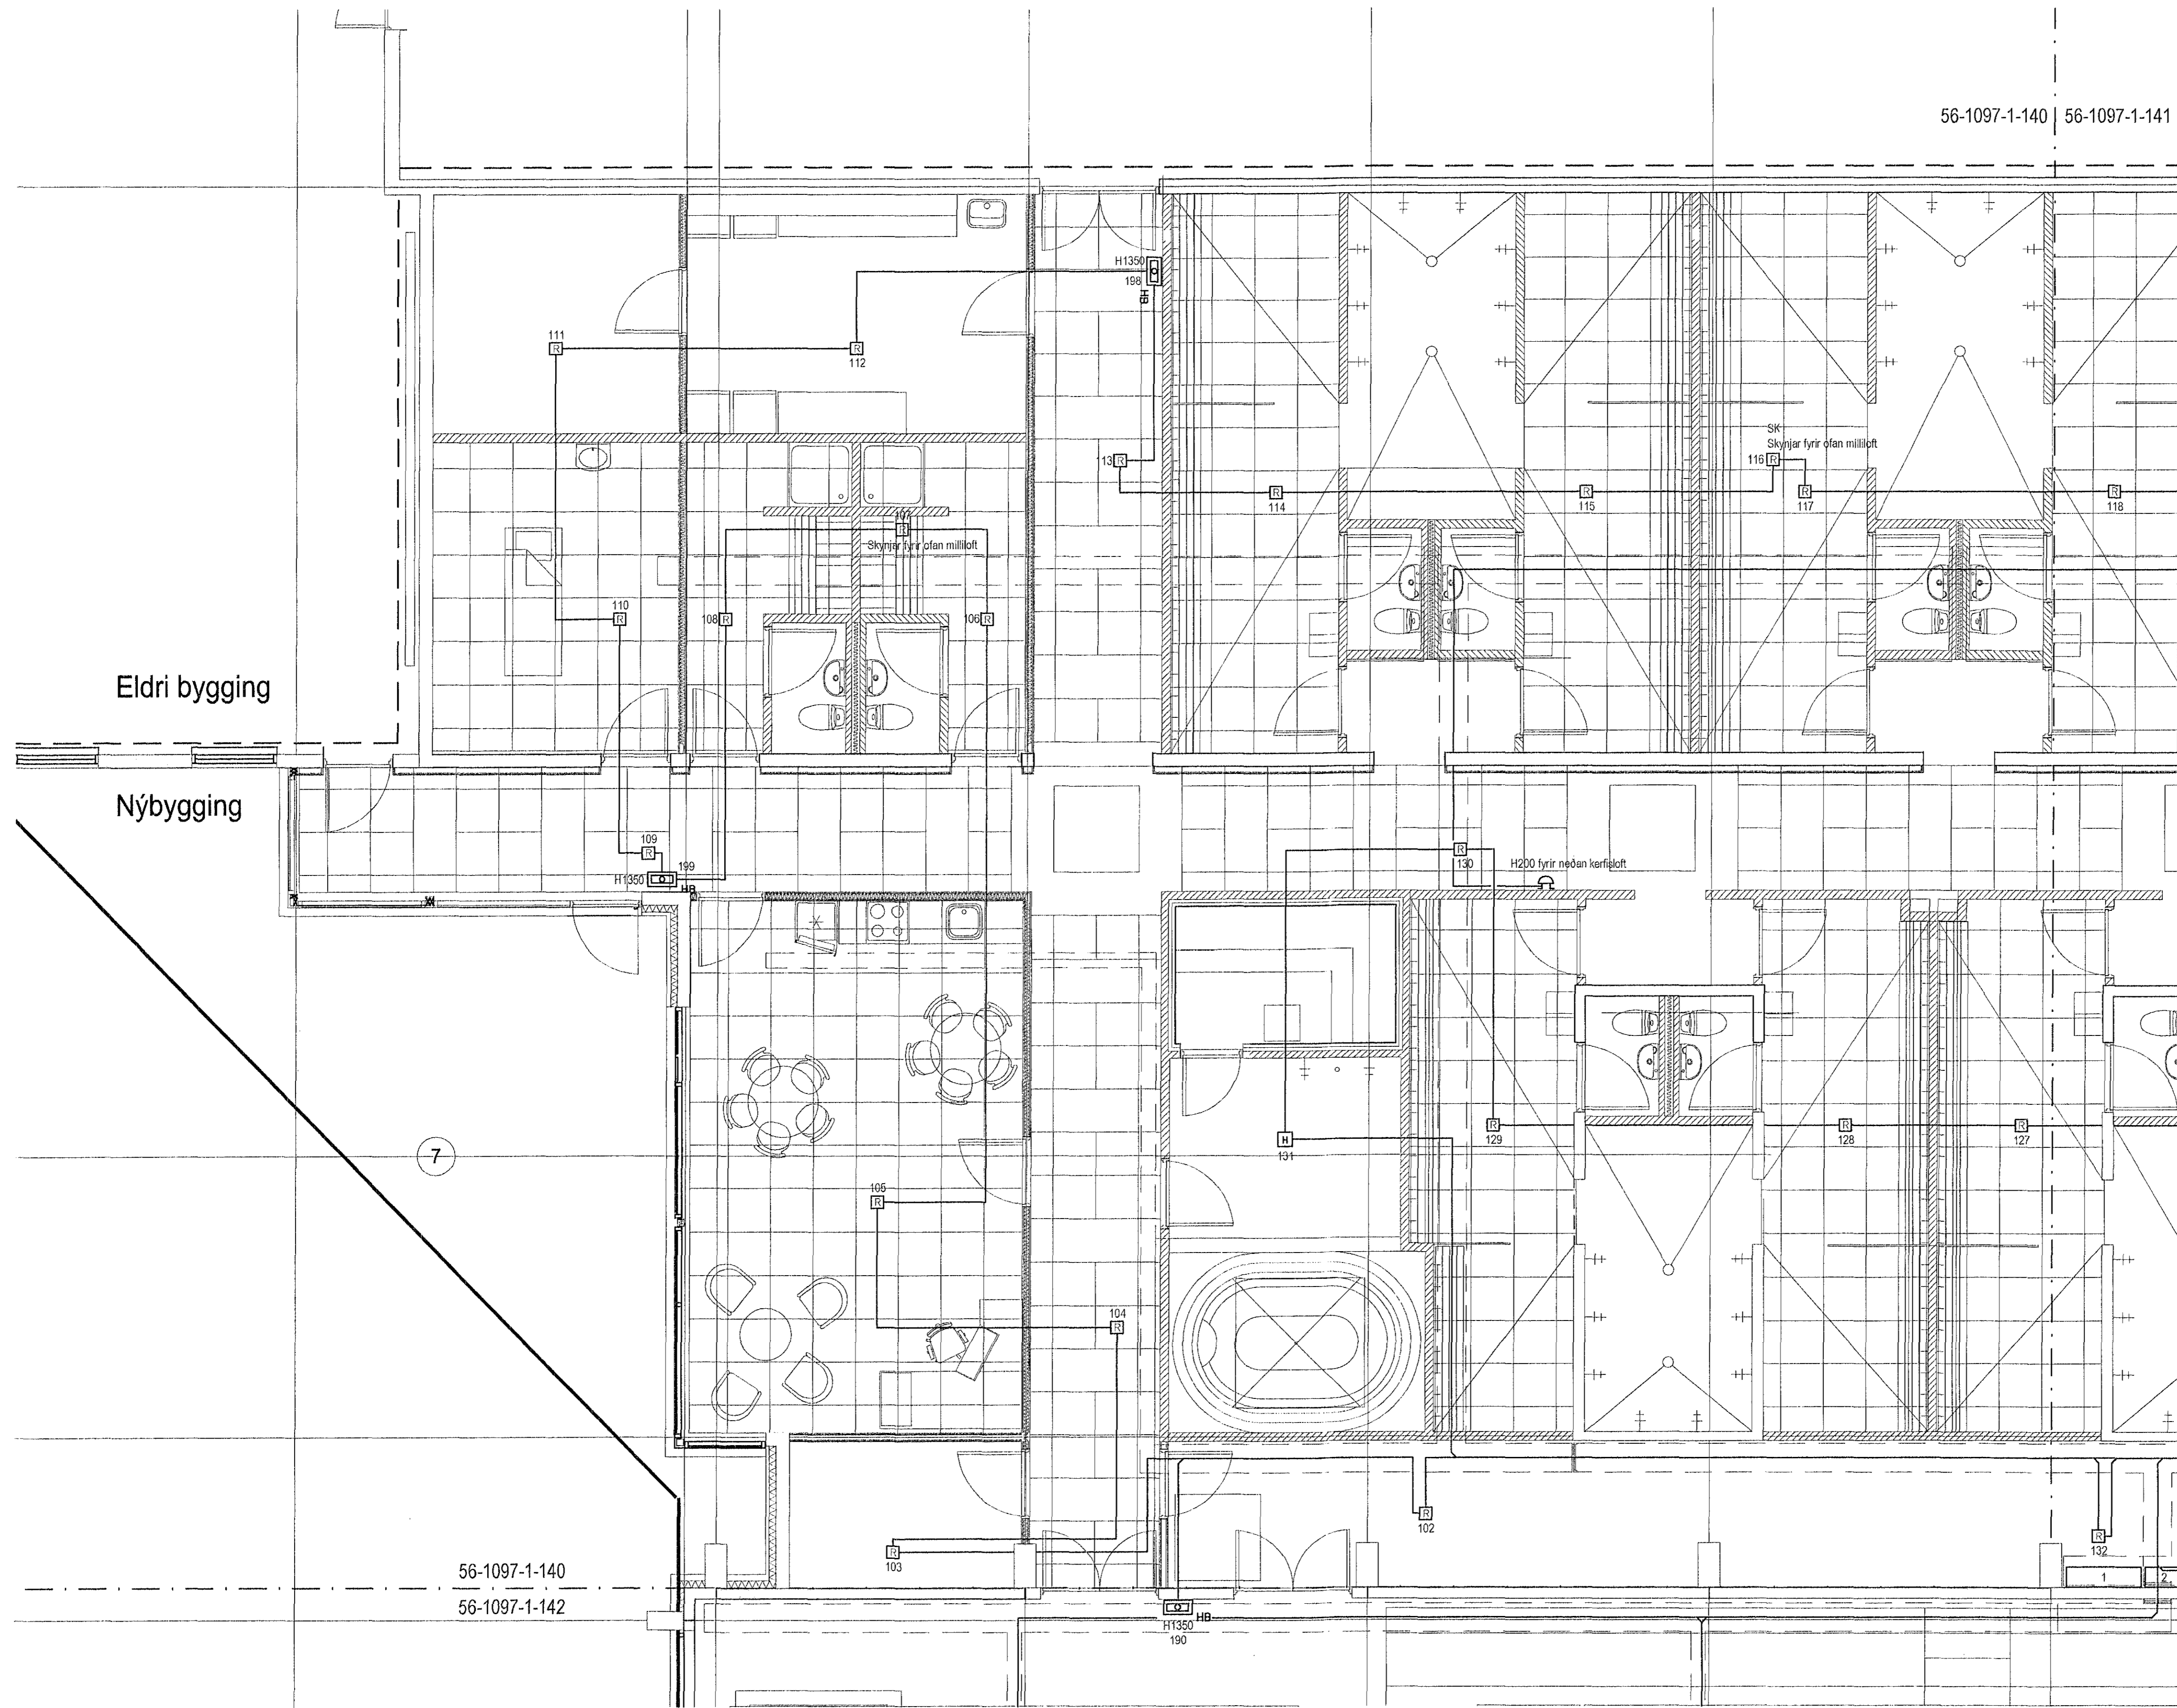

Lykilmynd.

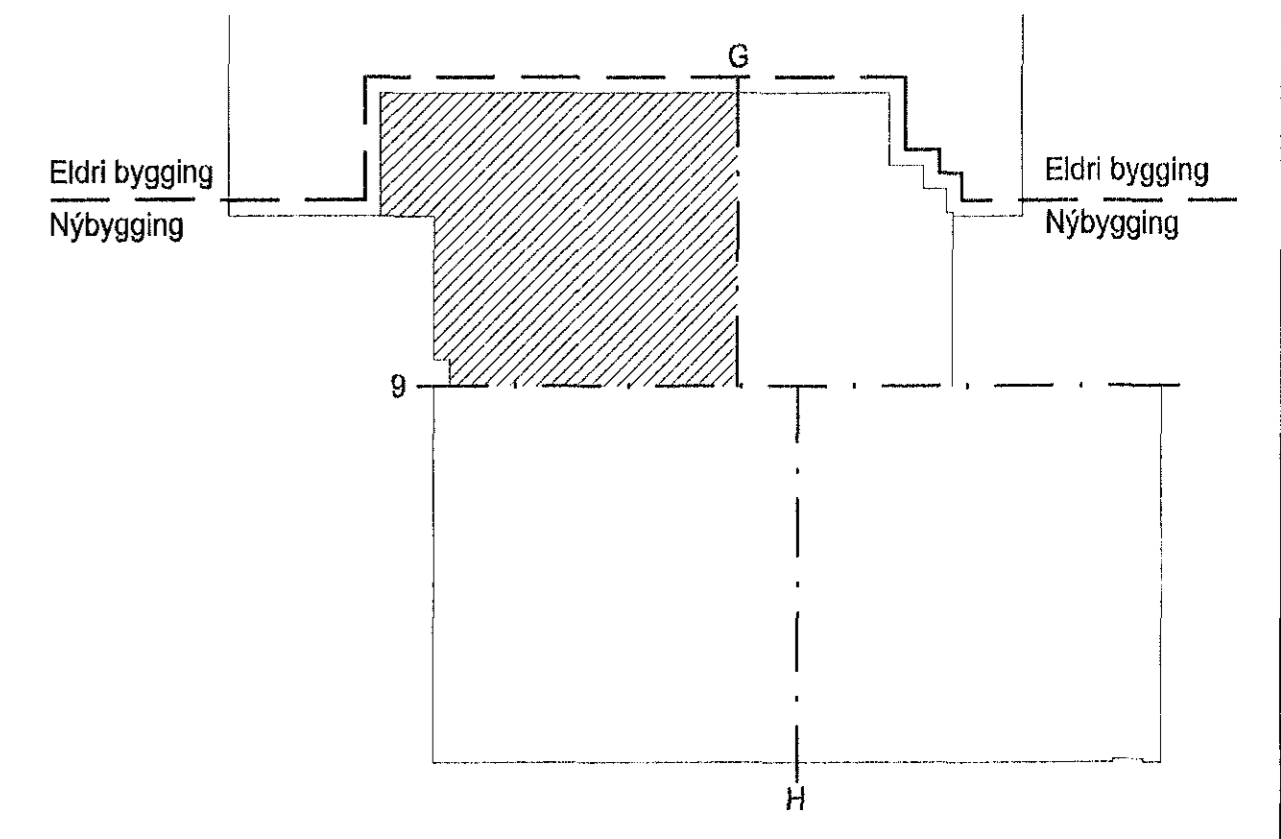

56-1097-1-140
56-1097-1-142

ÍSTAK

<p>FRV vélfræðingur vélfræðingur</p>	<p>BREYTING A DAGS 13.12.2001 Váðastur og breytingar</p>	<p>BREYTING B DAGS 09.01.2002 Breytingar á lagaskil.</p>	<p>BREYTING C DAGS 09.04.2002 REYNDARTEIKNINGAR</p>	<p>BREYTING D DAGS</p>	<p>TEIÐI ags</p>	<p>MYR RTS</p>	<p>TOLUNERI 1097-140, DWG</p>	<p>VERUJERI BJARKARHÚS, HAUKAHRAUNI 1, 220 HAFNARFJÖRÐUR</p>	<p>VERKHLUTI BRUNAVÍÐVÖRUNARKERFI</p>	<p>RAFTÆKNISTOFAN</p>	<p>STAKINGUR 56-1097-1-140</p>
<p>0 5 10 15 20 25 30 cm</p>	<p>MÆLIVASDI 1:50</p>	<p>SAMBYGGI Davíð E. Sólvason Kr. 100356-3339</p>	<p>RAST 520 8900 • 108 REYKJAVÍK 520 8901 • FAX: 520 8901</p>	<p>DAGS 13.11.2001</p>	<p>BREYTI C</p>						