



56-1097-1-140
56-1097-1-142

Skýringar:
SK = Skammhlaupseining

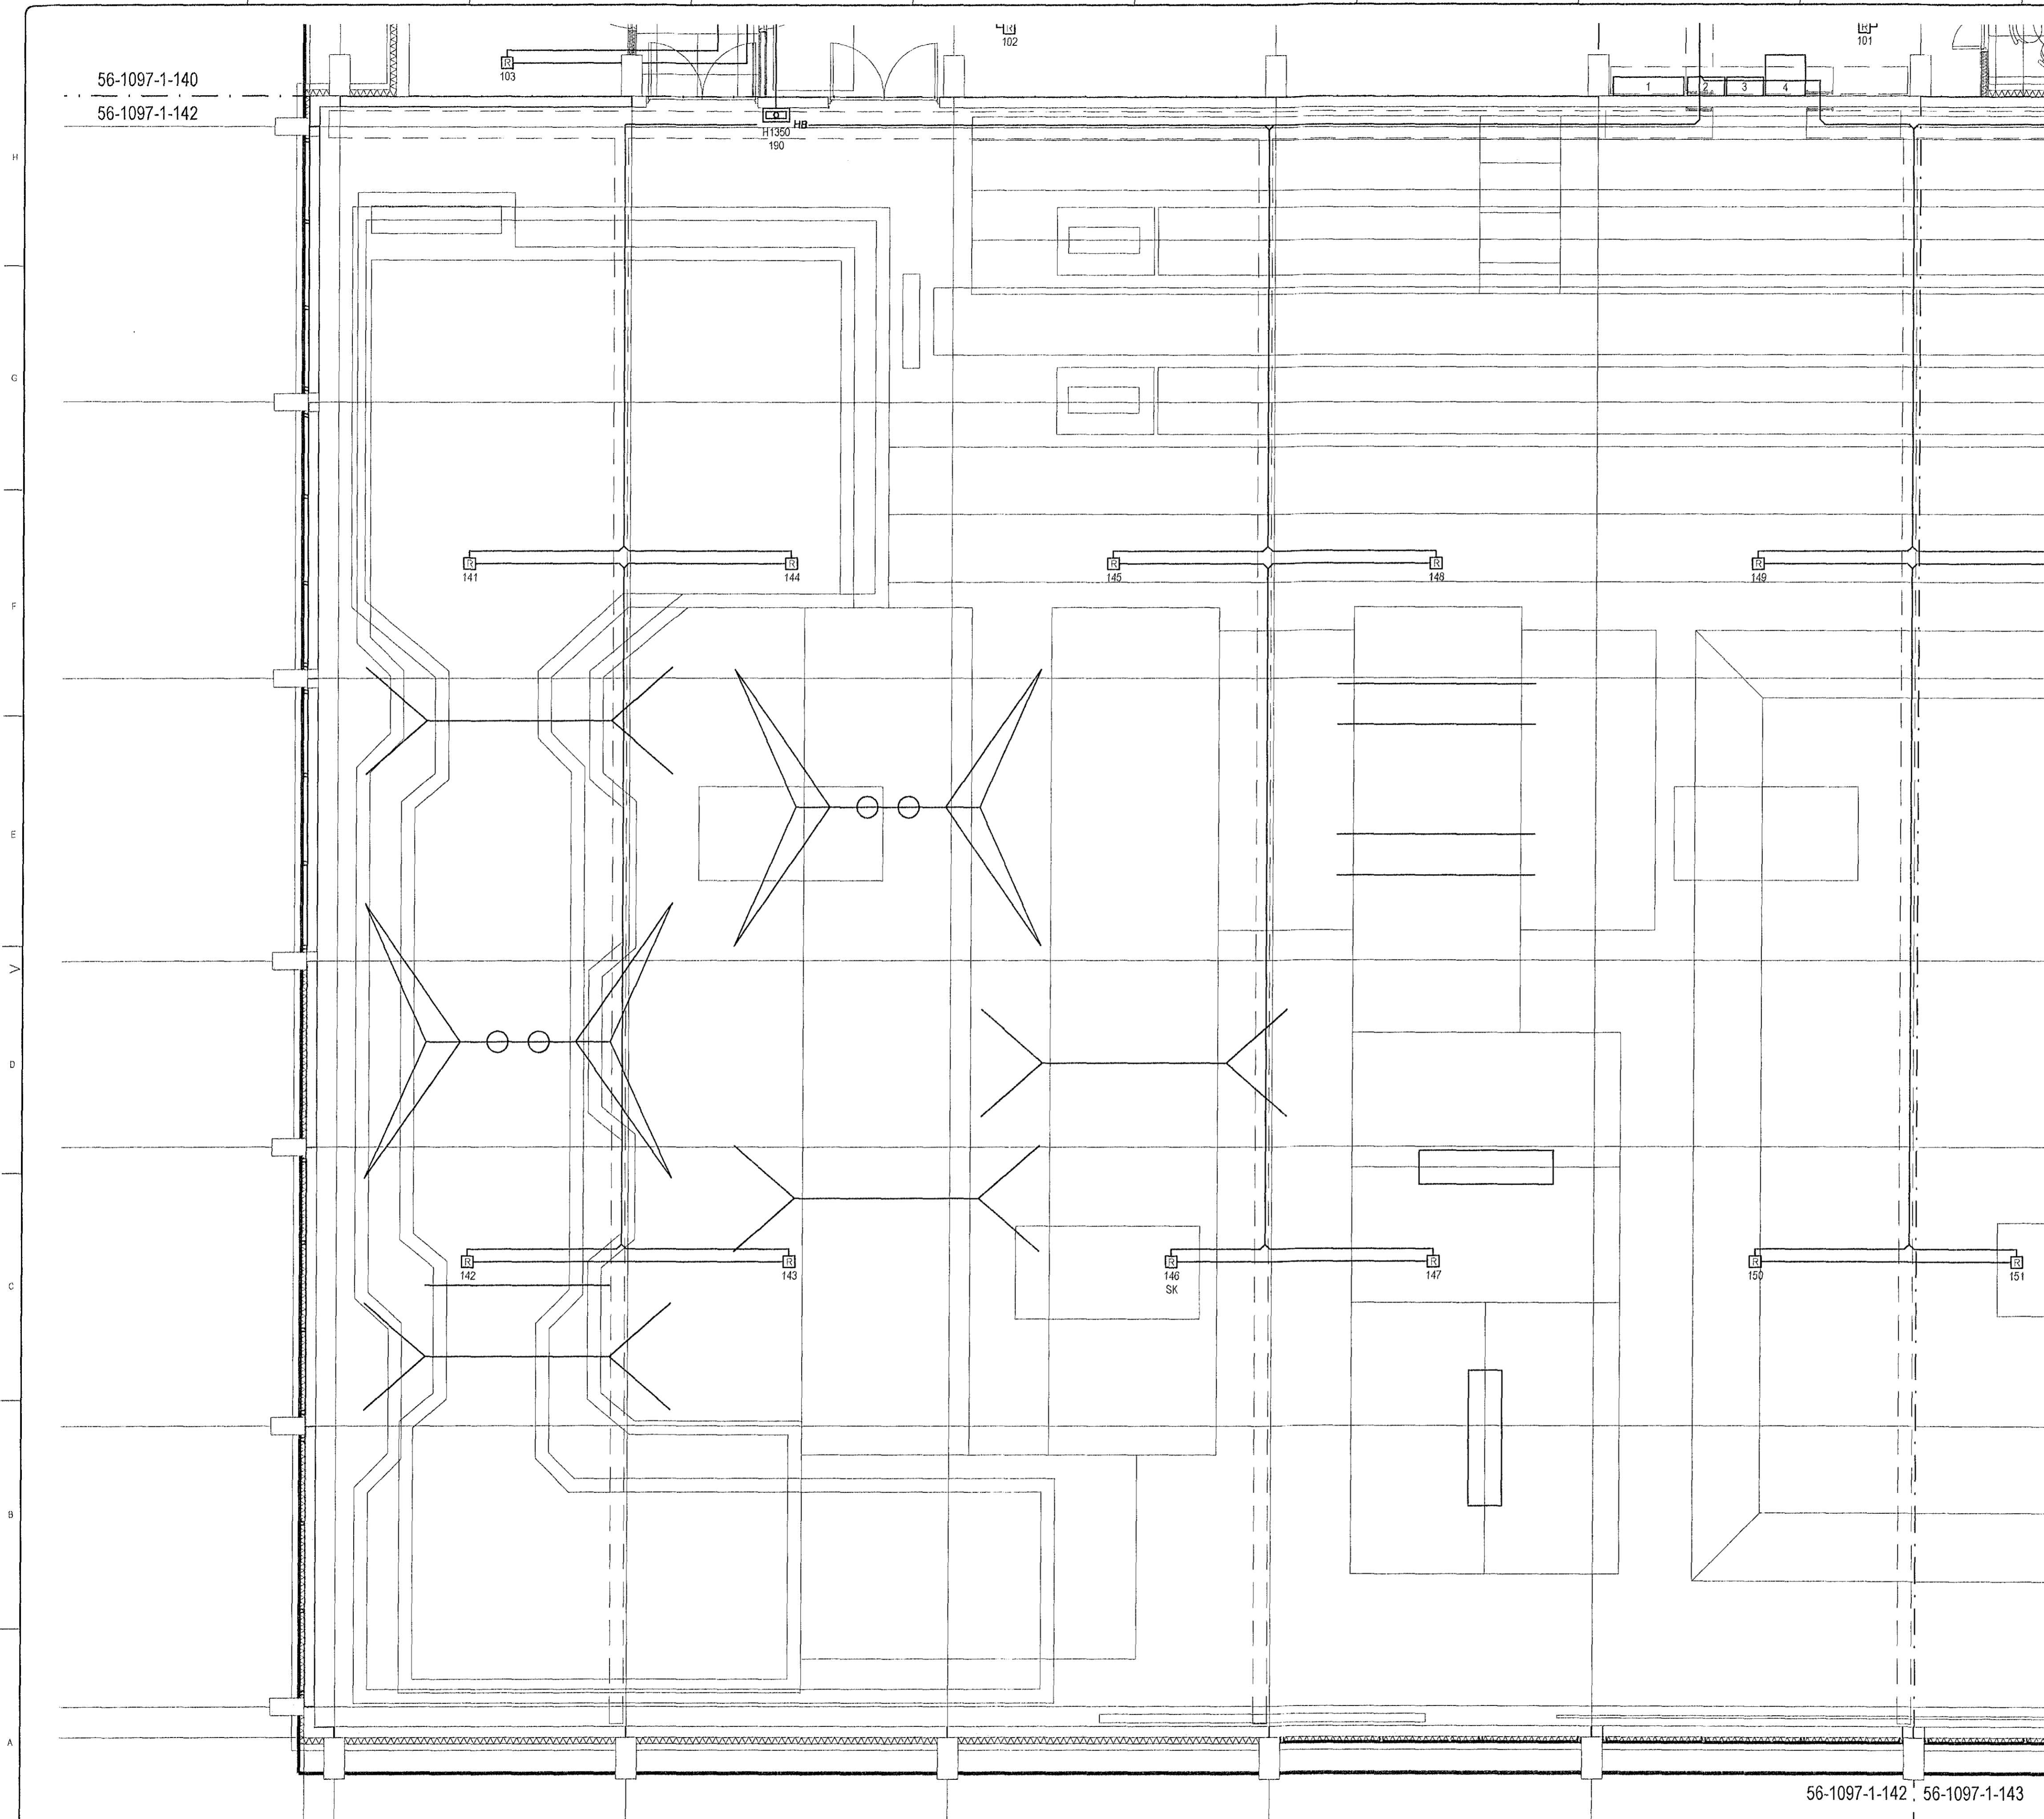

Lykilmynd.

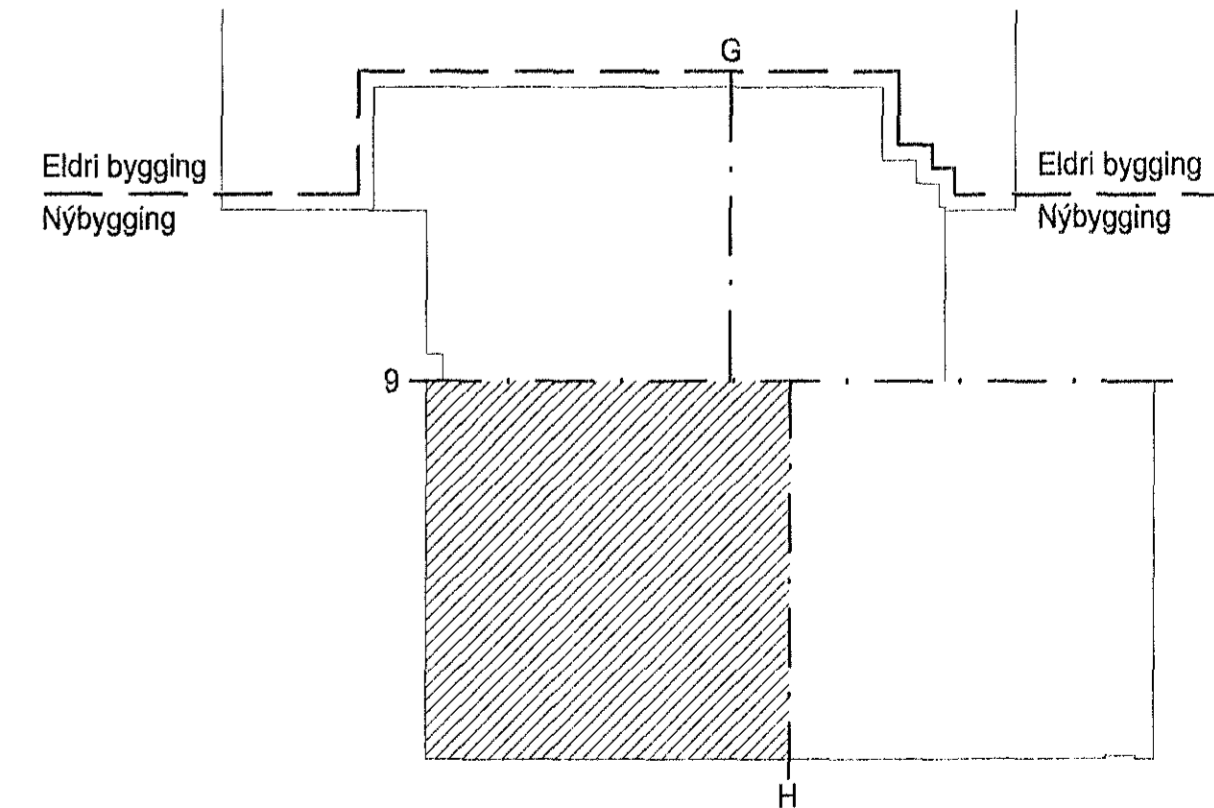

56-1097-1-142 : 56-1097-1-143

ÍSTAK

	BREYTING A DAGS 08.01.2002 Breytingar á tagnaleð	BREYTING B DAGS 09.04.2002 REYNDARTEIKNINGAR	BREYTING C DAGS	BREYTING D DAGS	TEIHNAD egs	FRV RTS	TÖLUNUMER 1097-140 . DWG	VERKHEITI BJARKARHÚS, HAUKAHLAUNI 1, 220 HAFNARFJÖRÐUR		RAFTÆKNISTOFAN	TEIHNAD NÚM 56-1097-1-142
	MÆLISKILGJAFUR 0 5 10 15 20 25 30 cm	MÆLIVARPI 1:50	SAUVYKJAFI Davíð E. Sölvason Kt. 100356-3339	VERKHEITI BRUNAVIÐVÖRUNARKERFI	MÁNAÐ egs	GRENSÁSVÆGUR 3 • 108 REYKJAVÍK 520 9900 • FAX: 520 9901	DAGS 13.12.2001	BREYTI B			