



56-1097-1-150
56-1097-1-152

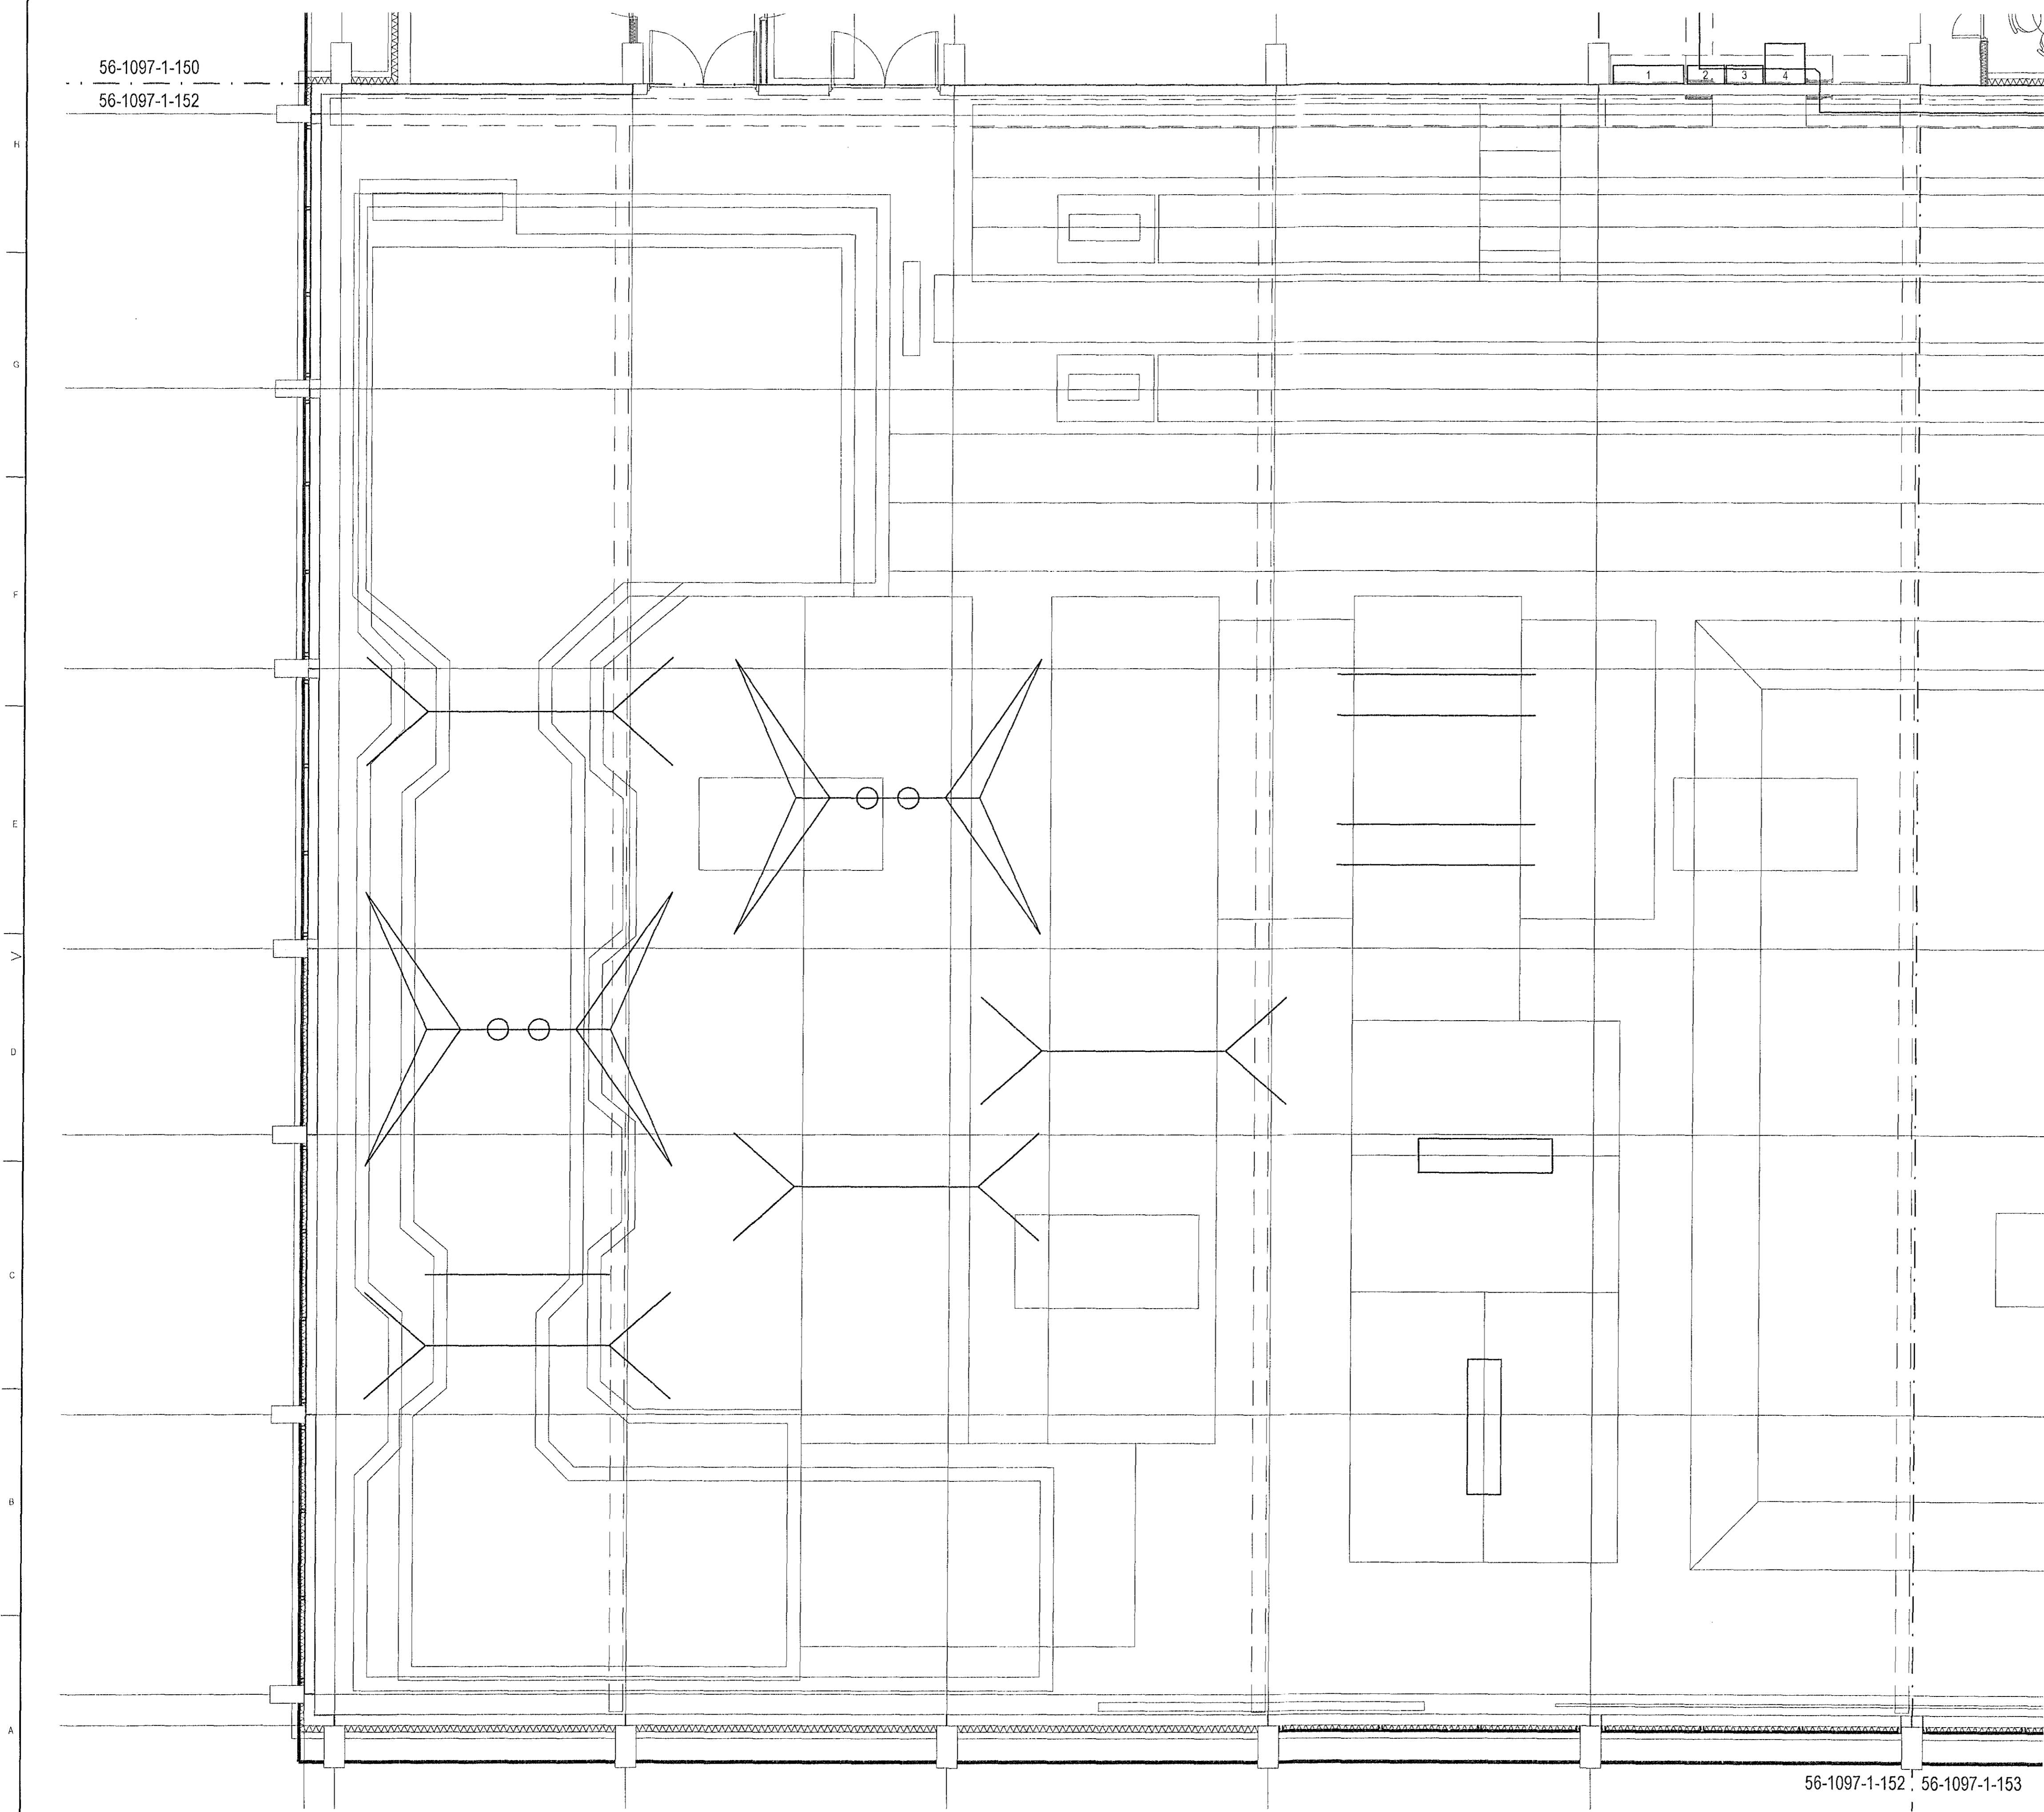

56-1097-1-152 56-1097-1-153

Lykilmynd.

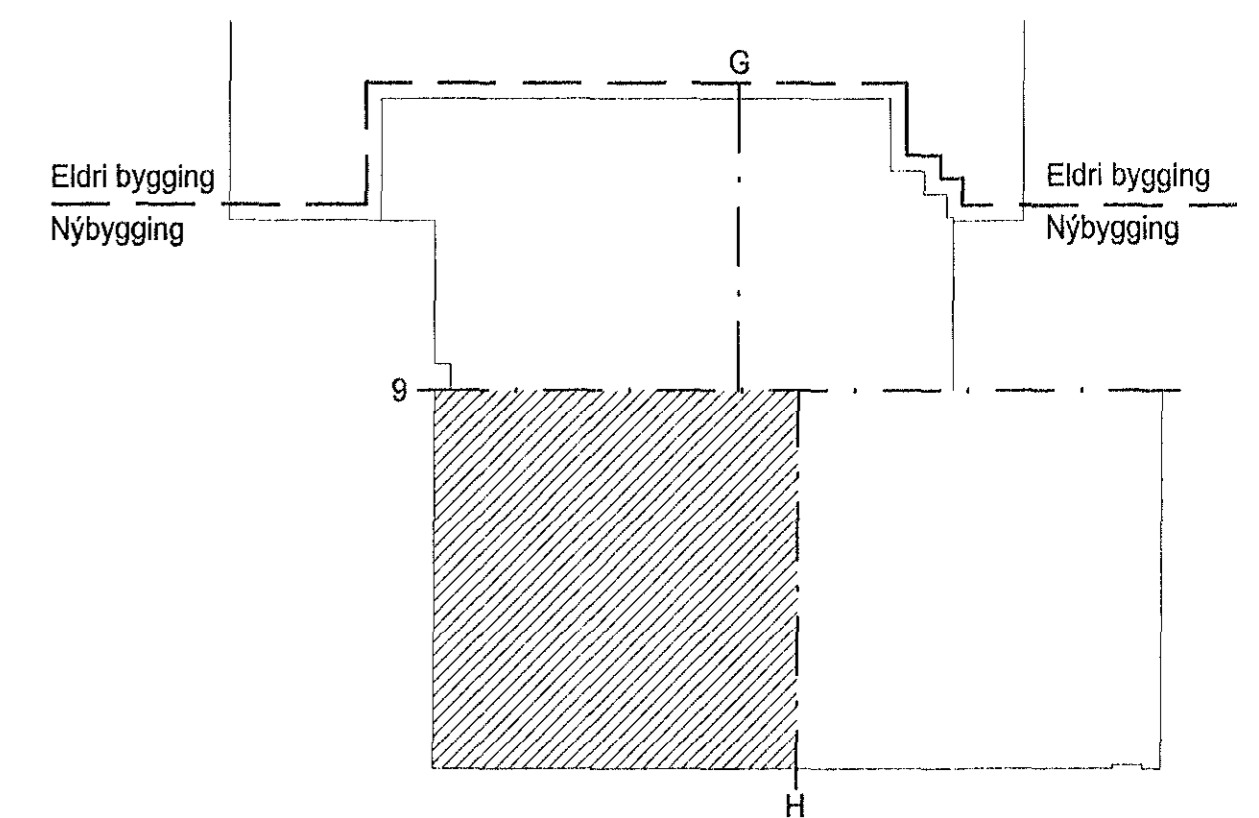

ÍSTAK

	BREYTINGA DAGS 08.01.2002 Breytingar á lagningu	BREYTINGD DAGS	BREYTINGC DAGS 9.04.2002 REYNDARTEIKNINGAR	BREYTINGD DAGS	TEIKNND BGS	VERF RTS	TÖLVUHEITI 1097-150 . DWG	VERKHETI BJARKARHÚS, HAUKAHLAUNI 1, 220 HAFNARFJÖRDUR		TEIKNINGUR RAFTÆKNISTOFAN	TEIKNINGUR 56-1097-1-152
	MÆLISTOKUR B	MÆLIKVAÐI 1:50	SAMPRYKT Davíð E. Sólvason Kr. 100356-3339	VERKHETI TÖLVU- OG SIMLAGNIR	MAHNAÐ BGS	GRENSÁSVÆGUR 3 • 108 REYKJAVÍK TÖL 520 8900 • FAX: 520 8901	DAGS 13.12.2001	BREYTI B			