



56-1097-1-160 | 56-1097-1-161

Eldri bygging

Nýbygging

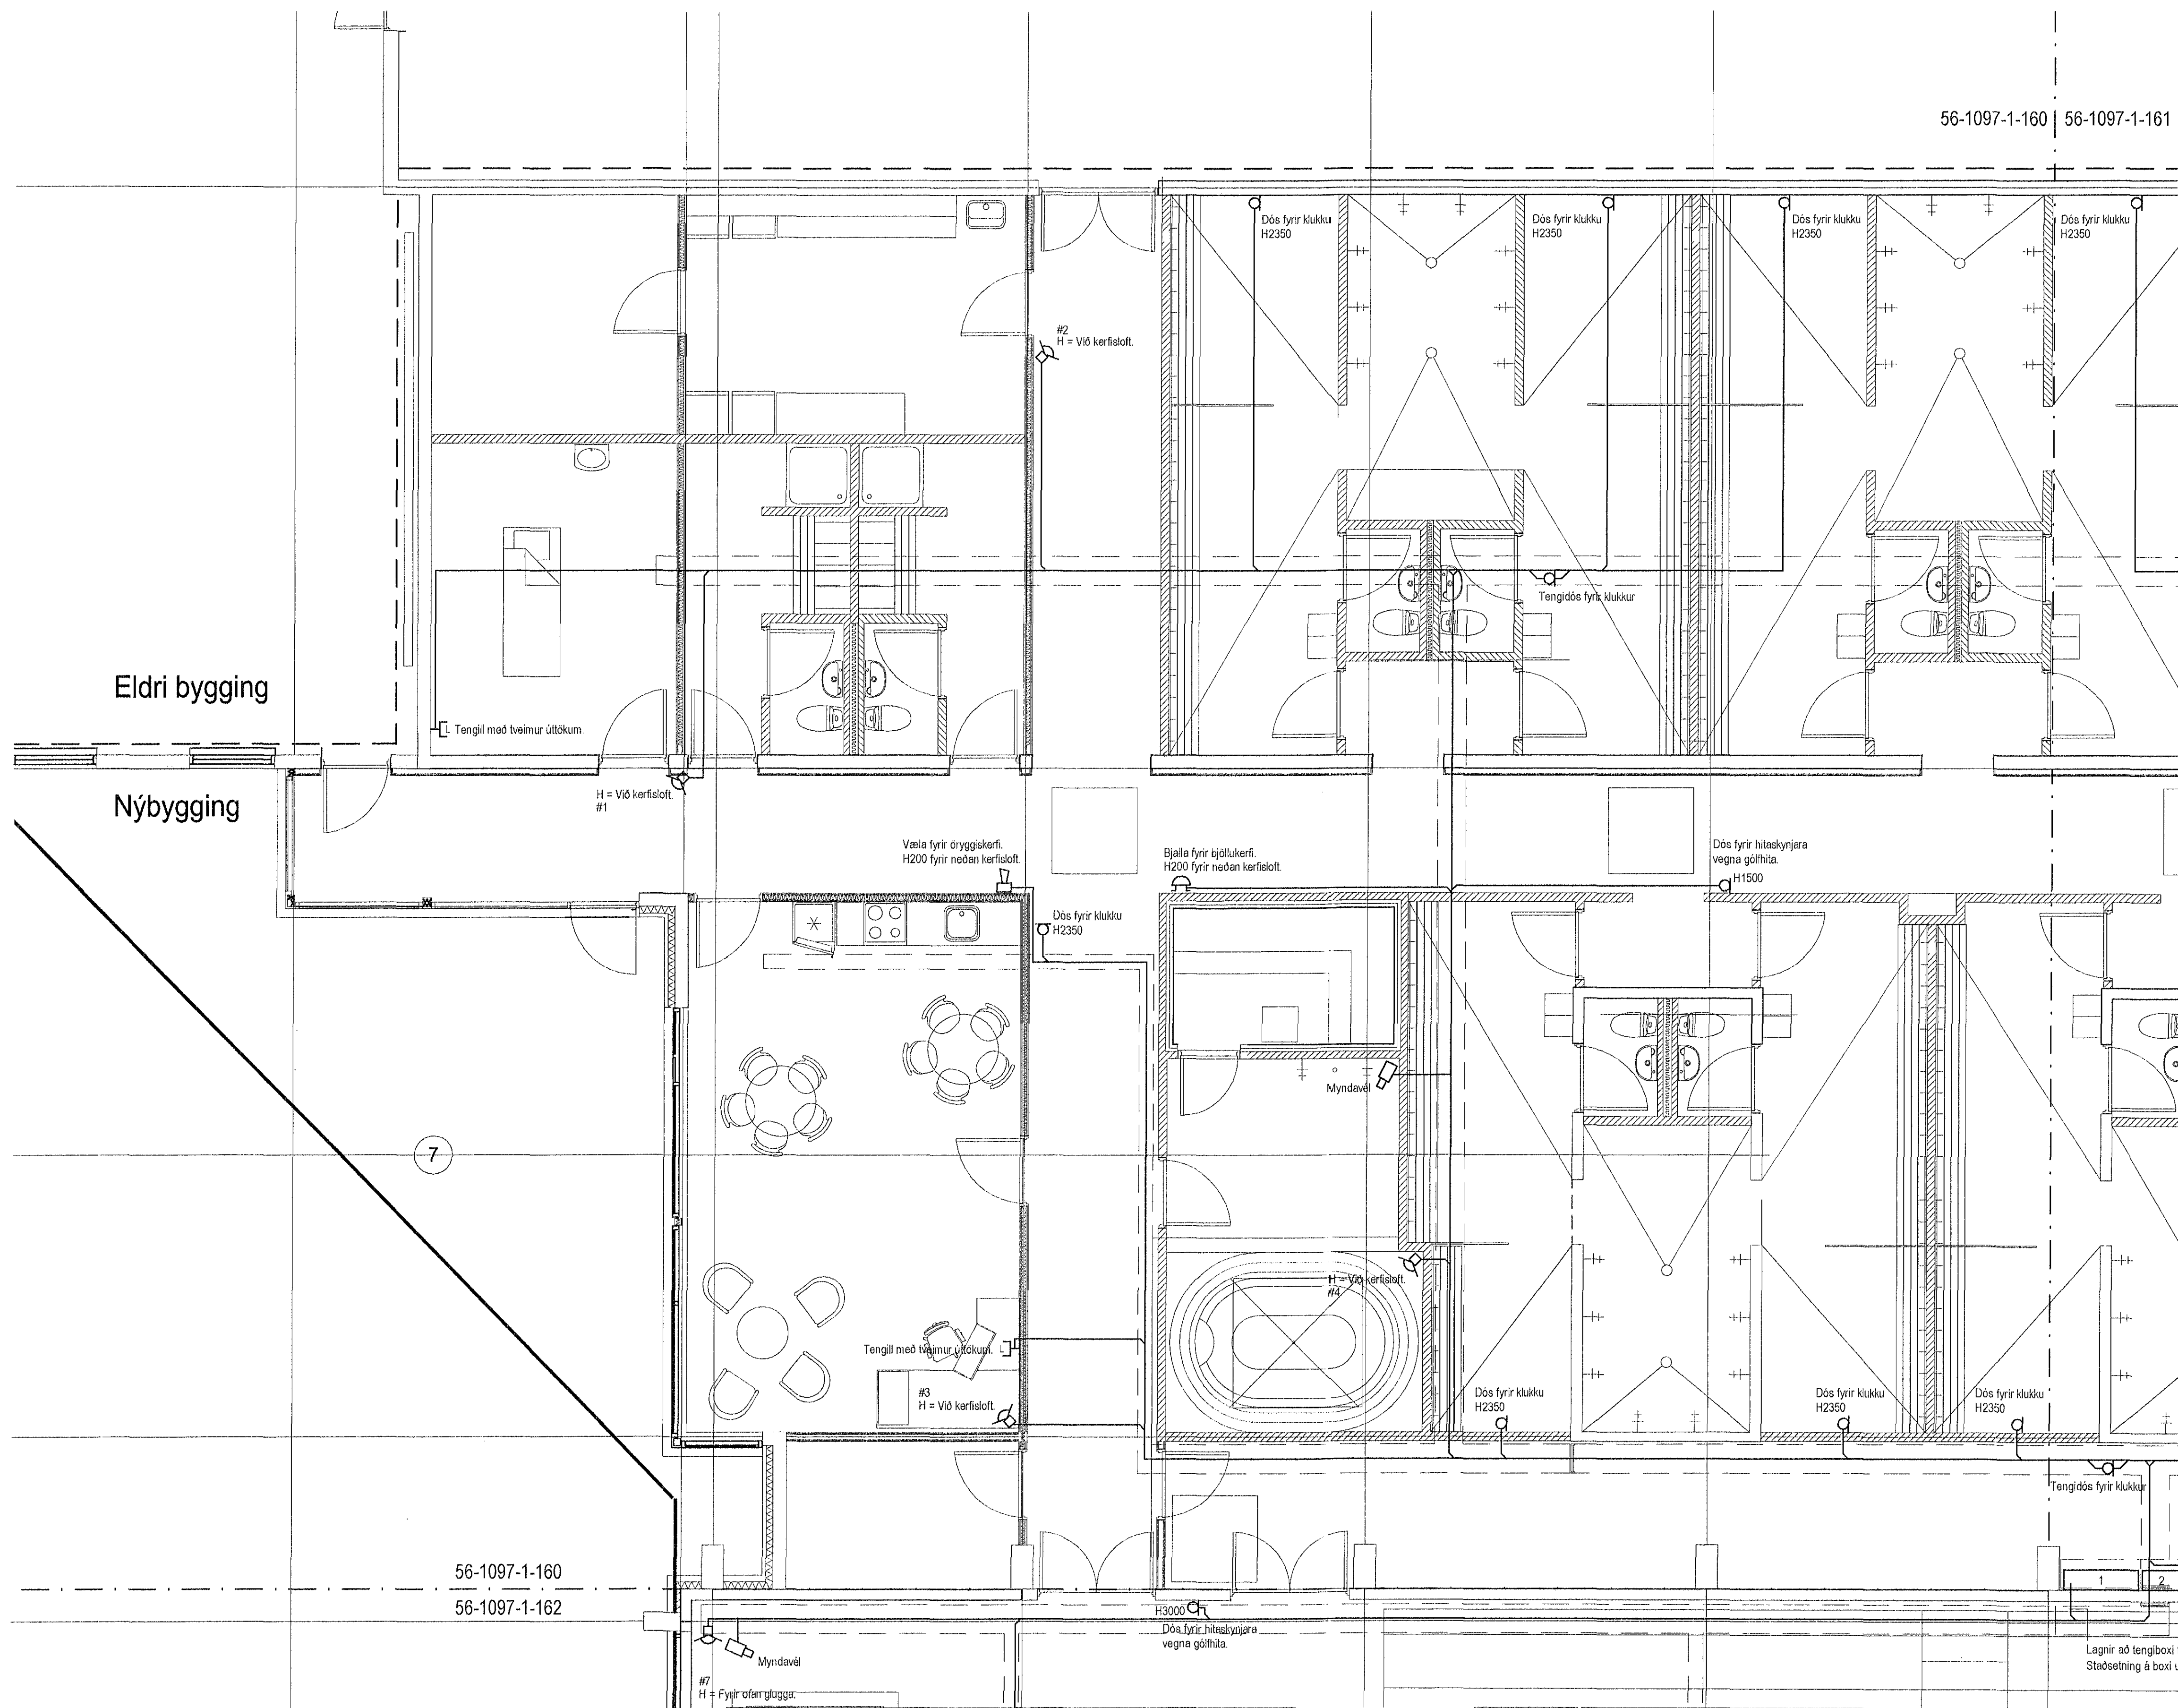

Lykilmynd.

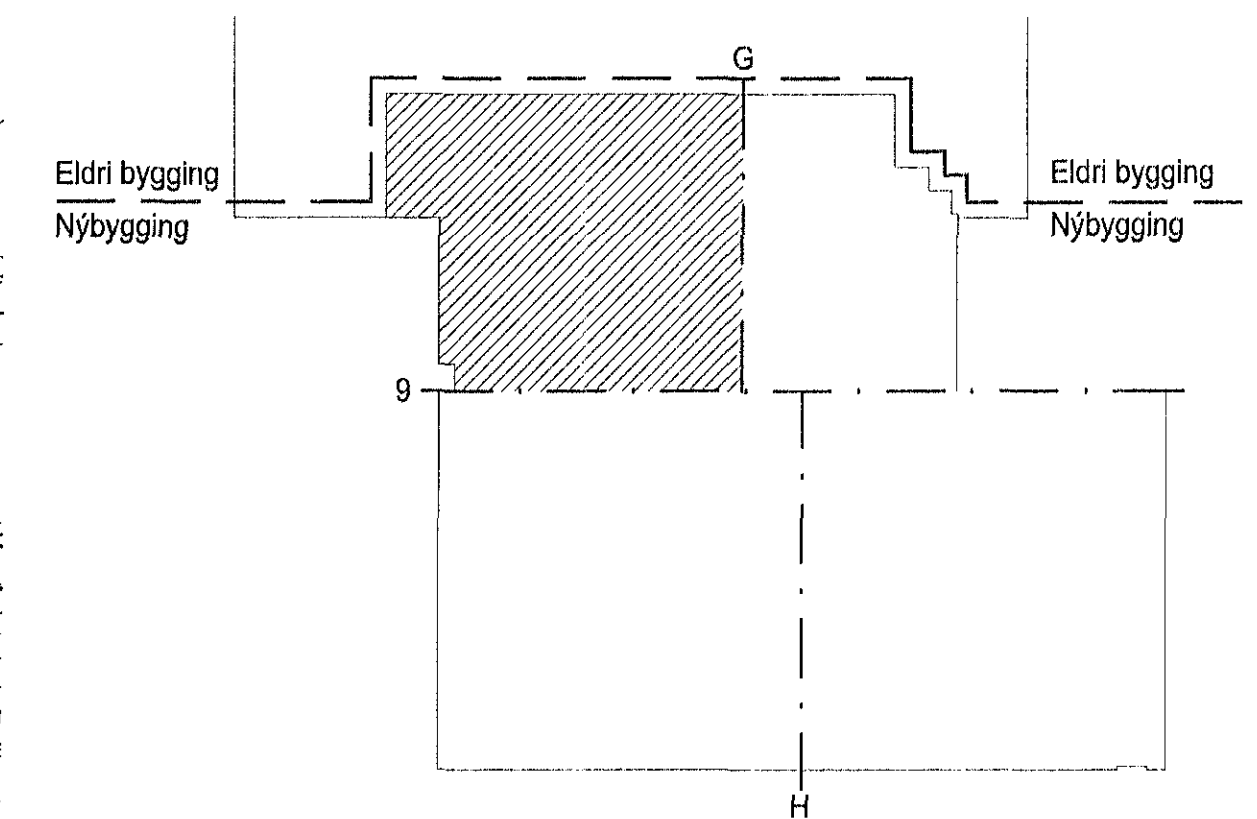

56-1097-1-160

56-1097-1-162

ISTAK

	BREYTING A DÁGS 08.11.2002 Váðastufl og breytingar	BREYTING B DÁGS 09.04.2002 REYNDARTEIKNINGAR	BREYTING C DÁGS	BREYTING D DÁGS	TEIKNAR ags	YFRIF RTS	TÖLVUREIT 1097-160 . DWG	VERKHETI BJARKARHÚS, HAUKAHRUNI 1, 220 HAFNARFJÖRDUR		RAFTÆKNISTOFAN	56-1097-1-160
	MELISTOKUR	MELIHWAFI 1:50	SAMBYKKT Davíð E. Sölvason Kt. 1100354-3339	VERKHETI SMÁSPENNULAGNIR	HANDB ags	GRENÁSVEGUR 3 • 108 REYKJAVÍK 520 9900 • FAX: 520 9901	DÁGS 13.12.2001	BREYTI B			