


56-1097-1-160 | 56-1097-1-161

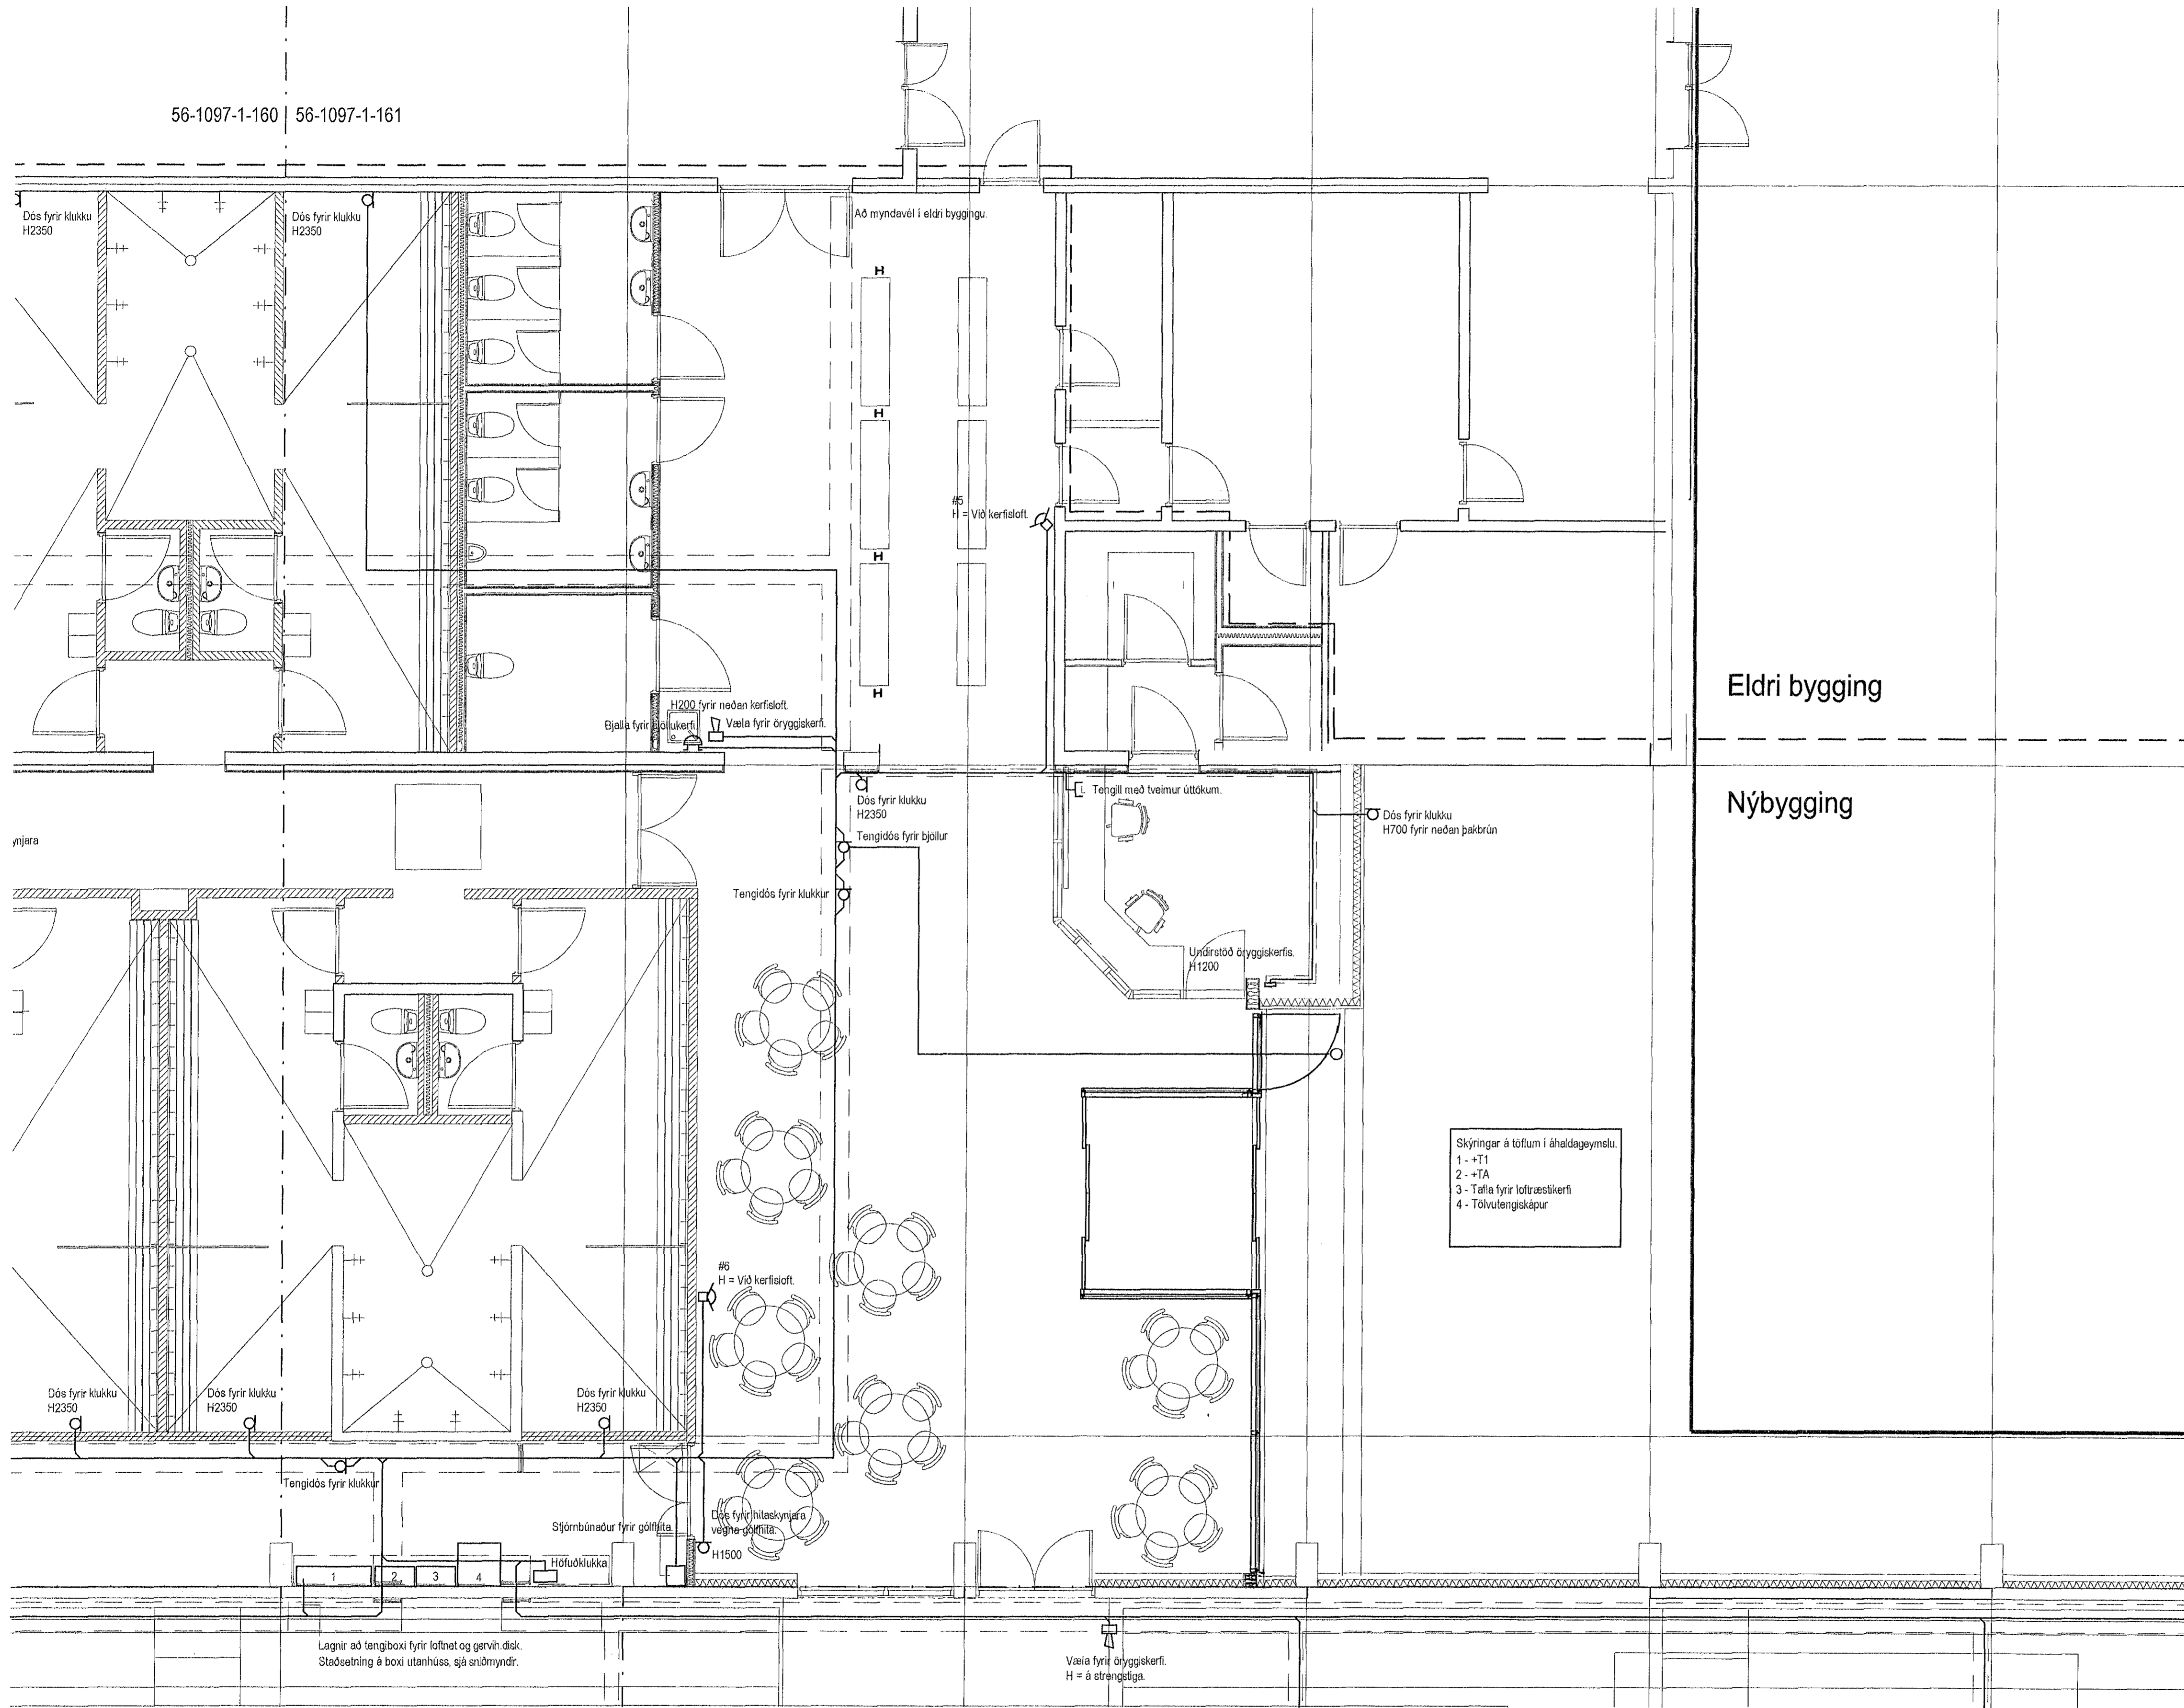


Eldri bygging

Nýbygging

Skýningar á tolfum í áhaldagemyndu
 1 - T1
 2 - TA
 3 - Talla fyrir loftresbíerfi
 4 - Tölvutengiskápur

Lykilmynd.

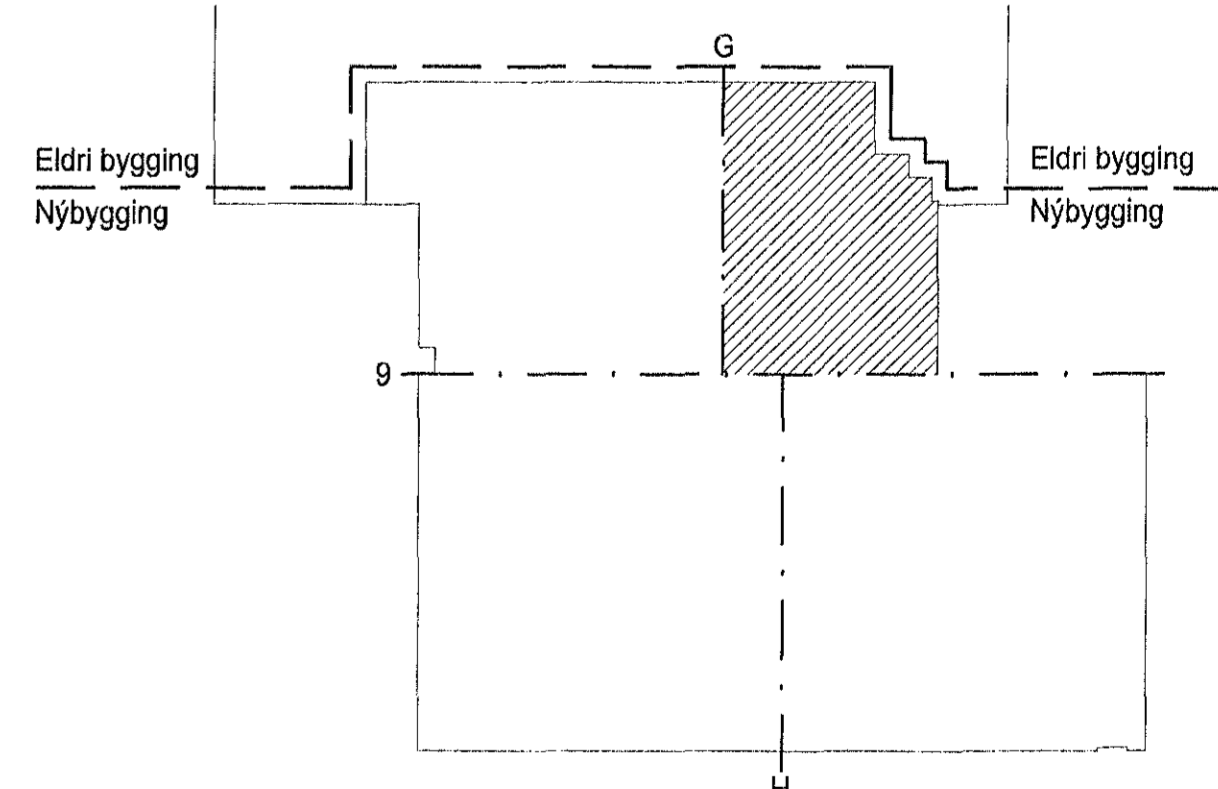

ÍSTAK

	BREYTING A DAGS: 08.01.2002 Viðbætur og breytingar	BREYTING B DAGS: 09.04.2002 REYNDARTEIKNINGAR	BREYTING C DAGS:	BREYTING D DAGS:	TEIKNAD ags	YFIRF RTS	TÖLVUHEITI 1097-160 . DWG	VERKHÉITI BJARKARHÚS, HAUKAHRAUNI 1, 220 HAFNARFJÖRÐUR		TEIKNING NR 56-1097-1-161
MELISTIGOUR 0 5 10 15 20 25 30 cm	MELIKVARN 1:50	SMÁMYNKA Davíð E. Sölvason Kt. 100356-3339	VERKHEITI SMÁSPENNULAGNIR	TÍMUNAD ags	GRENÁSVEGUR 3 • 108 REYKJAVÍK 520 9900 • FAX: 520 9901	DAGS 13.12.2001	BREYTI B			