



56-1097-1-160
56-1097-1-162

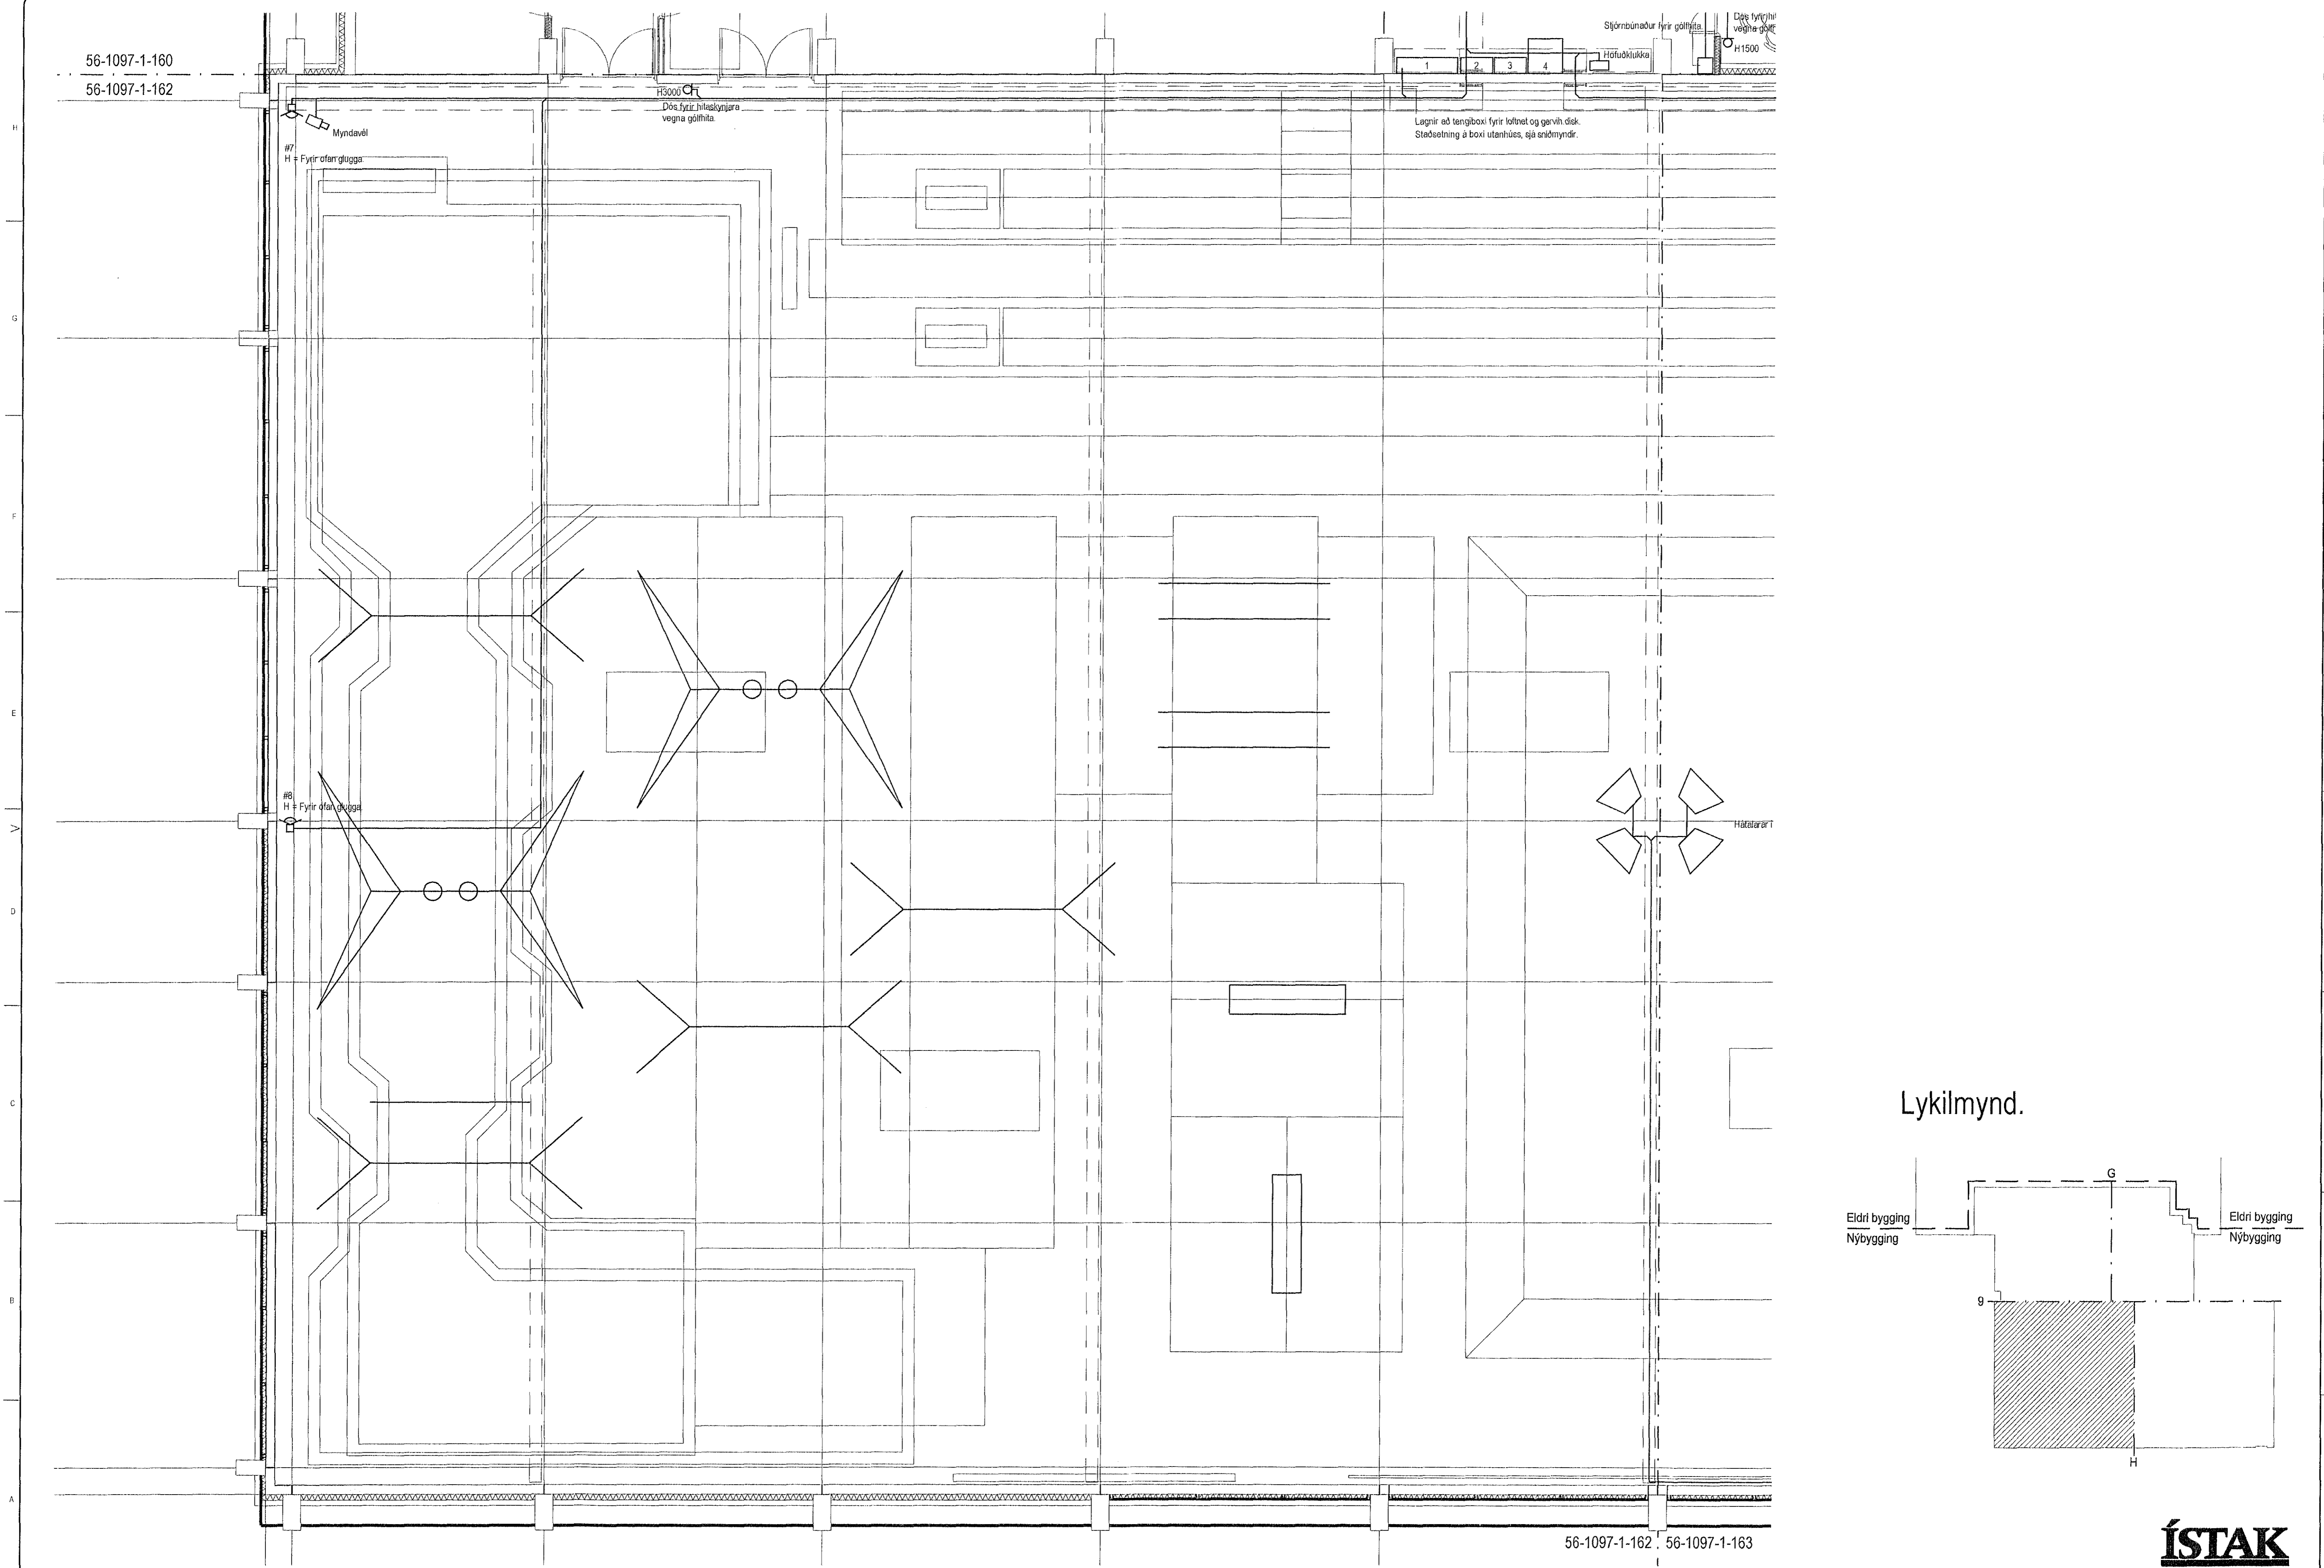

Lykilmynd.

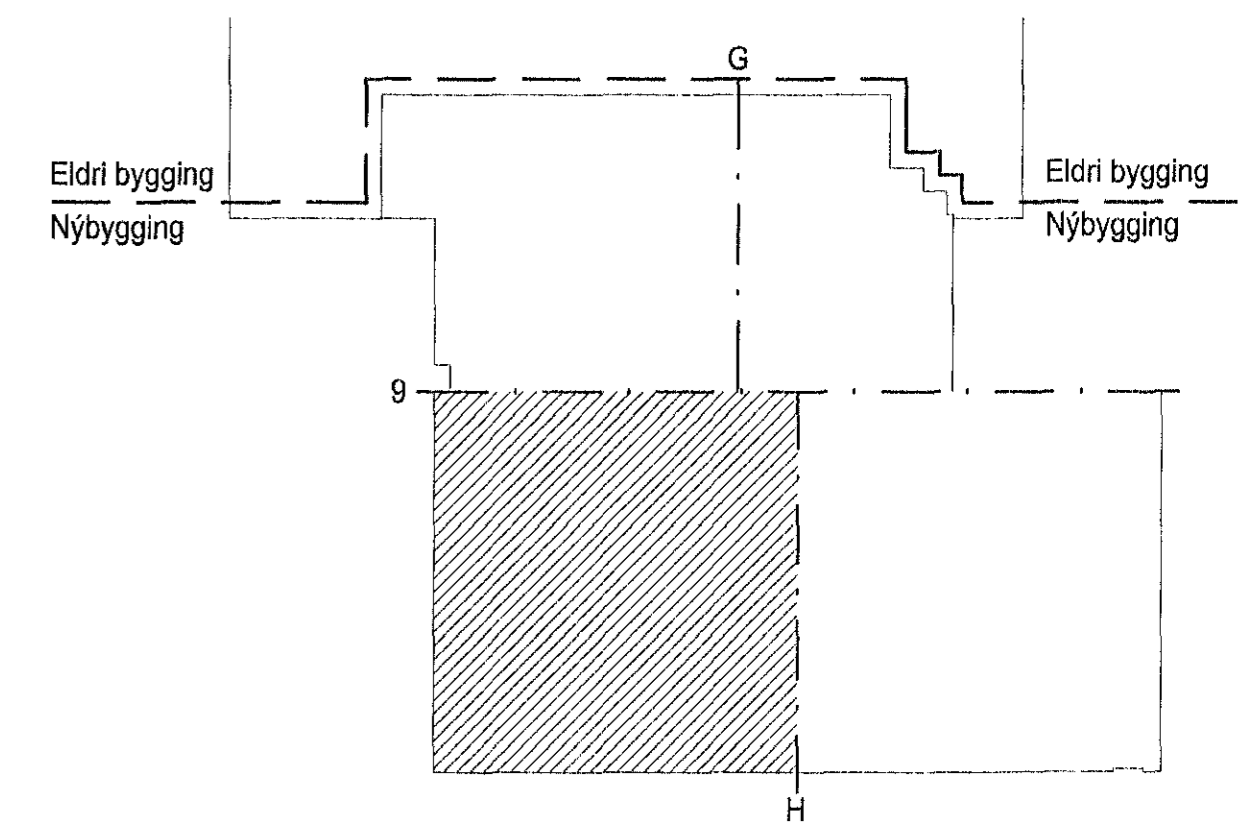

56-1097-1-162 . 56-1097-1-163

ÍSTAK

	BREYTINGA DAGS: 08.01.2002 VÍÐAÐUR OG Breytingar	BREYTINGB DAGS: 09.04.2002 REYNDARTESNINGAR	BREYTINGC DAGS:	BREYTINGD DAGS:	TEKIÐ ags	VYRÐ RTS	TÖLVUNGT 1097-110 . DWG	VERKHEITI BJARKARHÚS, HAUKAHLAUNI 1, 220 HAFNARFJÖRÐUR	TERNINGAR 56-1097-1-162
	MELISTOKUR 	MÆLIKVÆÐI 1:50	SAMBYGGI Davíð E. Sölvason Kt. 100356-3339	VERKJULI SMÁSPENNULAGNIR	HANNAÐ ags	GRENSÁSVÉGUÐUR 3 • 108 REYKJAVÍK 520 9900 • FAX: 520 9901	TÍÐI 13.12.2001	BREYTT B	