


Lykilmynd.

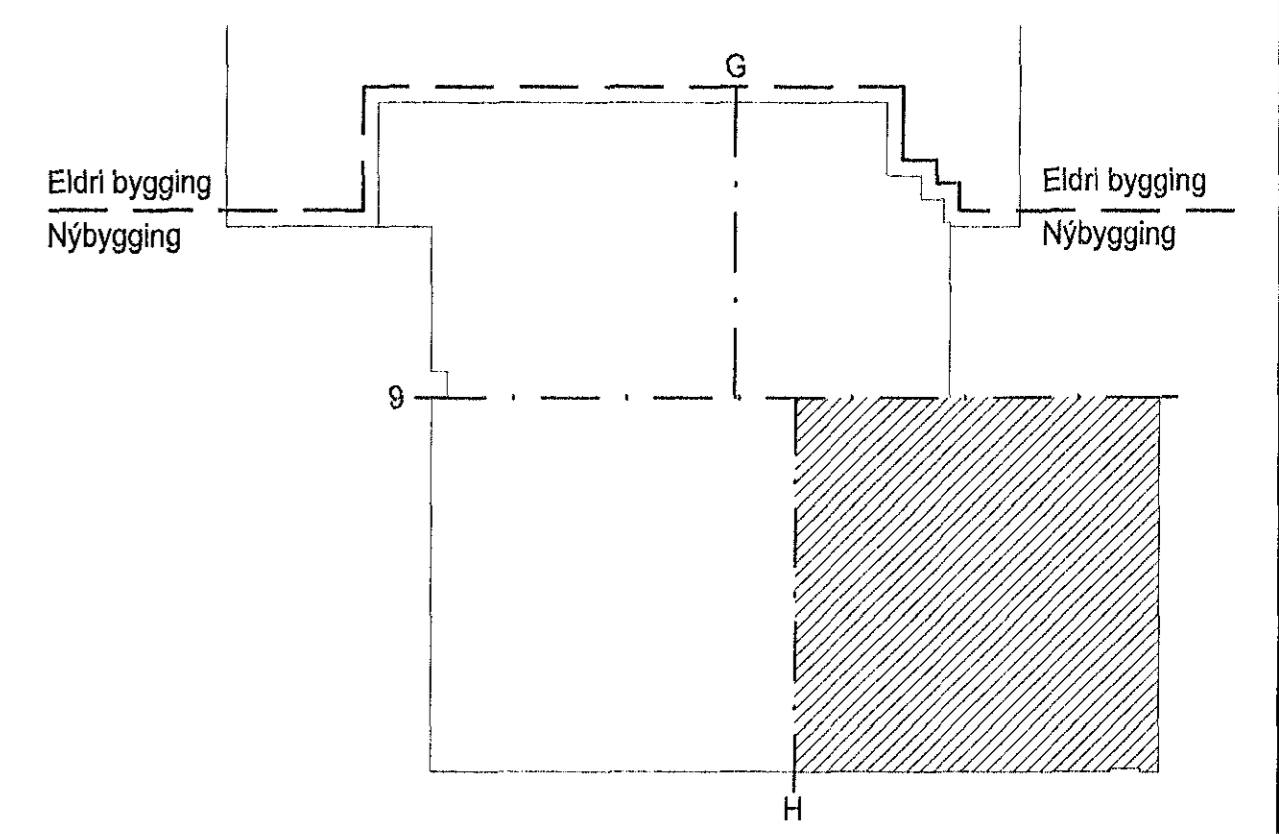

**ÍSTAK**

	BREYTING A DÁGS 05.01.2002 Vöðubatur og breytingar	BREYTING B DÁGS 09.04.2002 REYNDARTEKNIINGAR	BREYTING C DÁGS	BREYTING D DÁGS	TEIKNAR ags	YFRF RTS	TÖLVAHEIT 1097-160 . DWG	VERKHEIT BJARKARHÚS, HAUKAHAUONI 1, 220 HAFNARFJÖRÐUR		TEIKNINGAR <b>RAFTÆKNISTOFAN</b>	TEIKNINGAR <b>56-1097-1-163</b>
	MÆLIKURSEI 1:50	SAMÞYKKT <b>Davíð E. Sölvason</b> Kr. 100356-3339	VERKJULI SMÁSPENNULAGNIR	TUNNING ags	GRENSÁSVEGUR 3 • 108 REYKJAVÍK 520 9900 • FAX: 520 9901	DÁGS 13.12.2001	GREYI B				