


Lykilmynd.

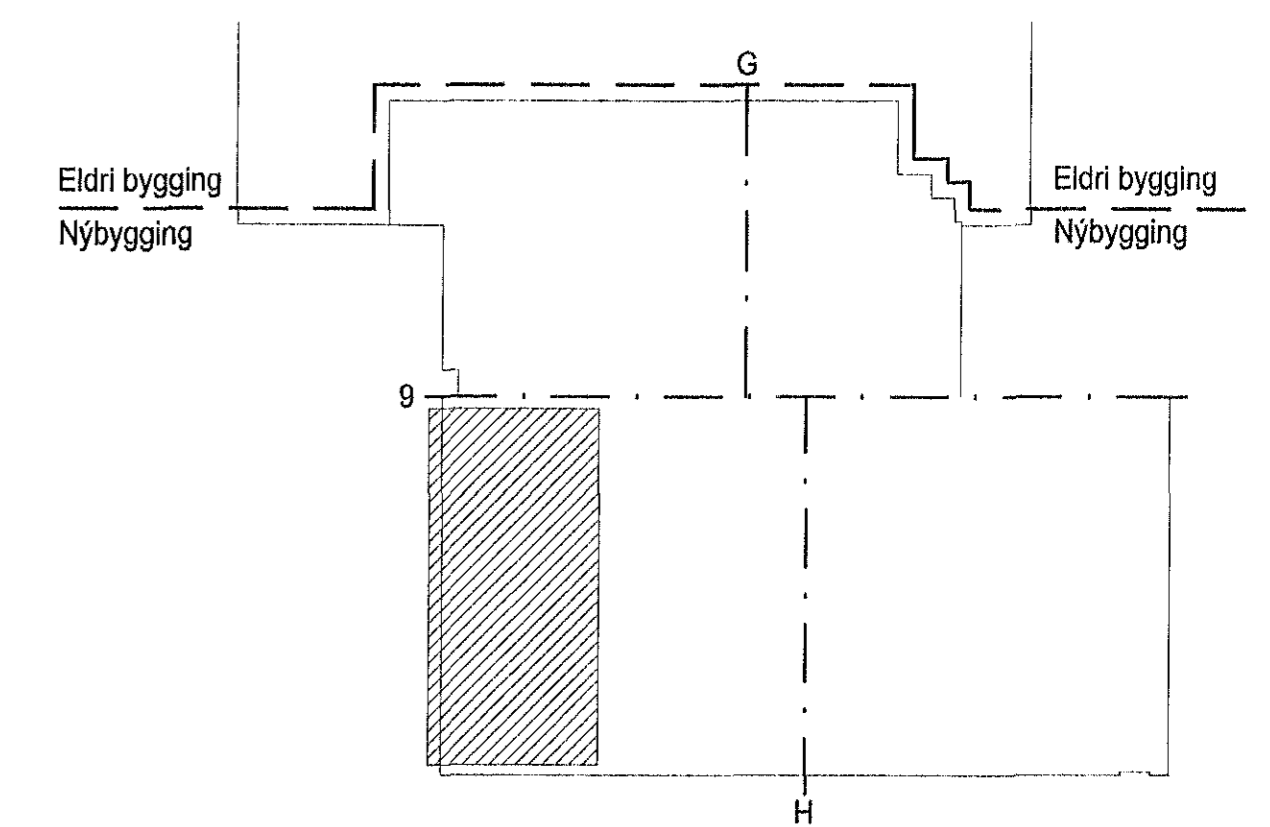

**ÍSTAK**

	BREYTING A DAGS: 19.02.2002 Textabreyting	BREYTING B DAGS: 29.04.2002 REYNDARTEKNIÐSAR	BREYTING C DAGS:	BREYTING D DAGS:	TEKNAÐ ags	YFRF RTS	TÖLVUNUMER 1097-210 . DWG	VERKHEFTI BJARKARHÚS, HAUKAHRAUNI 1, 220 HAFNARFJÖRÐUR		RAFTÆKNISTOFAN	HEFNINGAR 56-1097-1-310
	MÆLISTOKUR	MÆLIVAFER 1:50	SAMPRYKT Davíð E. Sólvason Kt. 100356-3339	VERKHLUTI LAGNIR, LAMPAPLAN.							

GRENSÁSGEGUR 3 • 108 REYKJAVÍK  
520 9900 • FAX: 520 9901  
DAGS: 08.01.2002  
BREVIT: B