


Inntök samþykkt 1.16.1967



L.H. RAUFVEITU HAFNARFIJARDAR

Olafur Tomasson

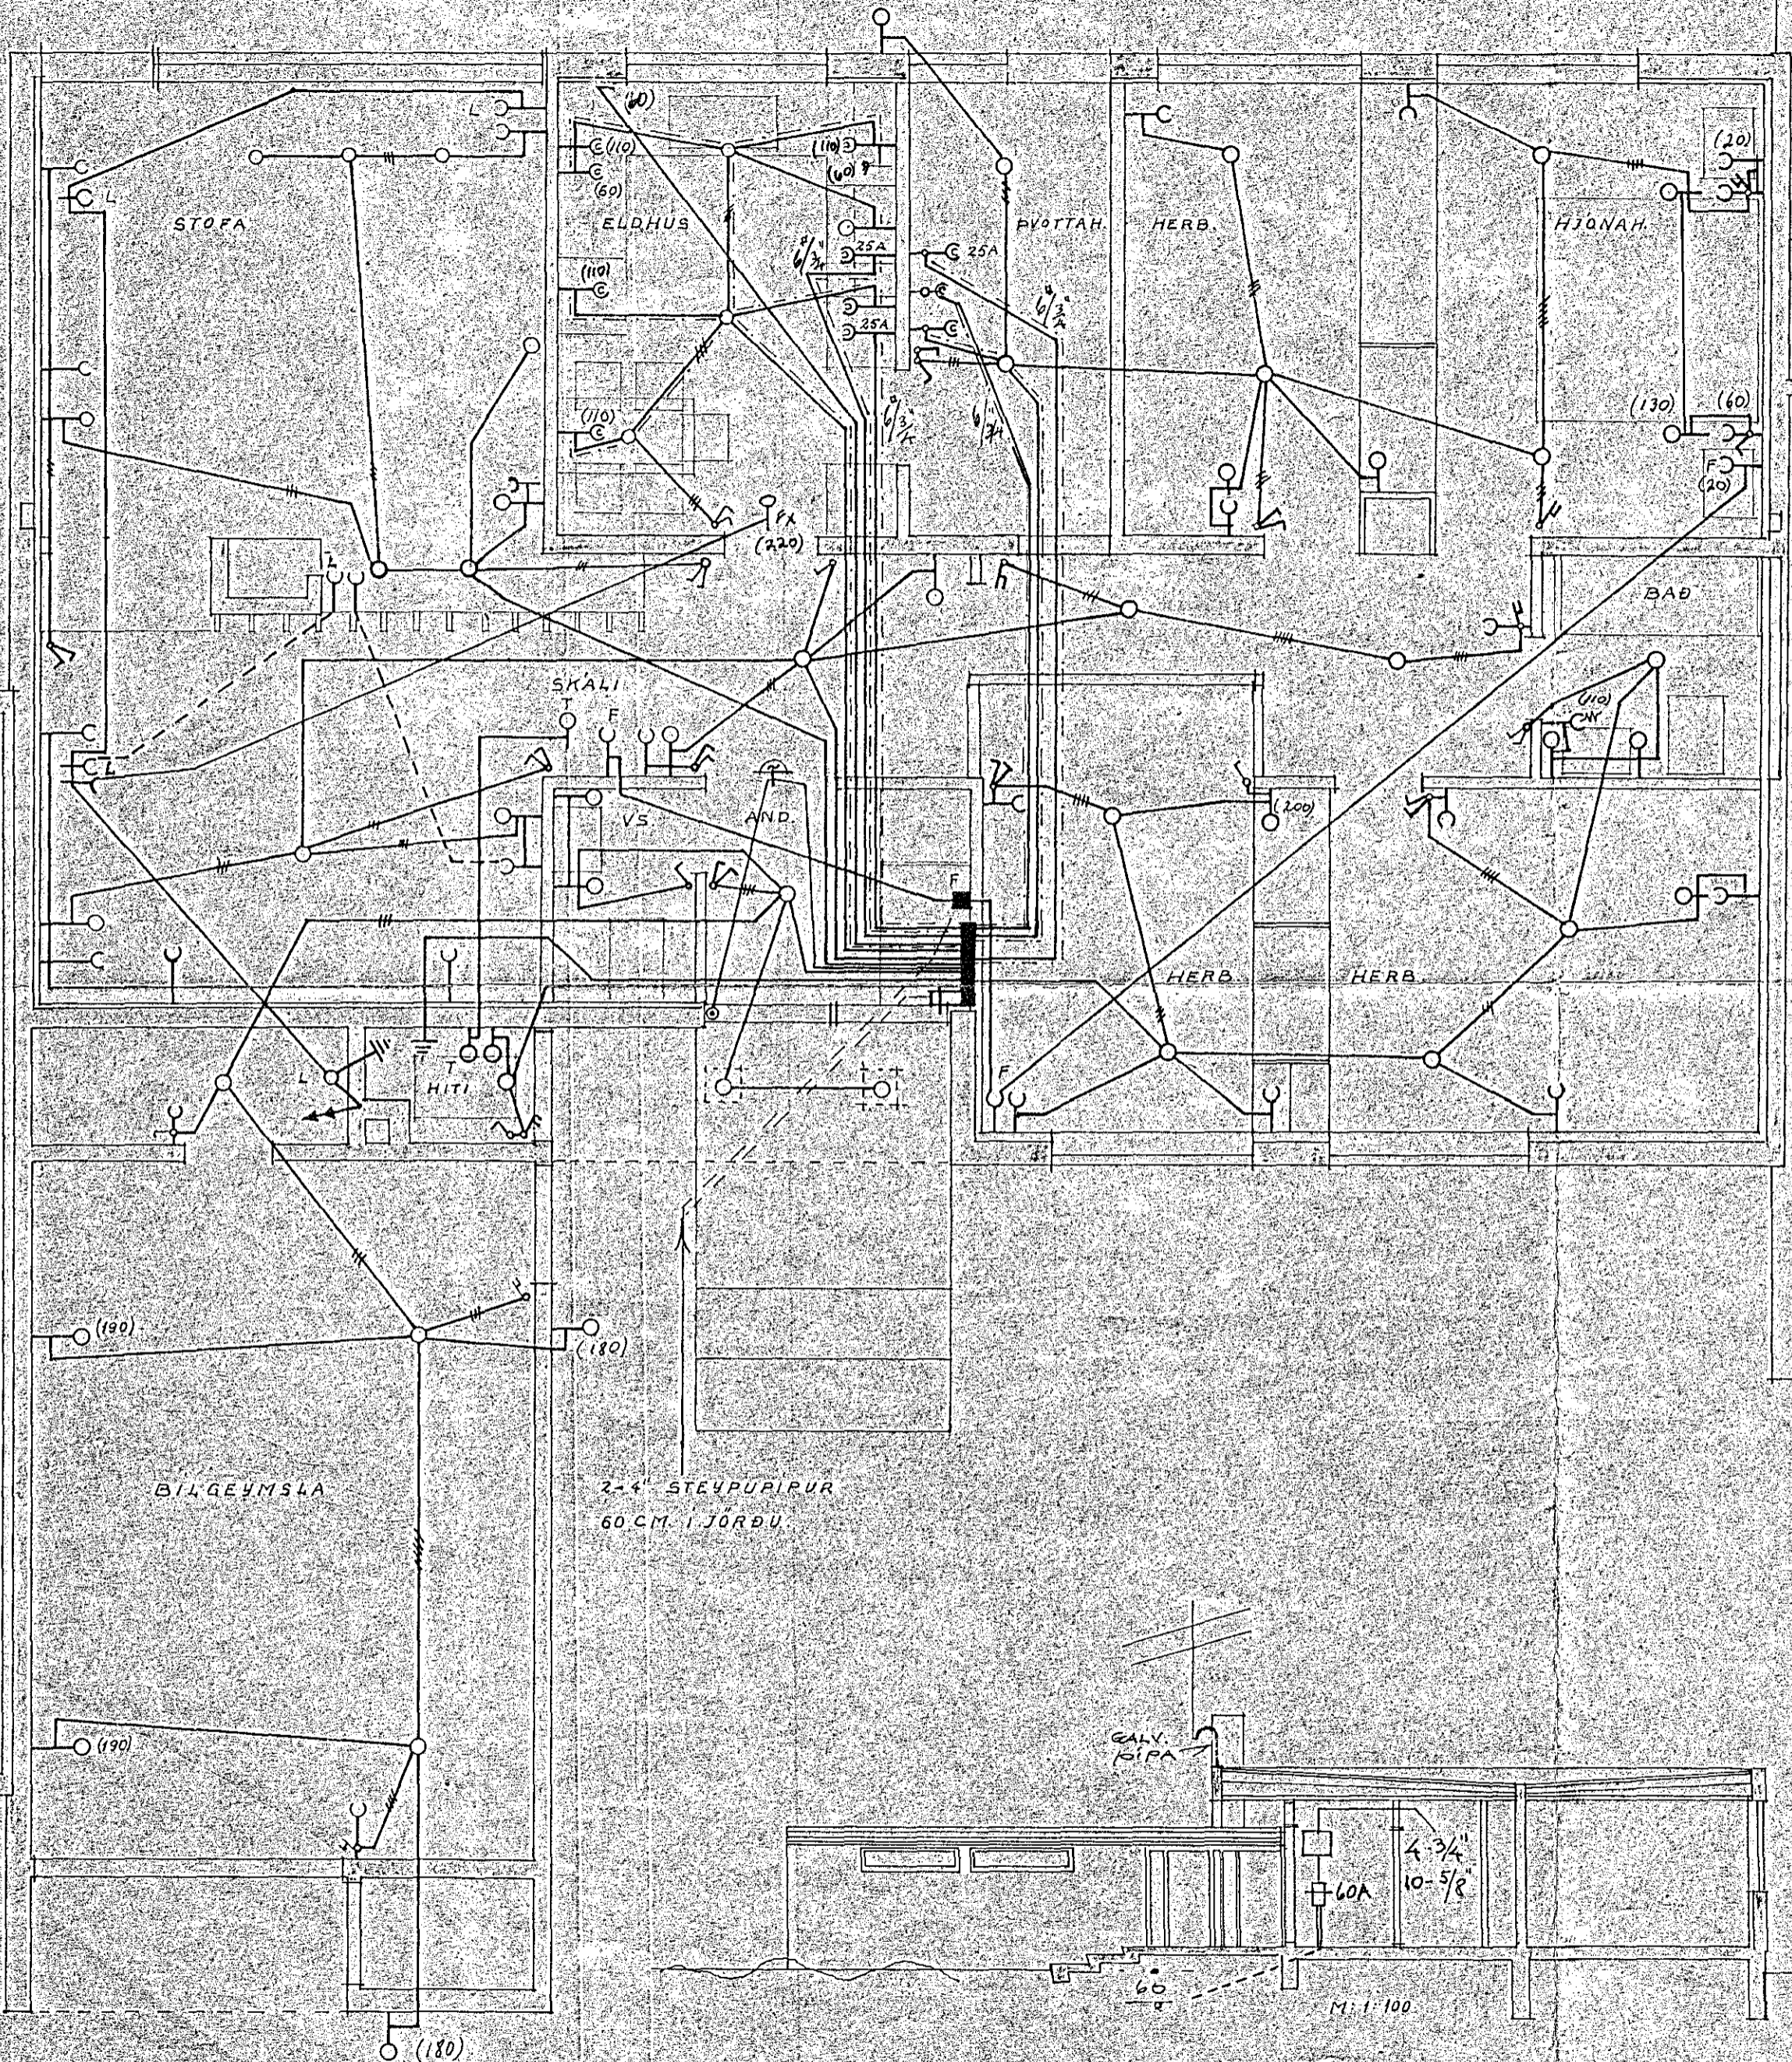

SKYRINGAR

1. ROFAR: 110 CM. FRA GÓLFU.
2. TENGLAR: 20 CM. NEMA.
3. YFIR ELDHUSBORÐI - Í ÞVOTTI: 110 CM.
4. FYRIR HELLUR - BAKAROFN - UNDIR TEKJUM CA 70 CM. (SJA INNRETTINGA TEIKN.)
5. VEGGLJÓD: 165 CM. FRA GÓLFU NEMA ANNAD SE SÝNT Í SVIQUM.
6. HITALIÐ: T: 135 CM.
7. LOFTNET: LÍ HÁTALARI: FX, SÍMI: F: 20CM FRA GÓLFU.
8. RAKVELATENGILL: CM.
9. VARKASSI: NR.113 FRA JB.F EÐA SAMSVARANDI.

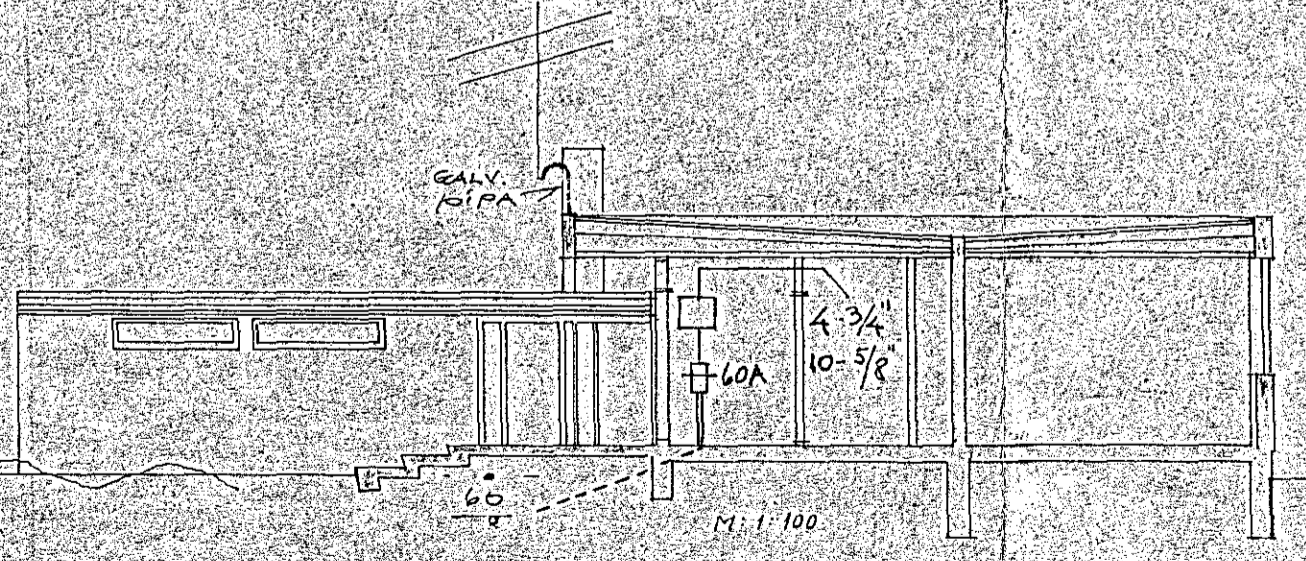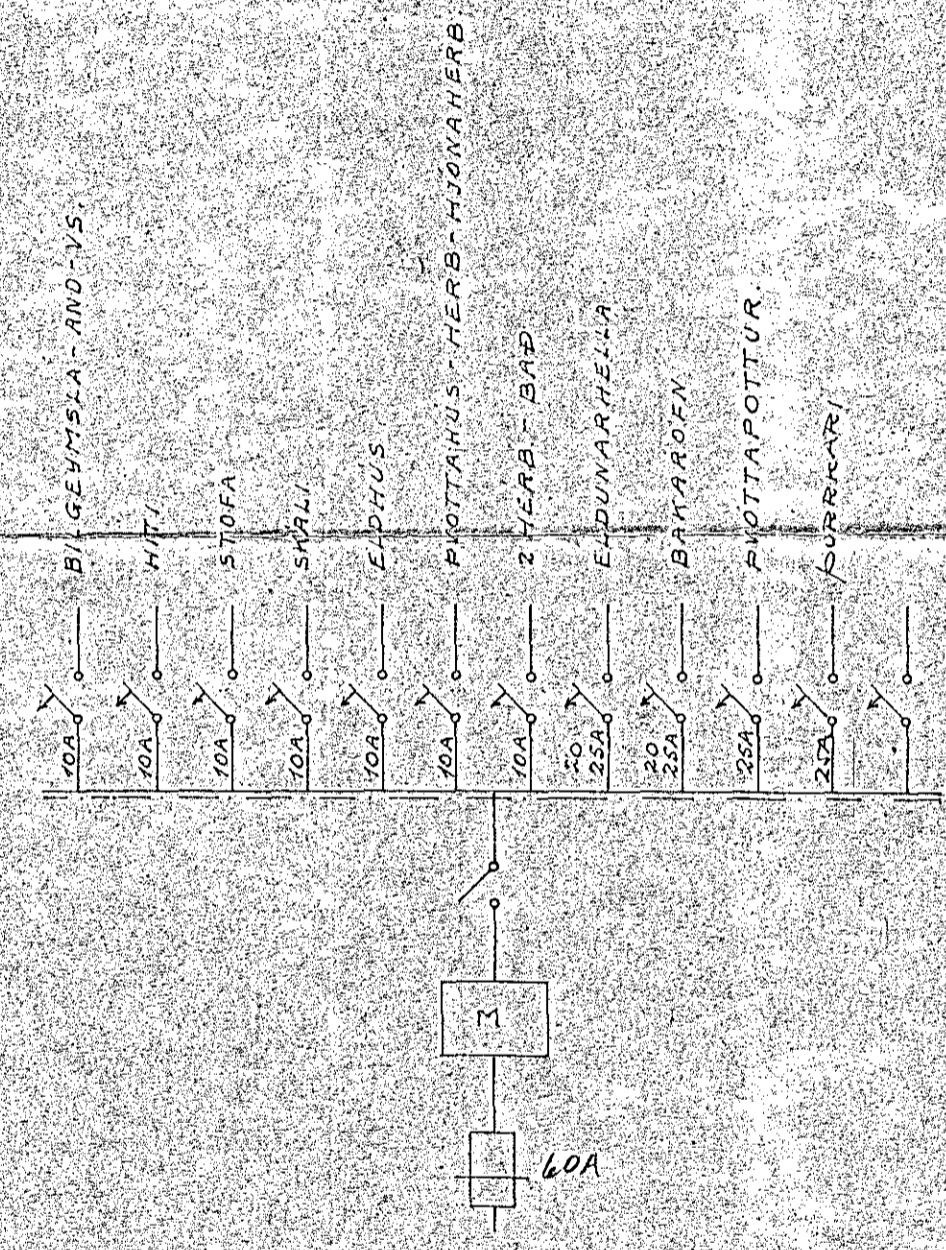

1099

OLAFUR TOMASSON VERKFR.		
afsk. 97		
HUSNEDISMÁLASTOFNUN RIKISINS		
KEDJUHÚS (INNRETTING 143)	VERK 215	
RAFLOGN	M: 1:50	BLAD 1 AF 1
JAN 1965	A.M.	NR 337