




F. SÍMI
 U. ÚTVARPS og SJÓNVARPSLOFTNET
 S. DIRA og INNANHÚSSÍMI

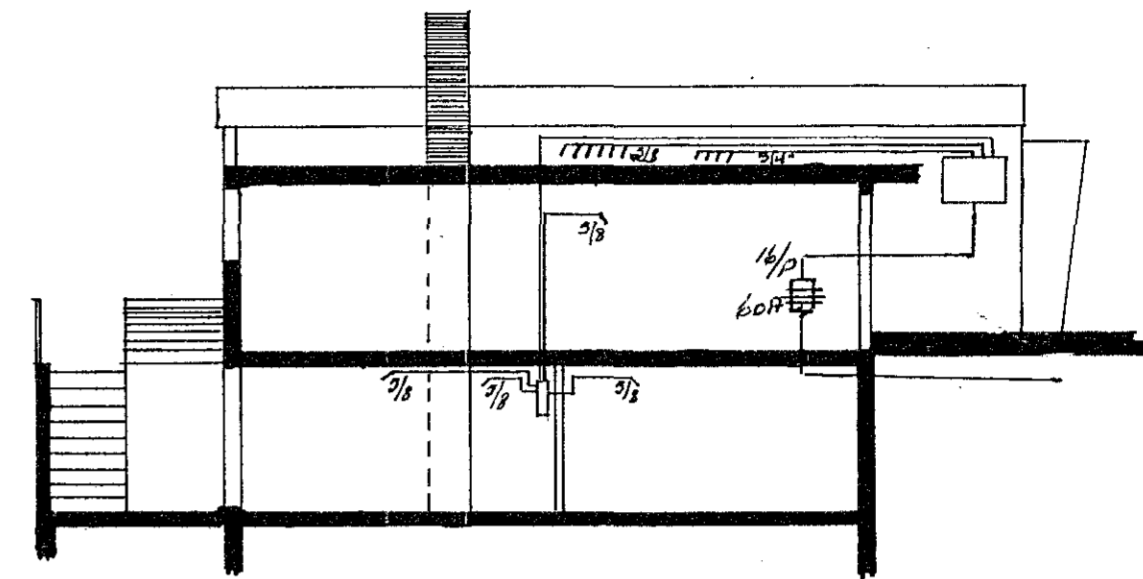

Inntök samþykkt 18.11.1968
 f. h. RAFVEITU HAFNARFIJARDAR
 Verkstjóri
Alfredur Karlsson

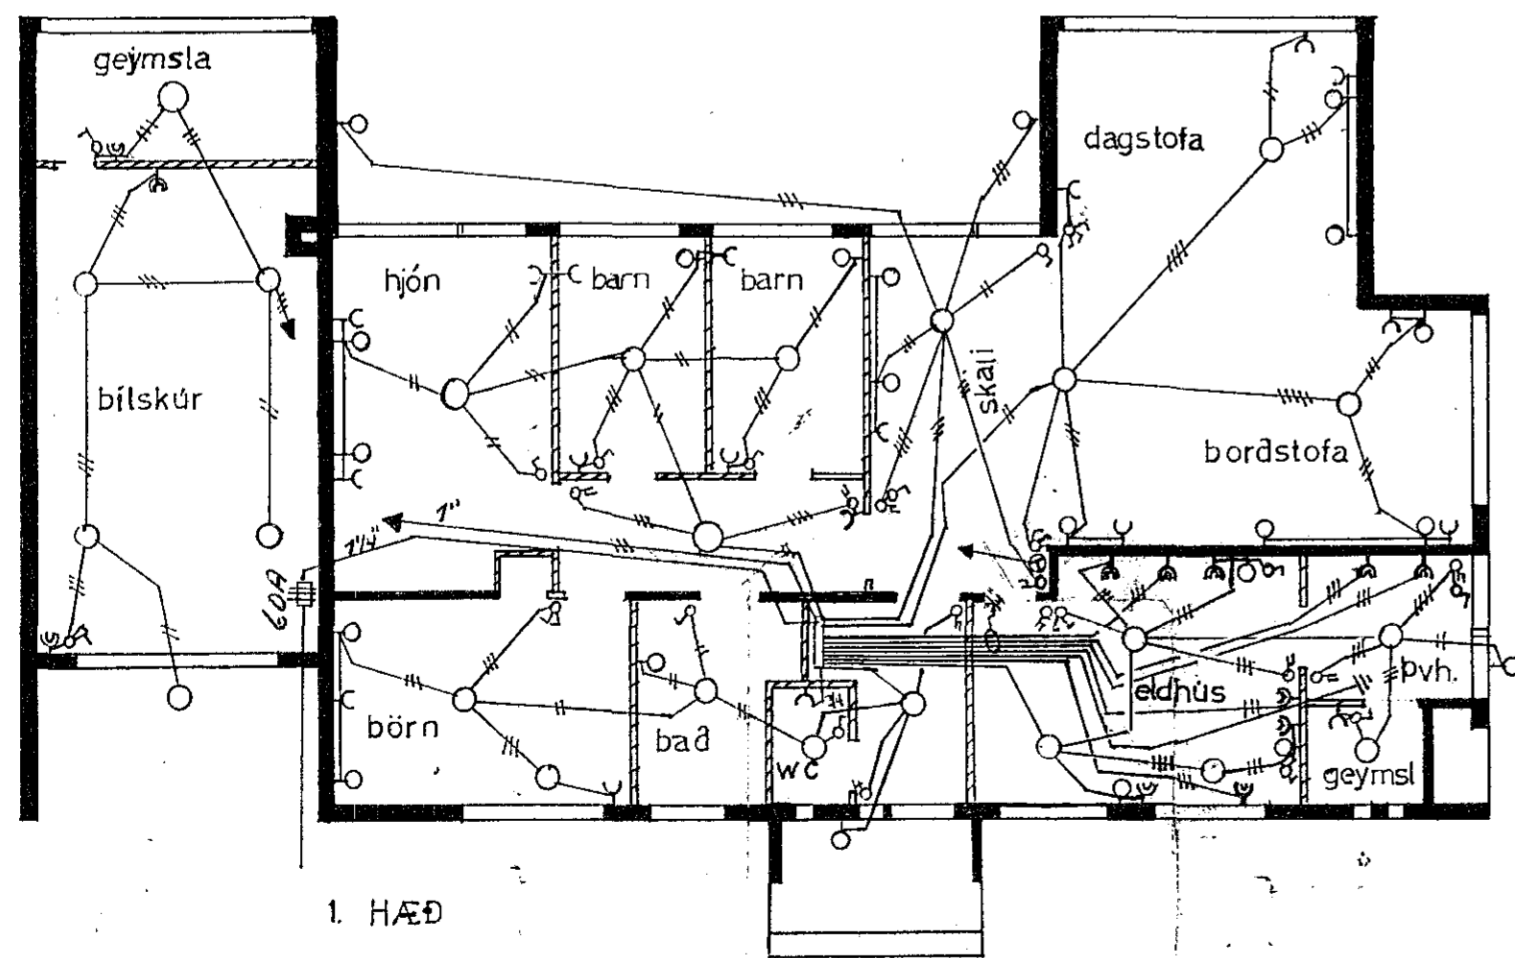

ÖLL RÖR 5/8 NEMA ANNARS SE GETID
 ALLIR TENGLAR Í ELDHÚSI, ÞVOTTAHÚSI, BÍLSKÚR og
 GEIMSLU SKULU VERA JARDENGDIR H:110
 RÖFAR H:110

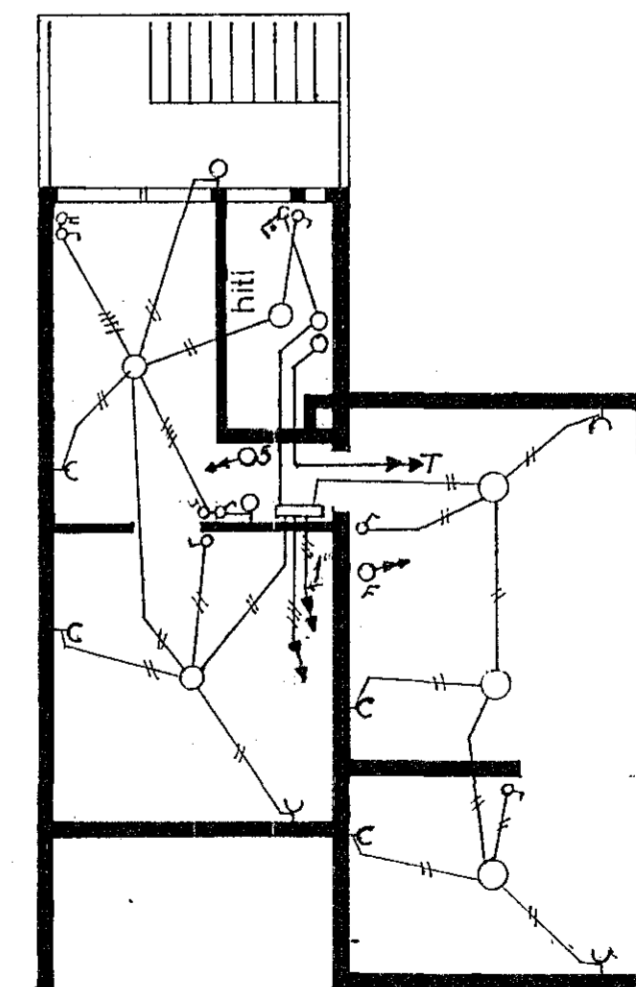

KJALLARI

1115

Mývain B GATA NR 16 HAFNARFIJÖI		
RAFLÖGN OG SÍMI		
M. 1:100	<i>Halldór Þorgeirsson</i>	Breitt 13 okt 1968 d.p.
DAGS. 28 maí 1967		