

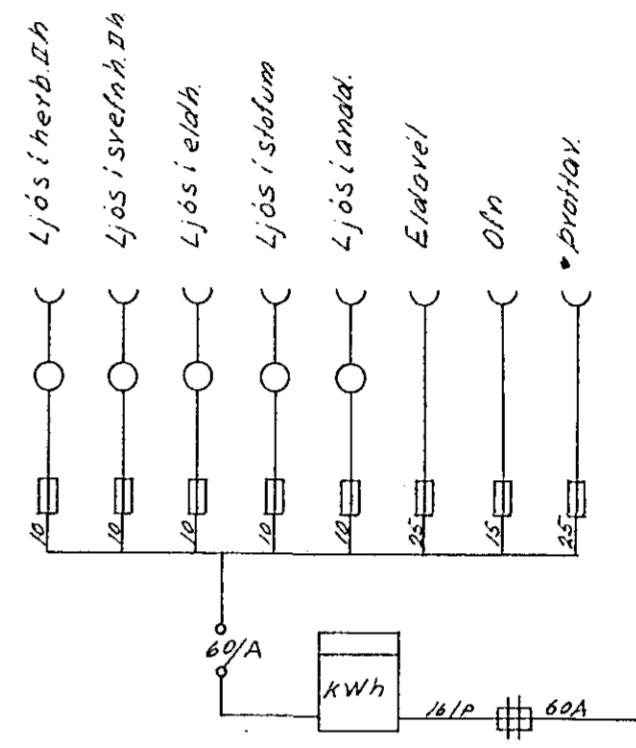
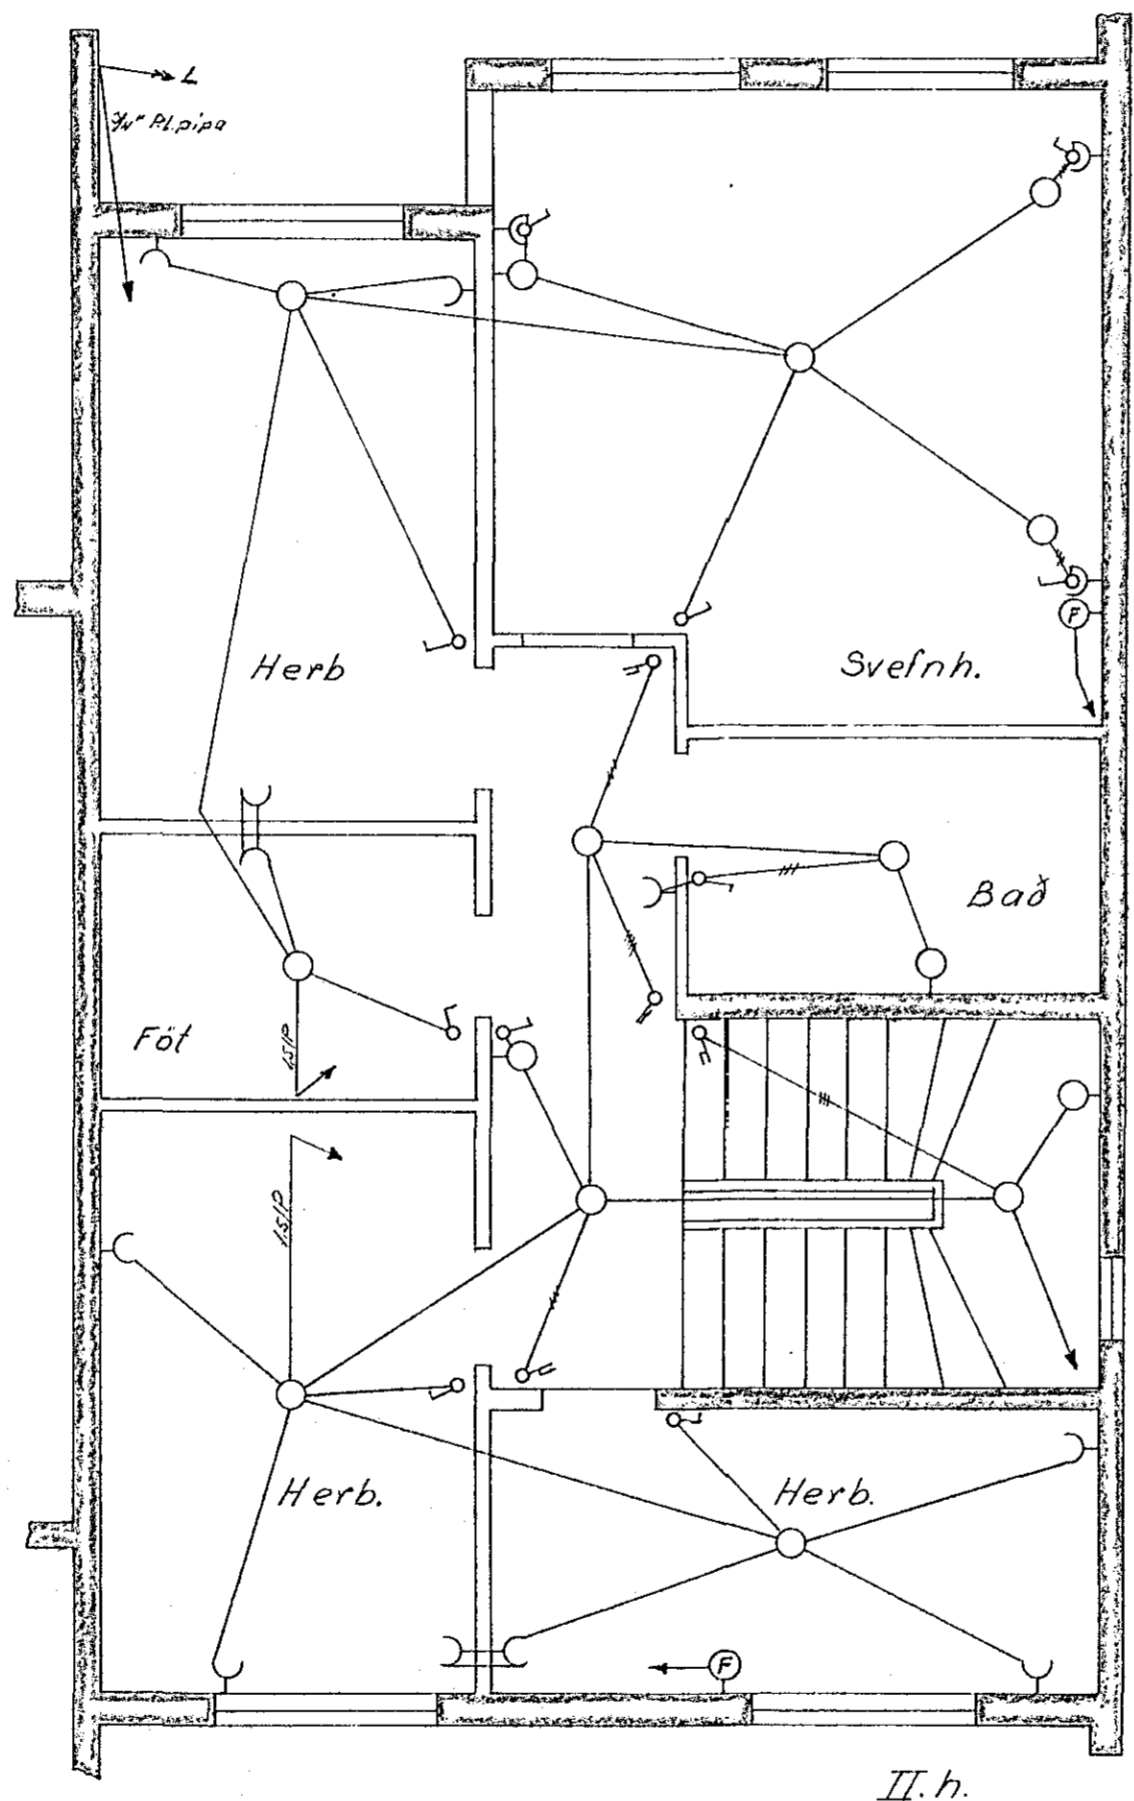


Inntök samþykkt 12.11.0. 1967
 l.h. RAUVEITU HAFNARFJARÐAR
 Verkstjóri
Ólafur Jónsson

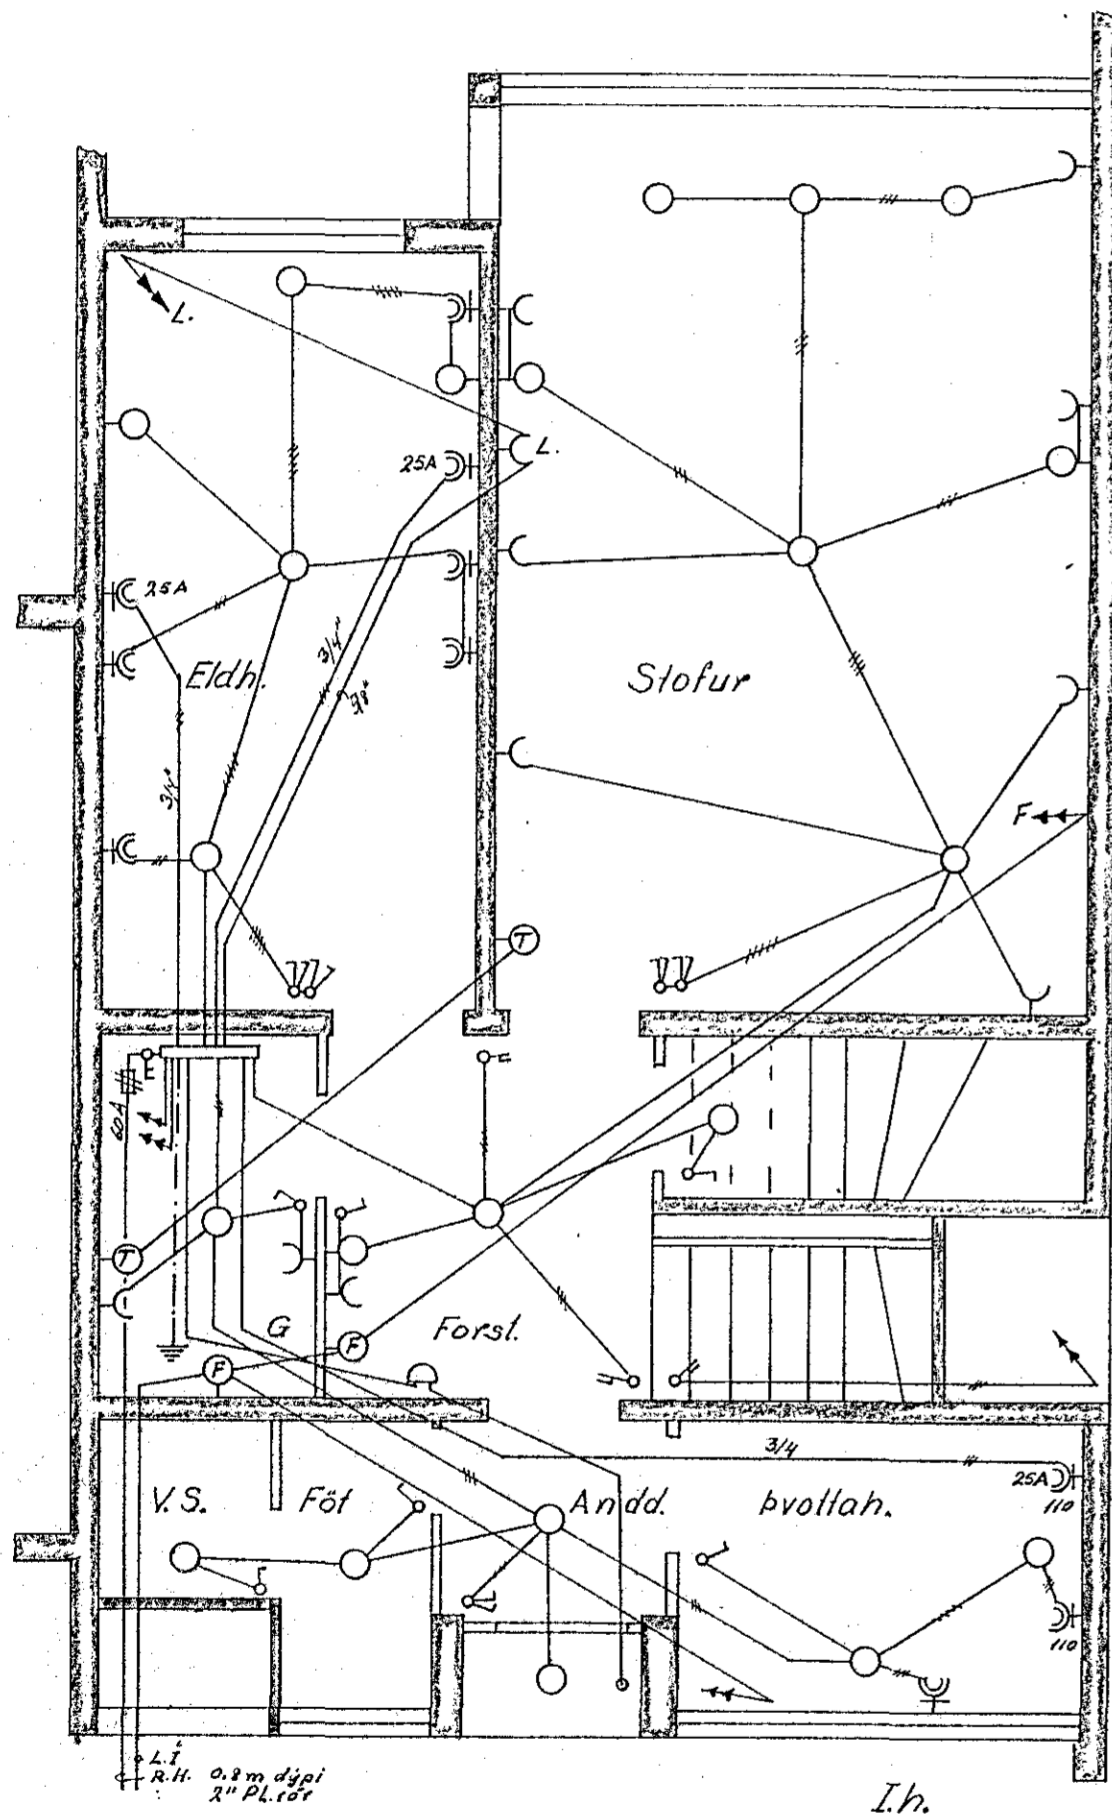

Einpólalengimynd

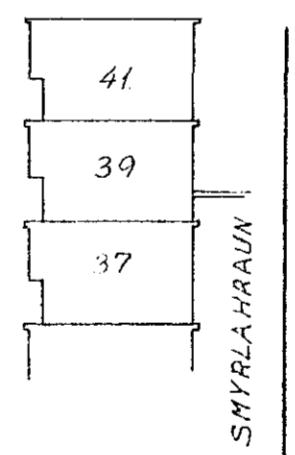

1110

DAGS	NAFN	KVARDI
FRDR	Sep 67	SK/P
TEIKN	" "	SK/P
SMYRLAHRUN 39		1:50
Rafslagnaleikning		1:500
Láfan & Þorsteinsson		