




TRÖNNAHRAUN

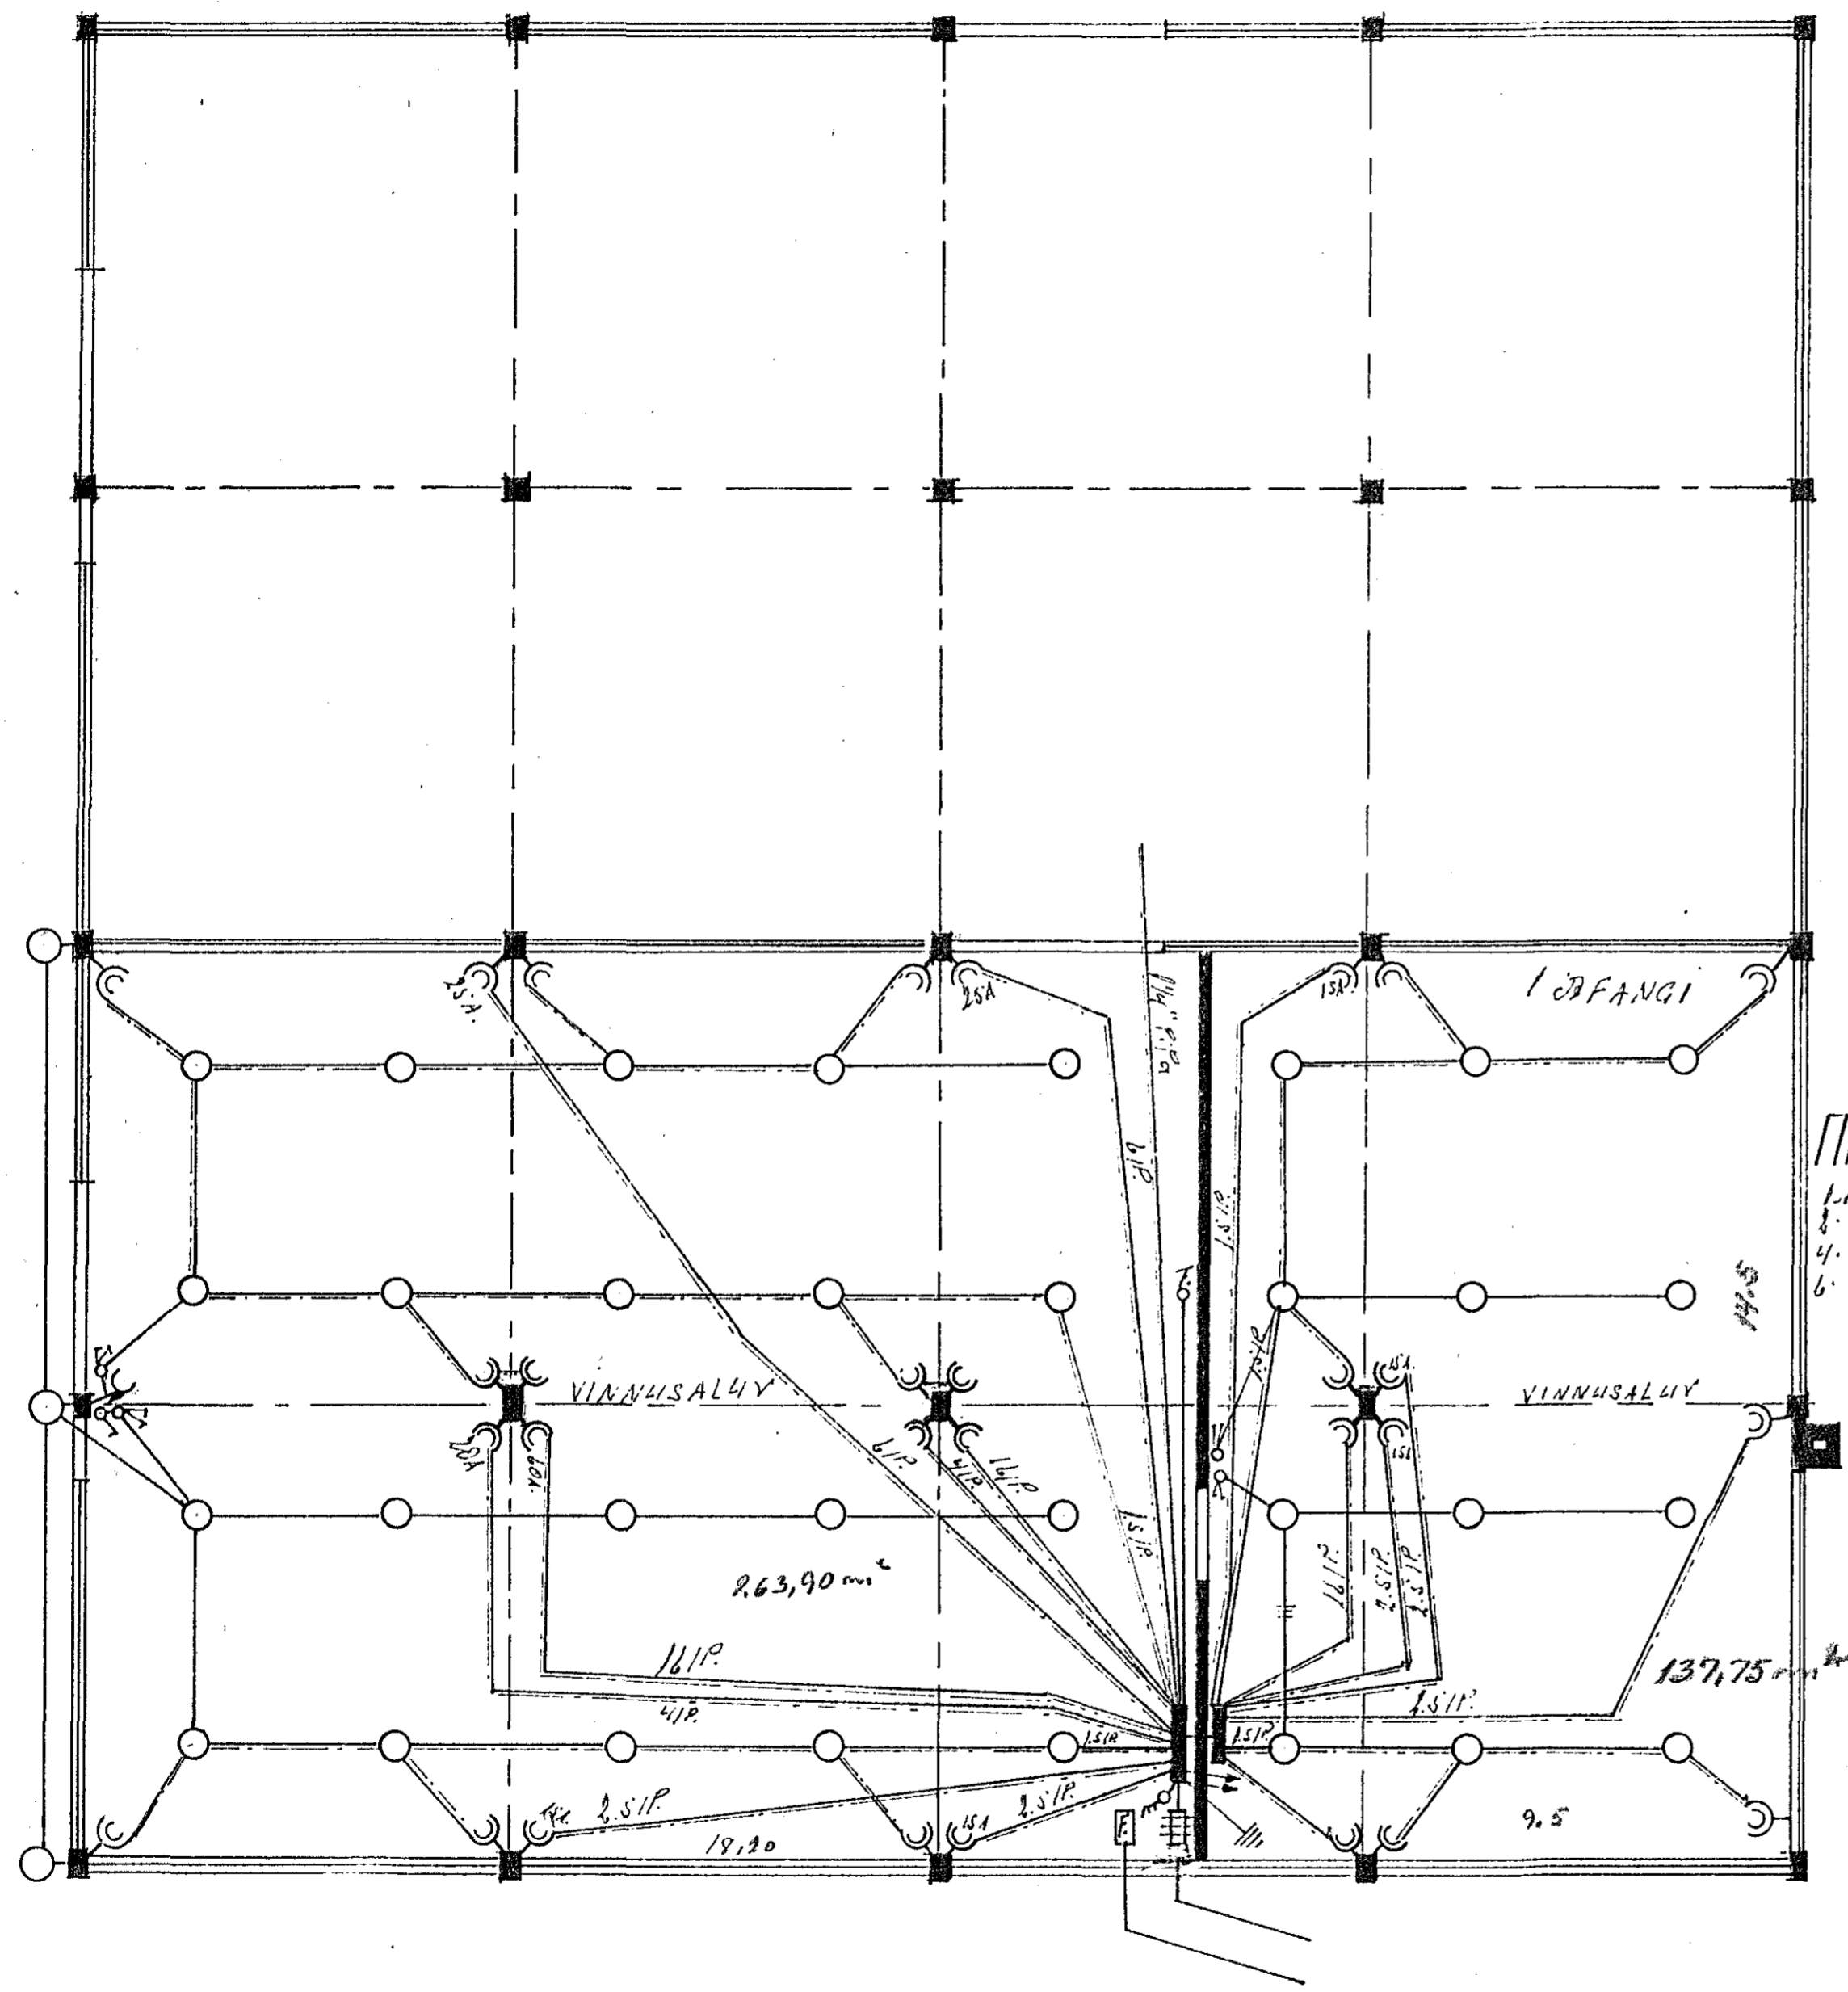

Hjallahraun

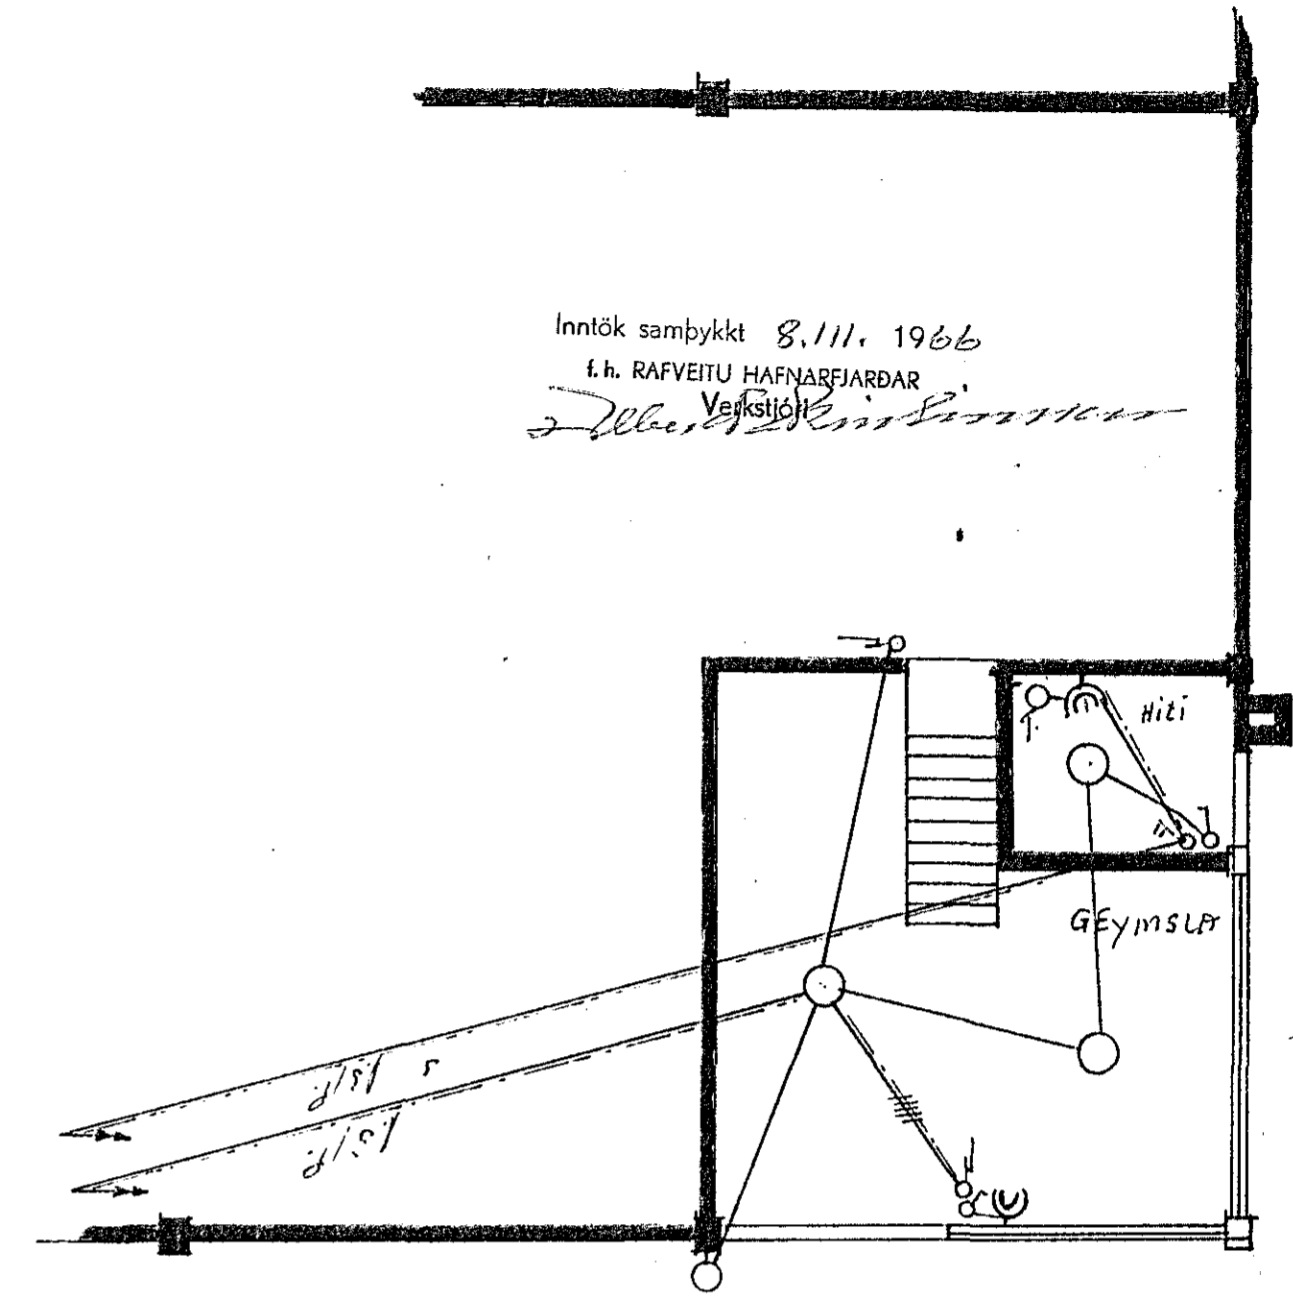

Inntök samþykkt 8.11. 1966
 f.h. RAFVEITU HAFNARFJARDAR

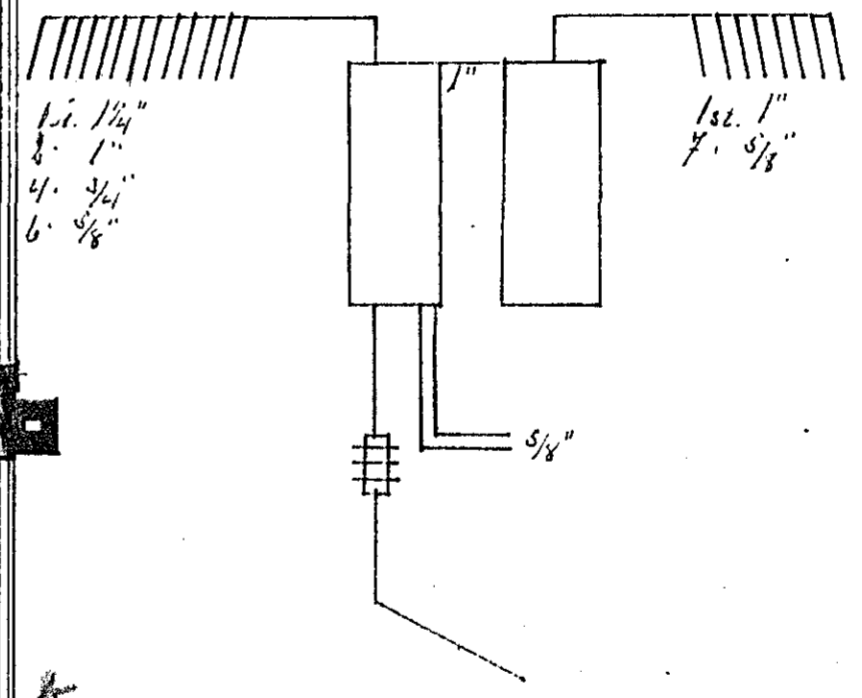

1062.

14.11.1966
 Gunnar Guðmundsson