

A

B

C


D

E

F


TAFLA 2.2 (ELDHÚS)
 TAFLA 2.3 (DISKÓBÚR)
 TAFLA 2.4 (LOFTRESING)

TÖMSTUNDIR, GEYMSLA
 STÖNVARP / FUNDIR OFL.
 BORÐTENNIS, HJÓMVER
 RESTITENGLAR
 ÚT-LJÓÐ OG TENGLAR Í STÖNHERB.
 TENGLAR Í RENNUNN, HJÓMVER OFL.
 TENGLAR Í RENNUNN, TÖMSTUNDIR OFL.

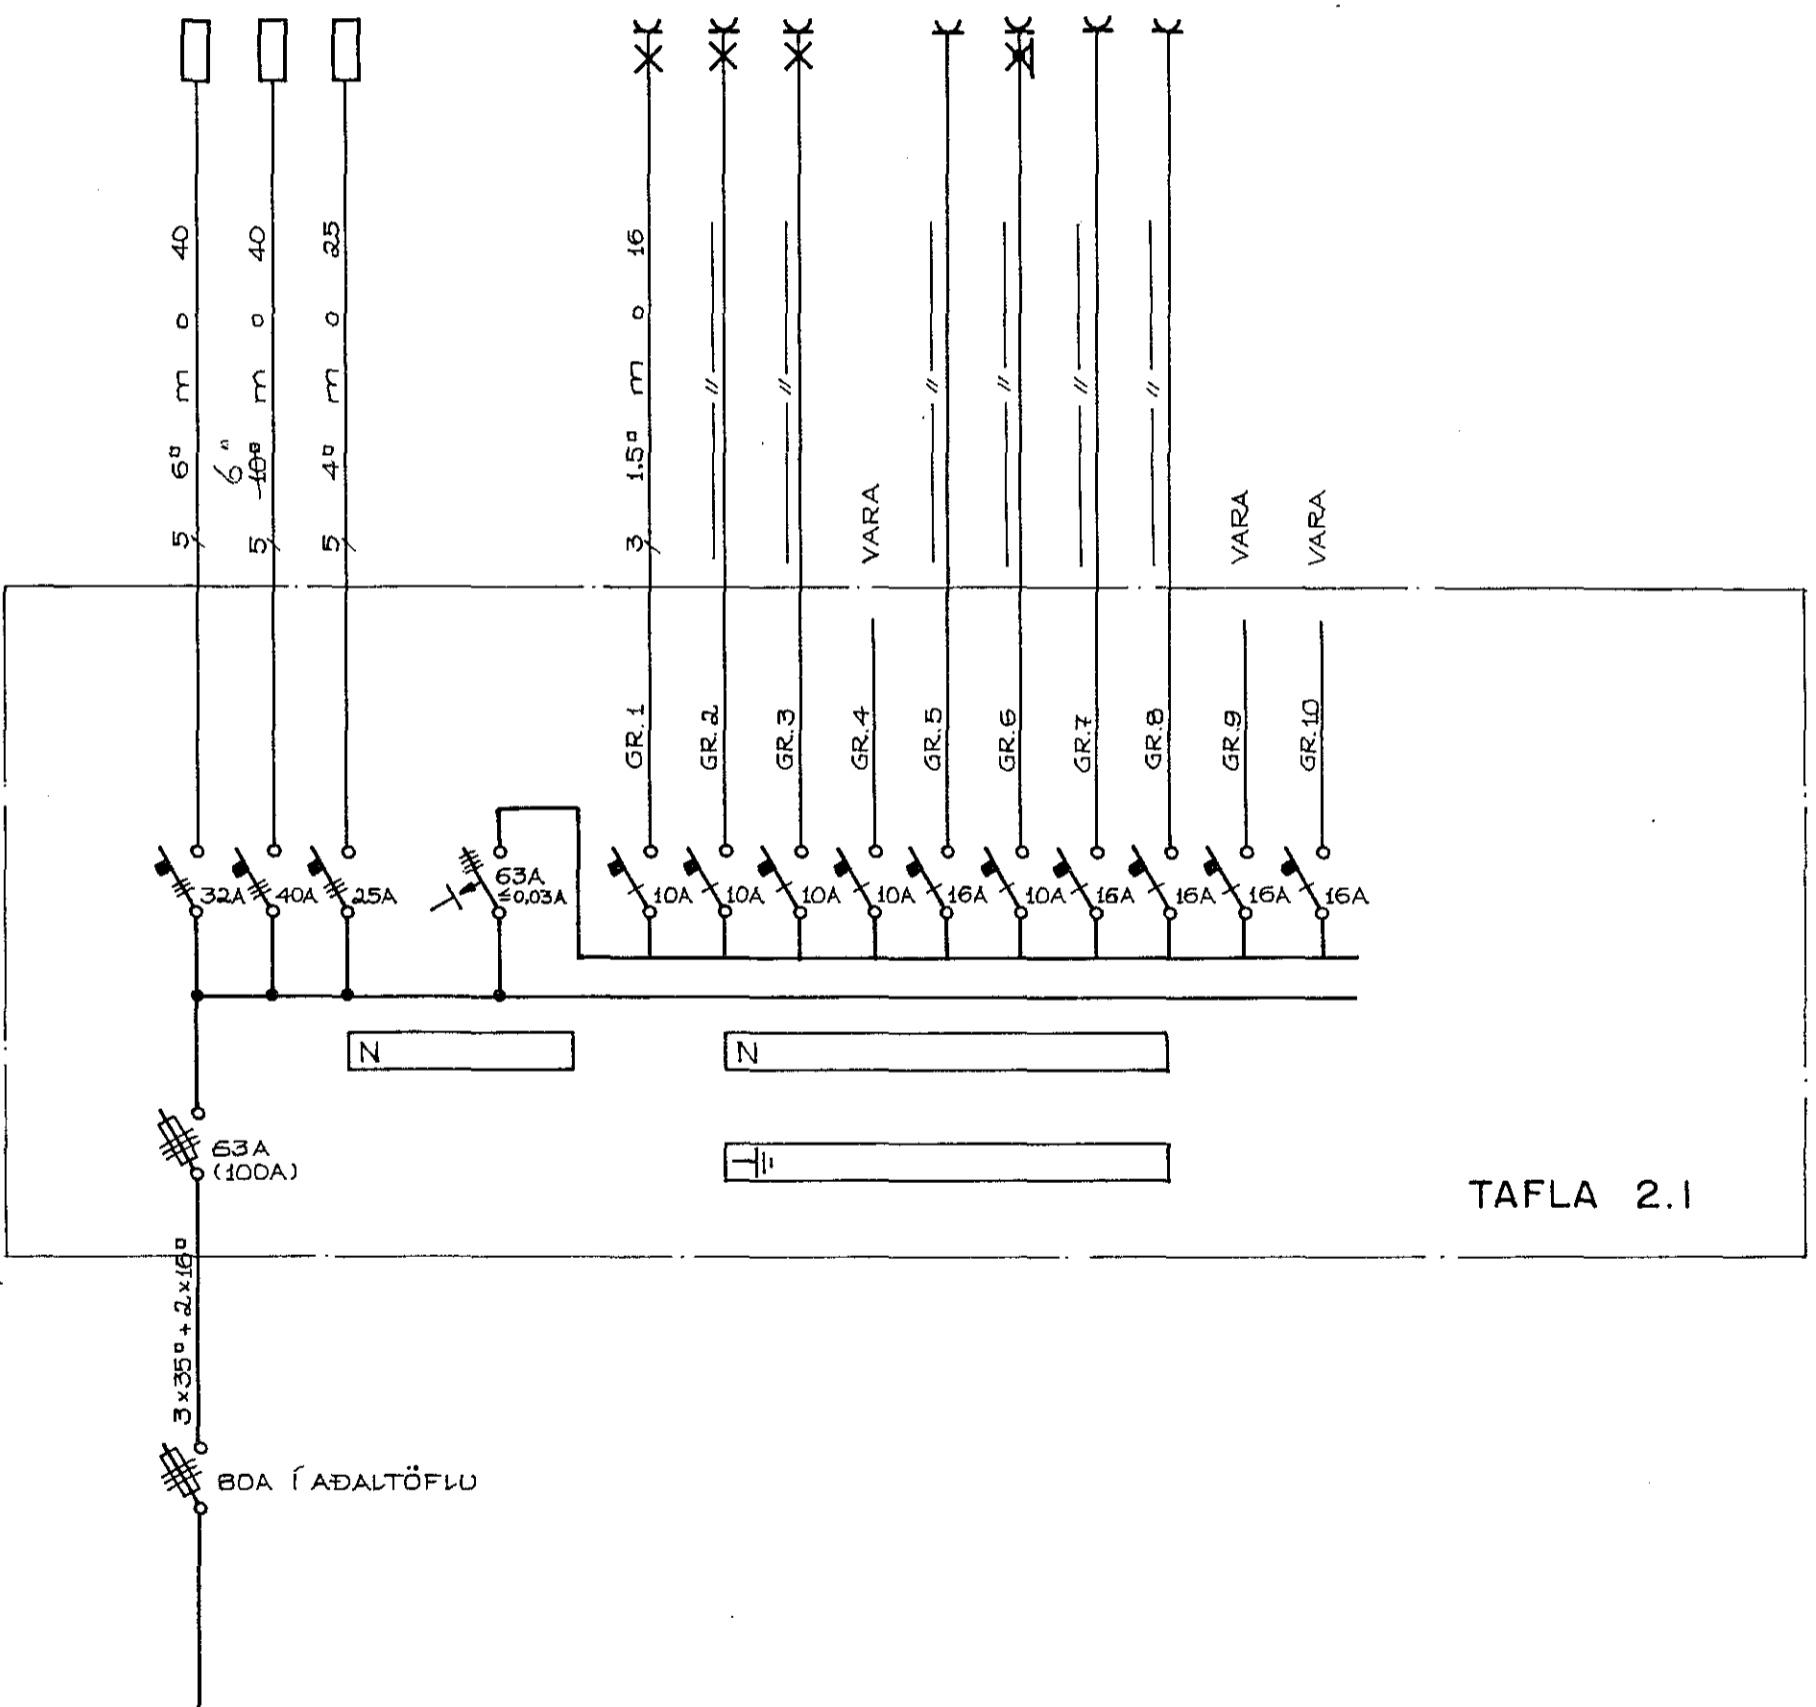

TAFLA 2.1

INNBLÁSARI 1. IB.04
 INNBLÁSARI 2. IB.05
 PAKBLÁSARI 1. ÚB.07
 ÚTSOGSBLÁSARI
 STÝRITREKUR

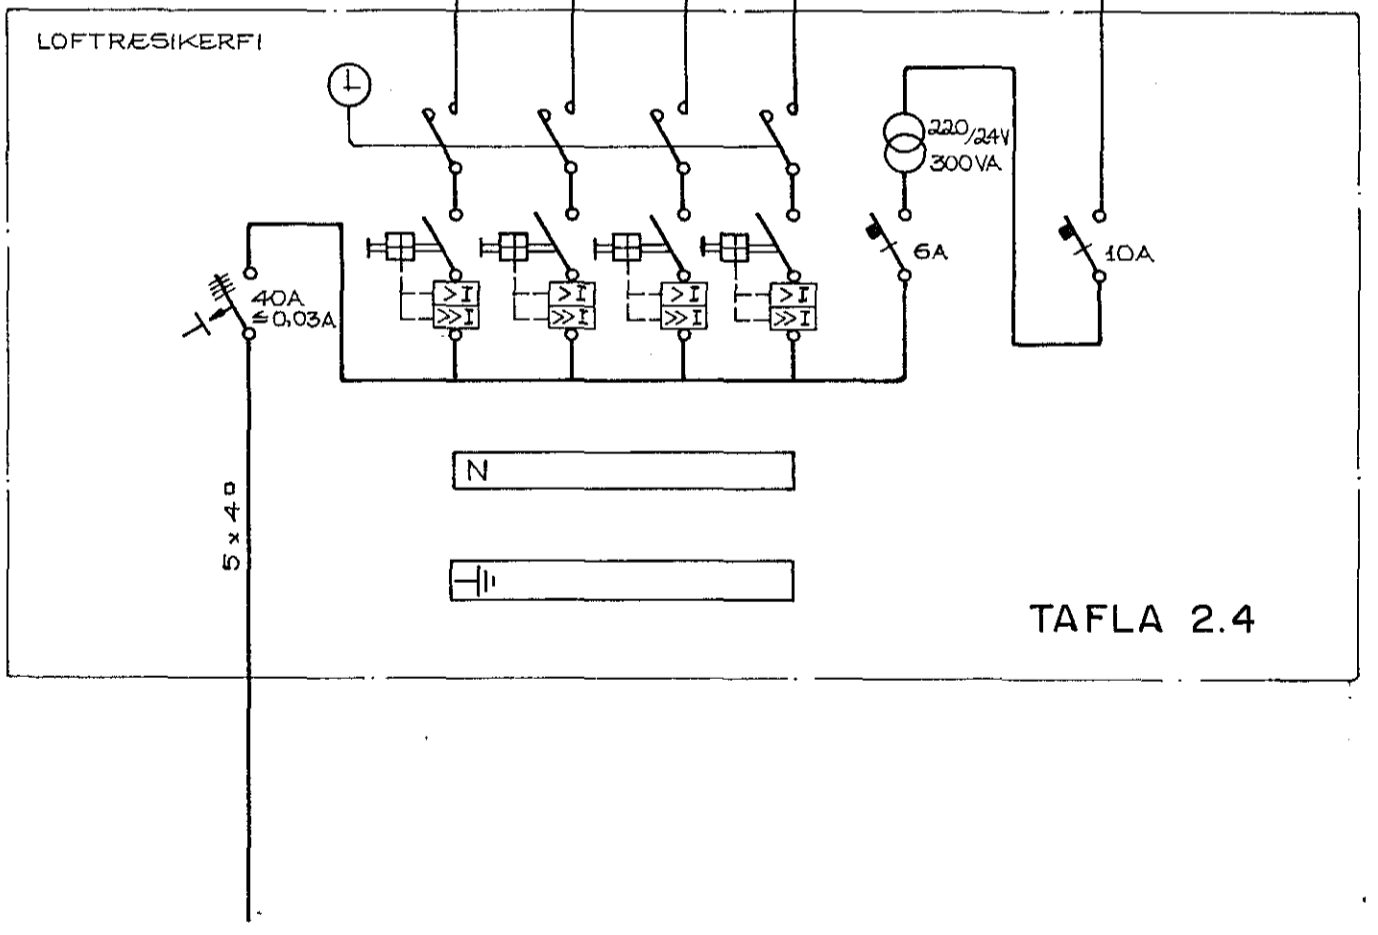

TAFLA 2.4

A	88.02.05	VINNUTEIKNING	S.E.	T.S.	<i>Trausti Sveinbjörn</i>
ÚTG.	DAGS.		TEIKN.	HANNAD	SAMÞYKKT

STRANDGATA 1 · HAFNARFIRÐI
 EINLÍNUMYND AF TÖFLU 2.1, 2.4.



RAFMAGNSVERKFRÆÐISTOFA
 TRAUSTI SVEINBJÖRNSSON
 EDMUND BELLERSEN
 RAGNAR D. STEFANSSON
 ÁGUST ÞÓRHALLSSON

MRV.	1.
TEIKN NR.	9
NÆSTA TEIKN NR.	10
VERKNR.	
BL 10 AF 13	ÚTG. A
GEYMSLUNR.	3-40

A

B

C

D

E

F