


Húsvéita nr. 1759 Teikning nr. 889
 Samþykkt b. 3-3 1964
 f. h. RAFVEITU HAFNARFJÁRDAR
Ólafur Tómasson
 Elfréttisráðgjafi

Inntök samþykkt 3.15. 1964
 f. h. RAFVEITU HAFNARFJÁRDAR
 Verkstjórn
Ólafur Tómasson

Rafloagnin er samþykkt fyrir
 EINEASA TÆKI

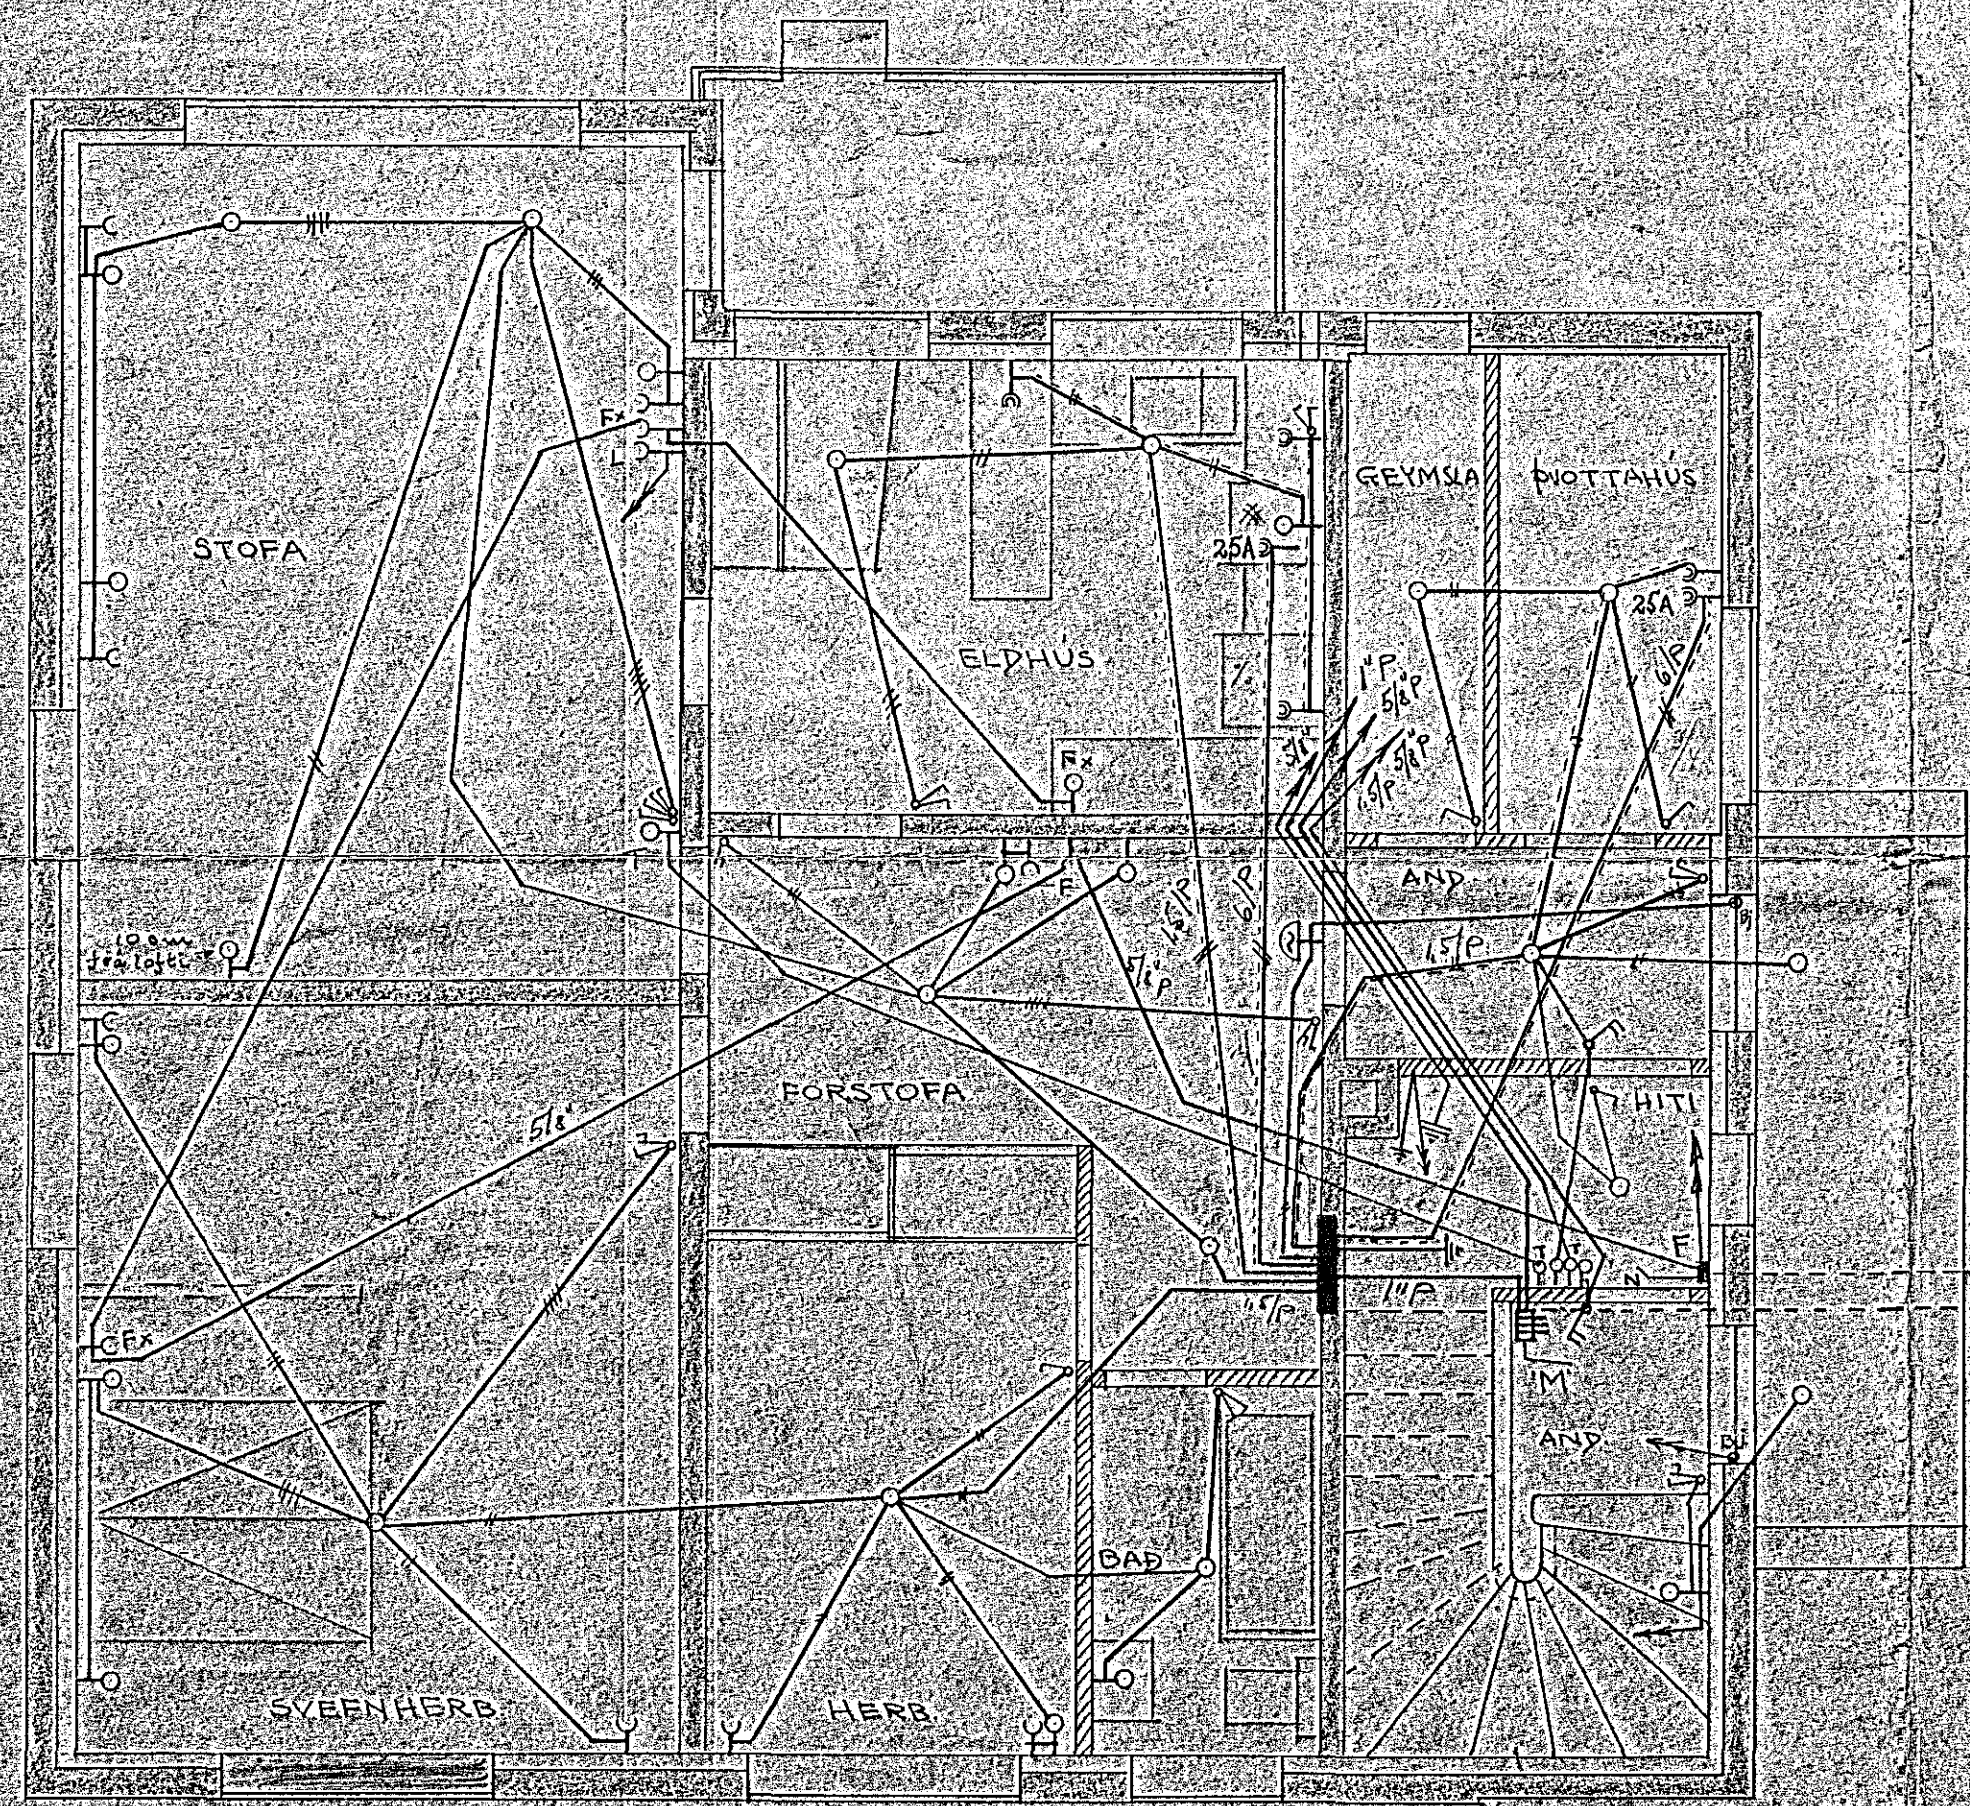

889 - *Ólafur Tómasson*

ÓLAFUR TÓMASSON verkfr.	
TVEYGLISHÚS VERK H.R. NR. 118	
RAFLÖGN SÍMALÖGN	
NEÐRI HÆÐ - SNEIÐING M. 150	
REYKJAVÍK 30.6.59	BLAD 1 af 2
<i>OT</i>	NR. 144/1

