
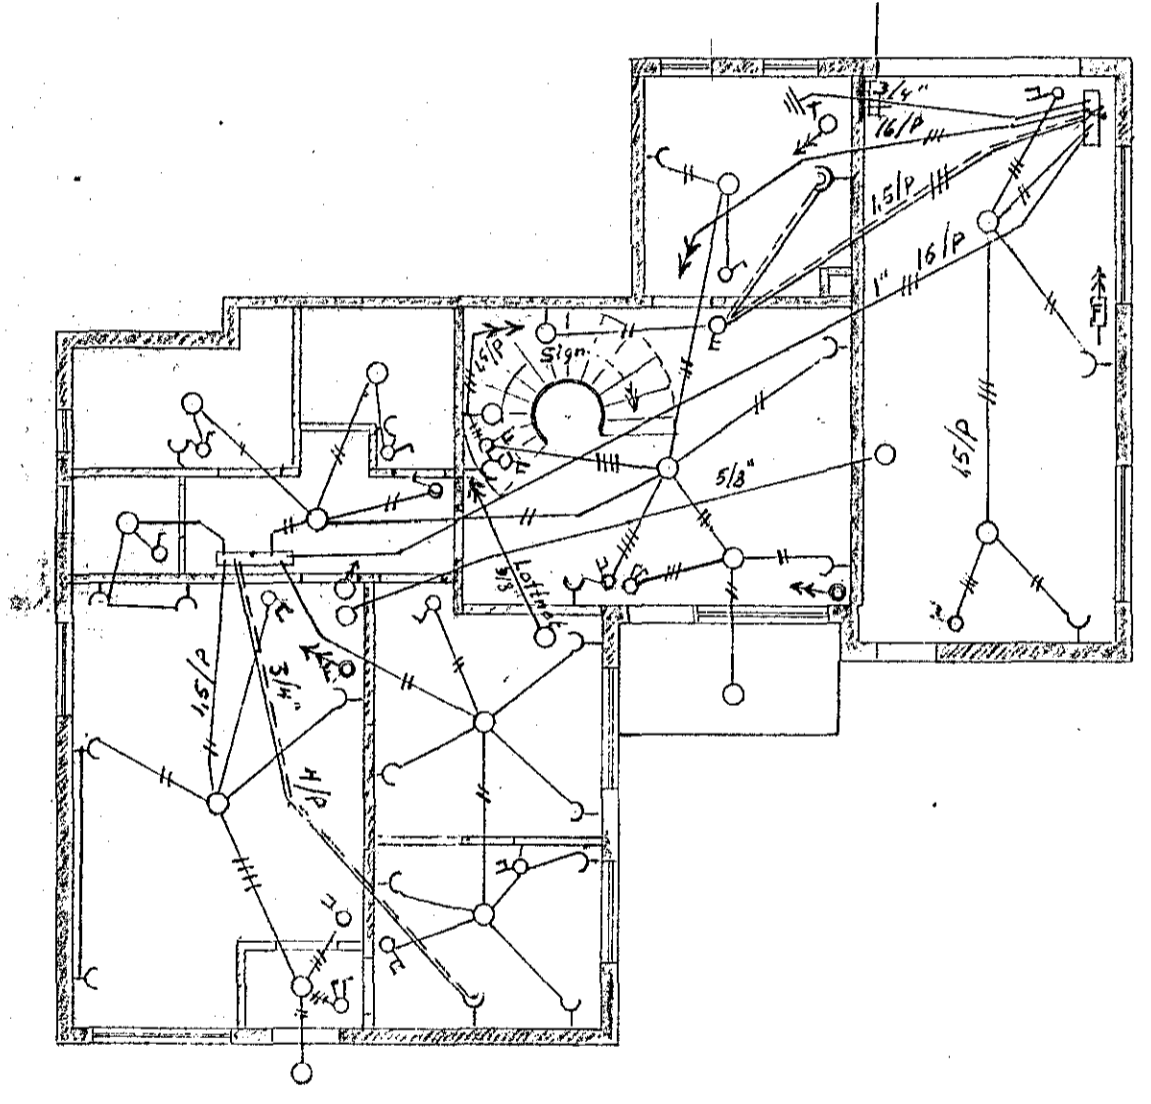
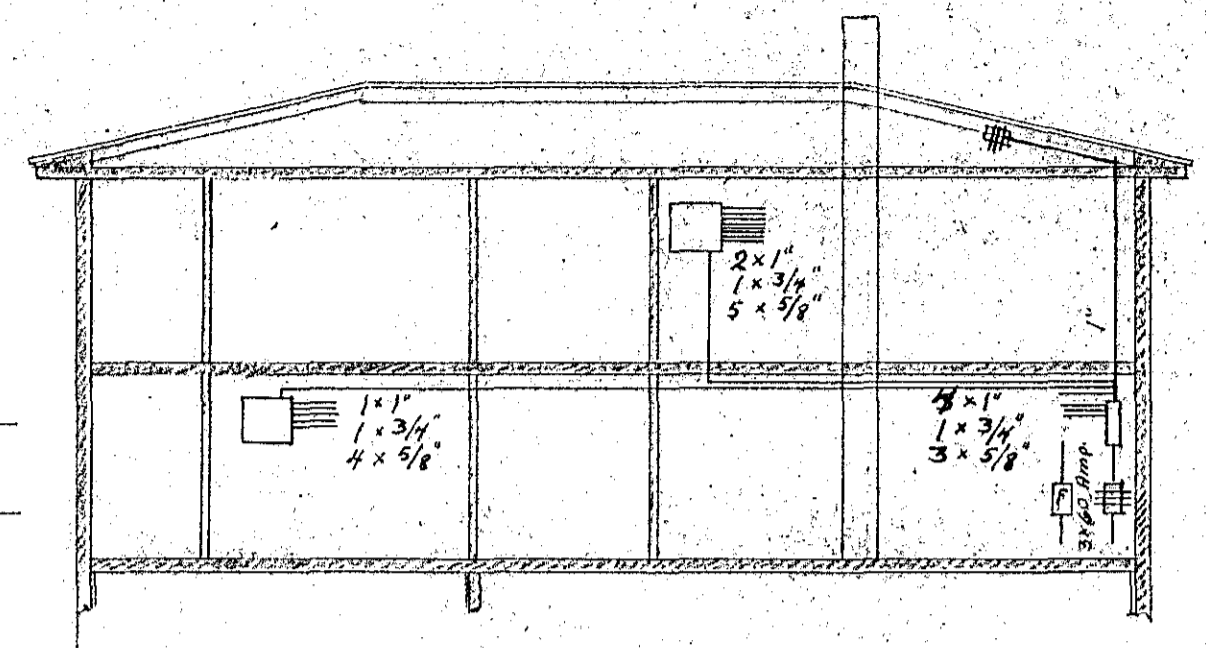



RAFLÖGN  
Ónefnd gata nr.

EIGANDI: ANDRÉS GUNNARSSON

Mk. 1:100

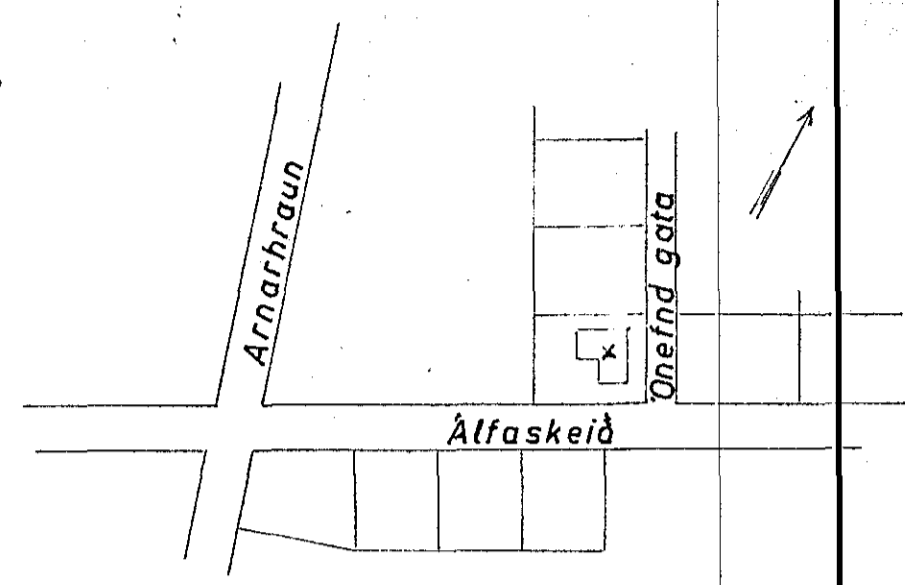

Nedri hæð

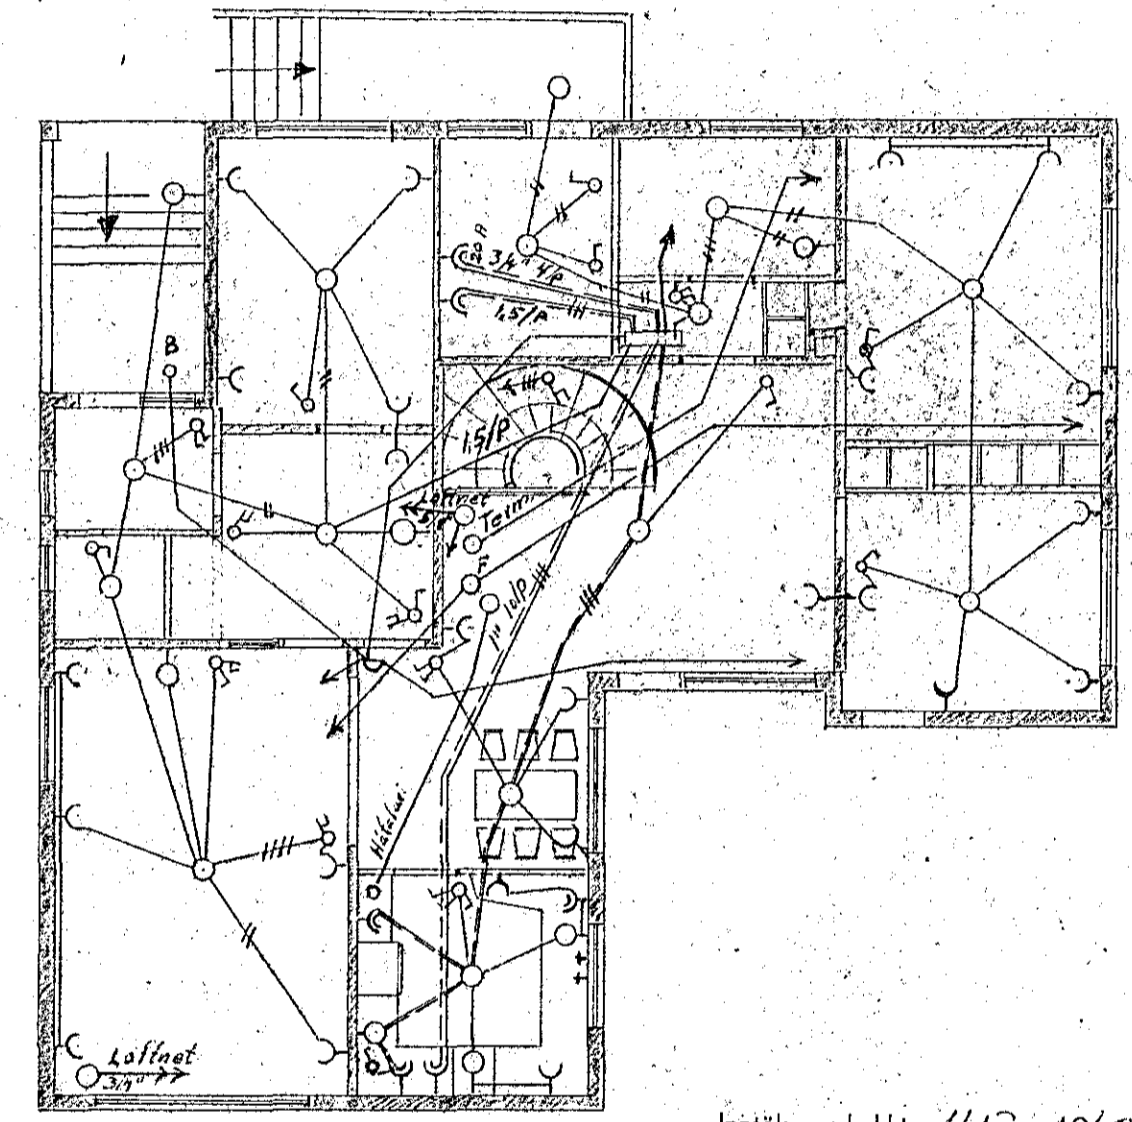

Efri hæð

Inntök samþykkt 16.3. 1960  
 f. h. RAFVEITU HAFNARFJARDAR  
 Verkstjórn  
*Robert Þorláksson*

HAFNARFIRDI FEBR. 1960

Andrés Gunnarsson

737- *boluwa 10*