



Upp	1" - 1 1/8"
"	1" - 1"
"	1" - 3/4"
"	1" - 9/8"
Nður	1" - 2"
"	1" - 1 1/8"
"	3" - 1 1/8"
"	1" - 5/8"

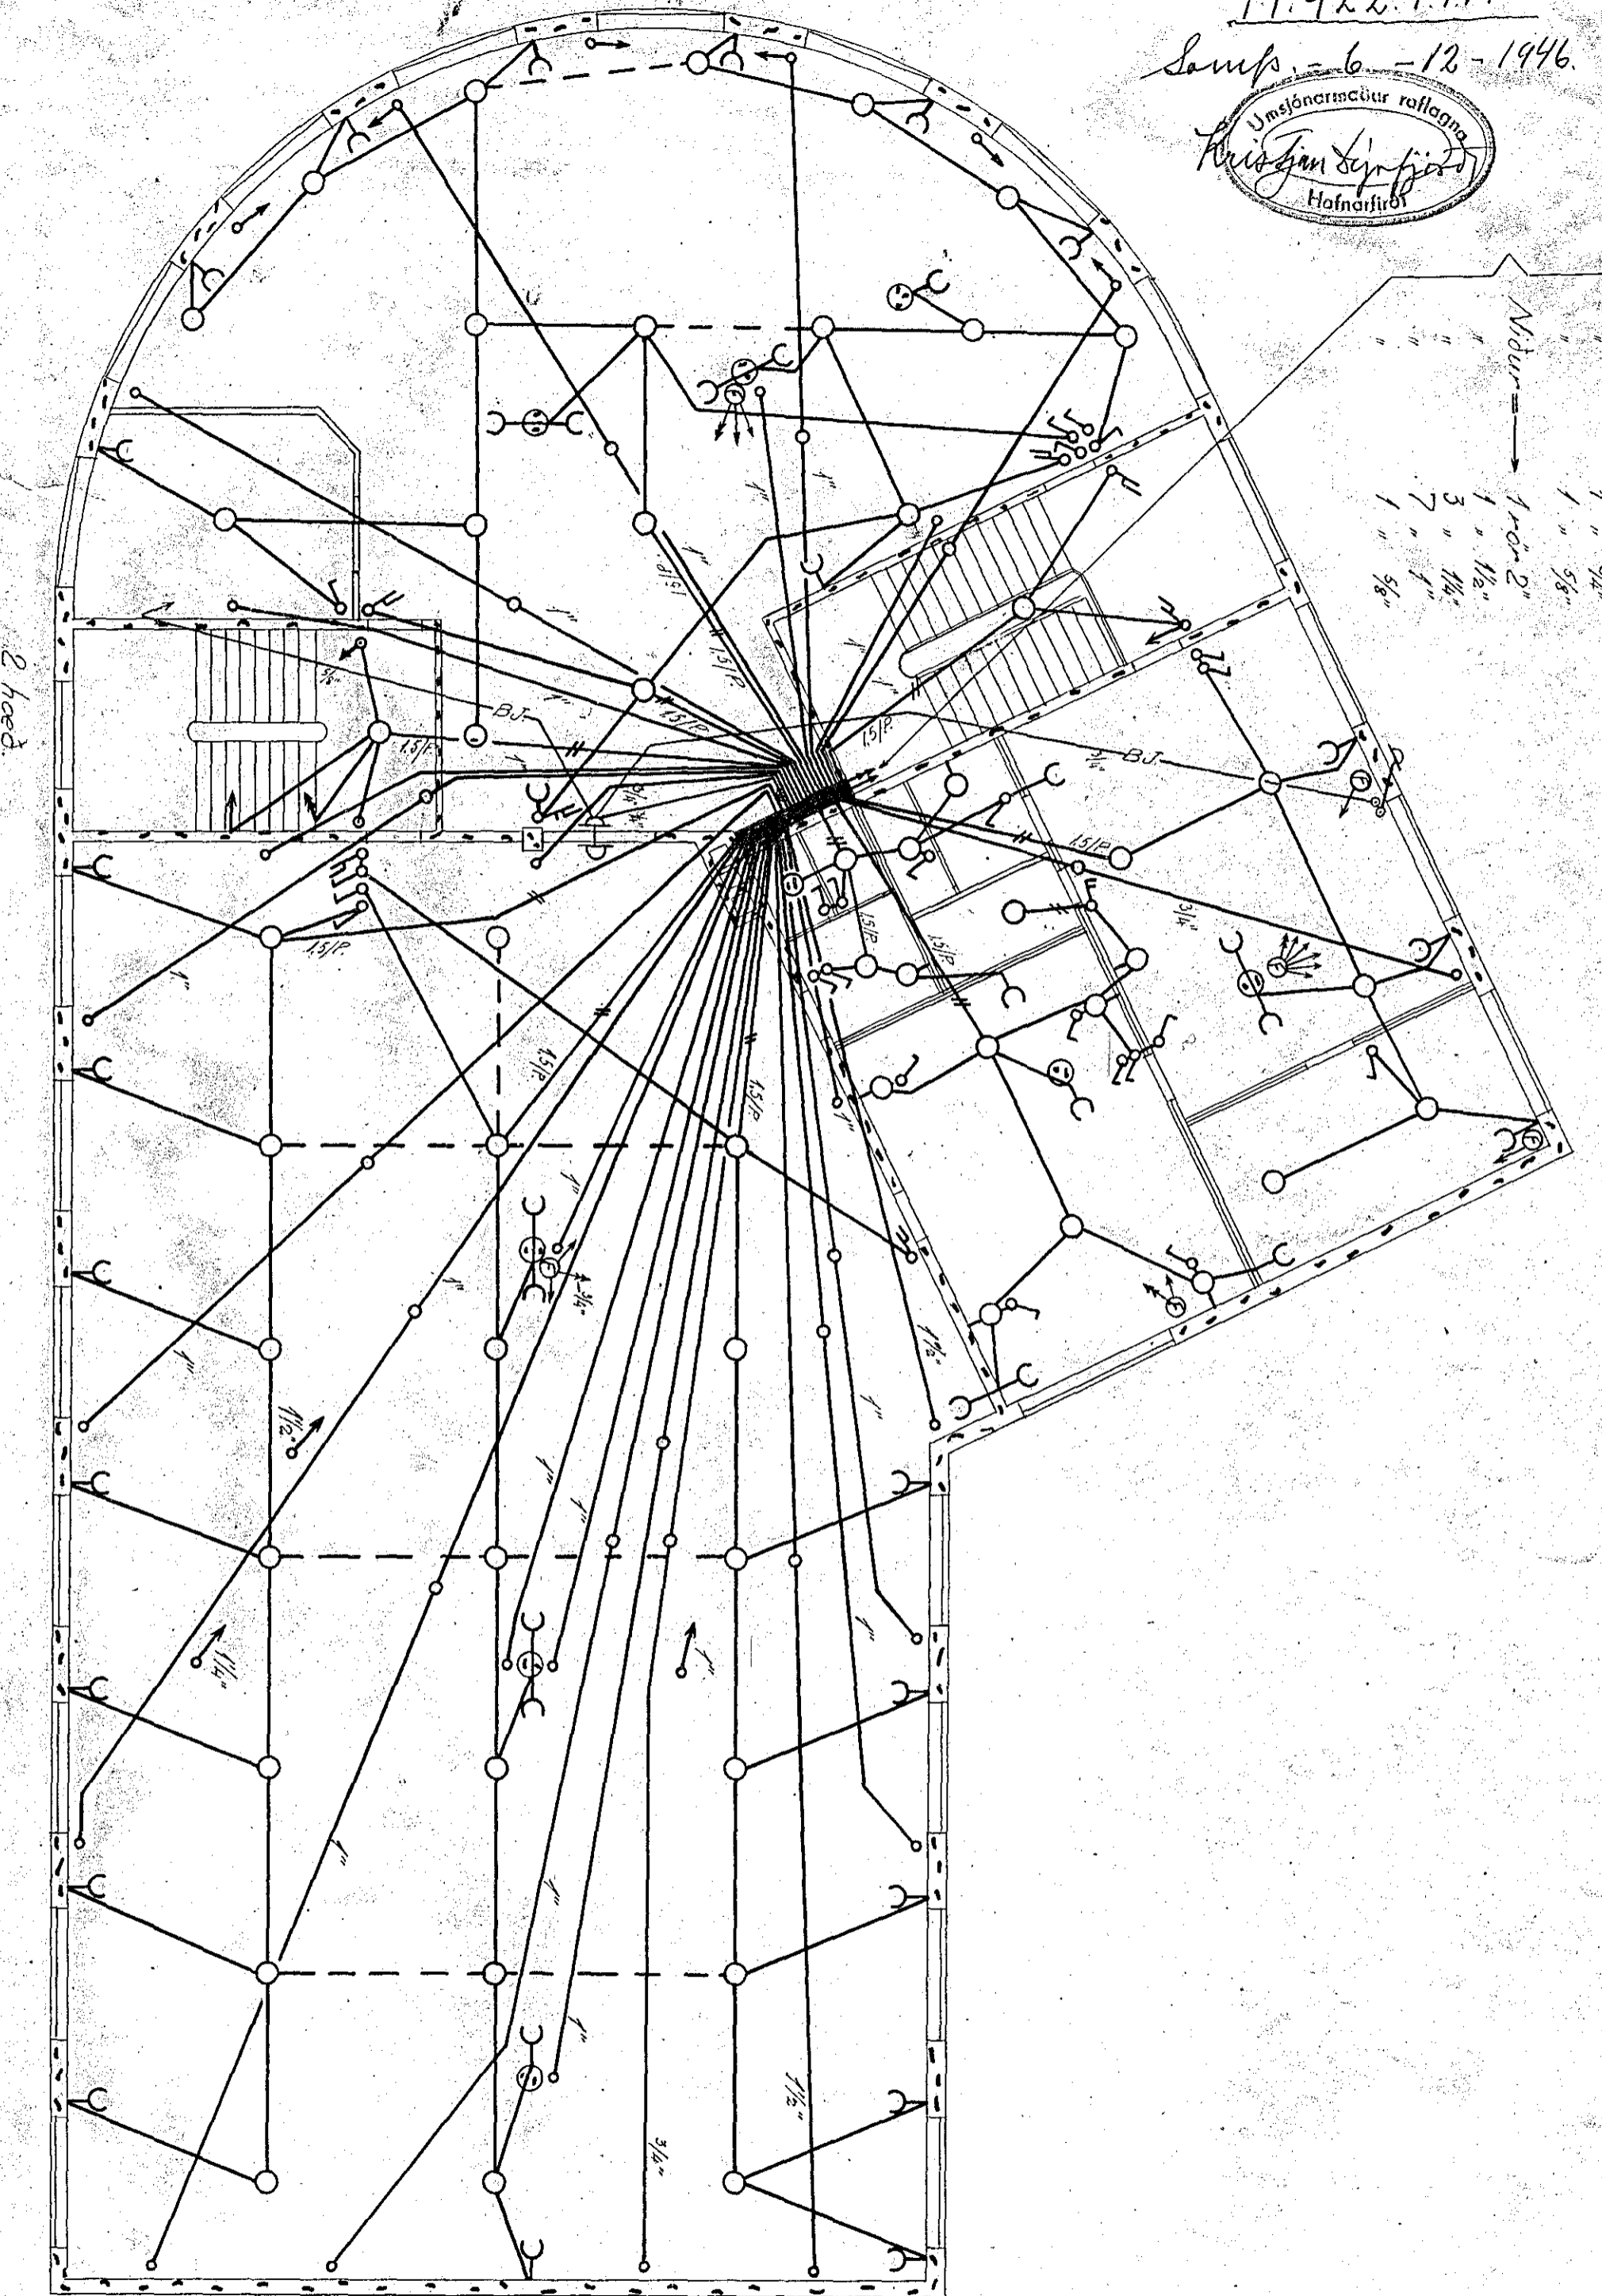

Skilgreining:

Fædd Tenglar: 13  
 Volar: 2  
 Summur: 2  
 Rolar: 1  
 9-Fellur burt

1. hæð	23	19	11	4	24
1. hæð	62	34	20	4	25
2. hæð	57	42	37	4	25
	155	97	70	9	67

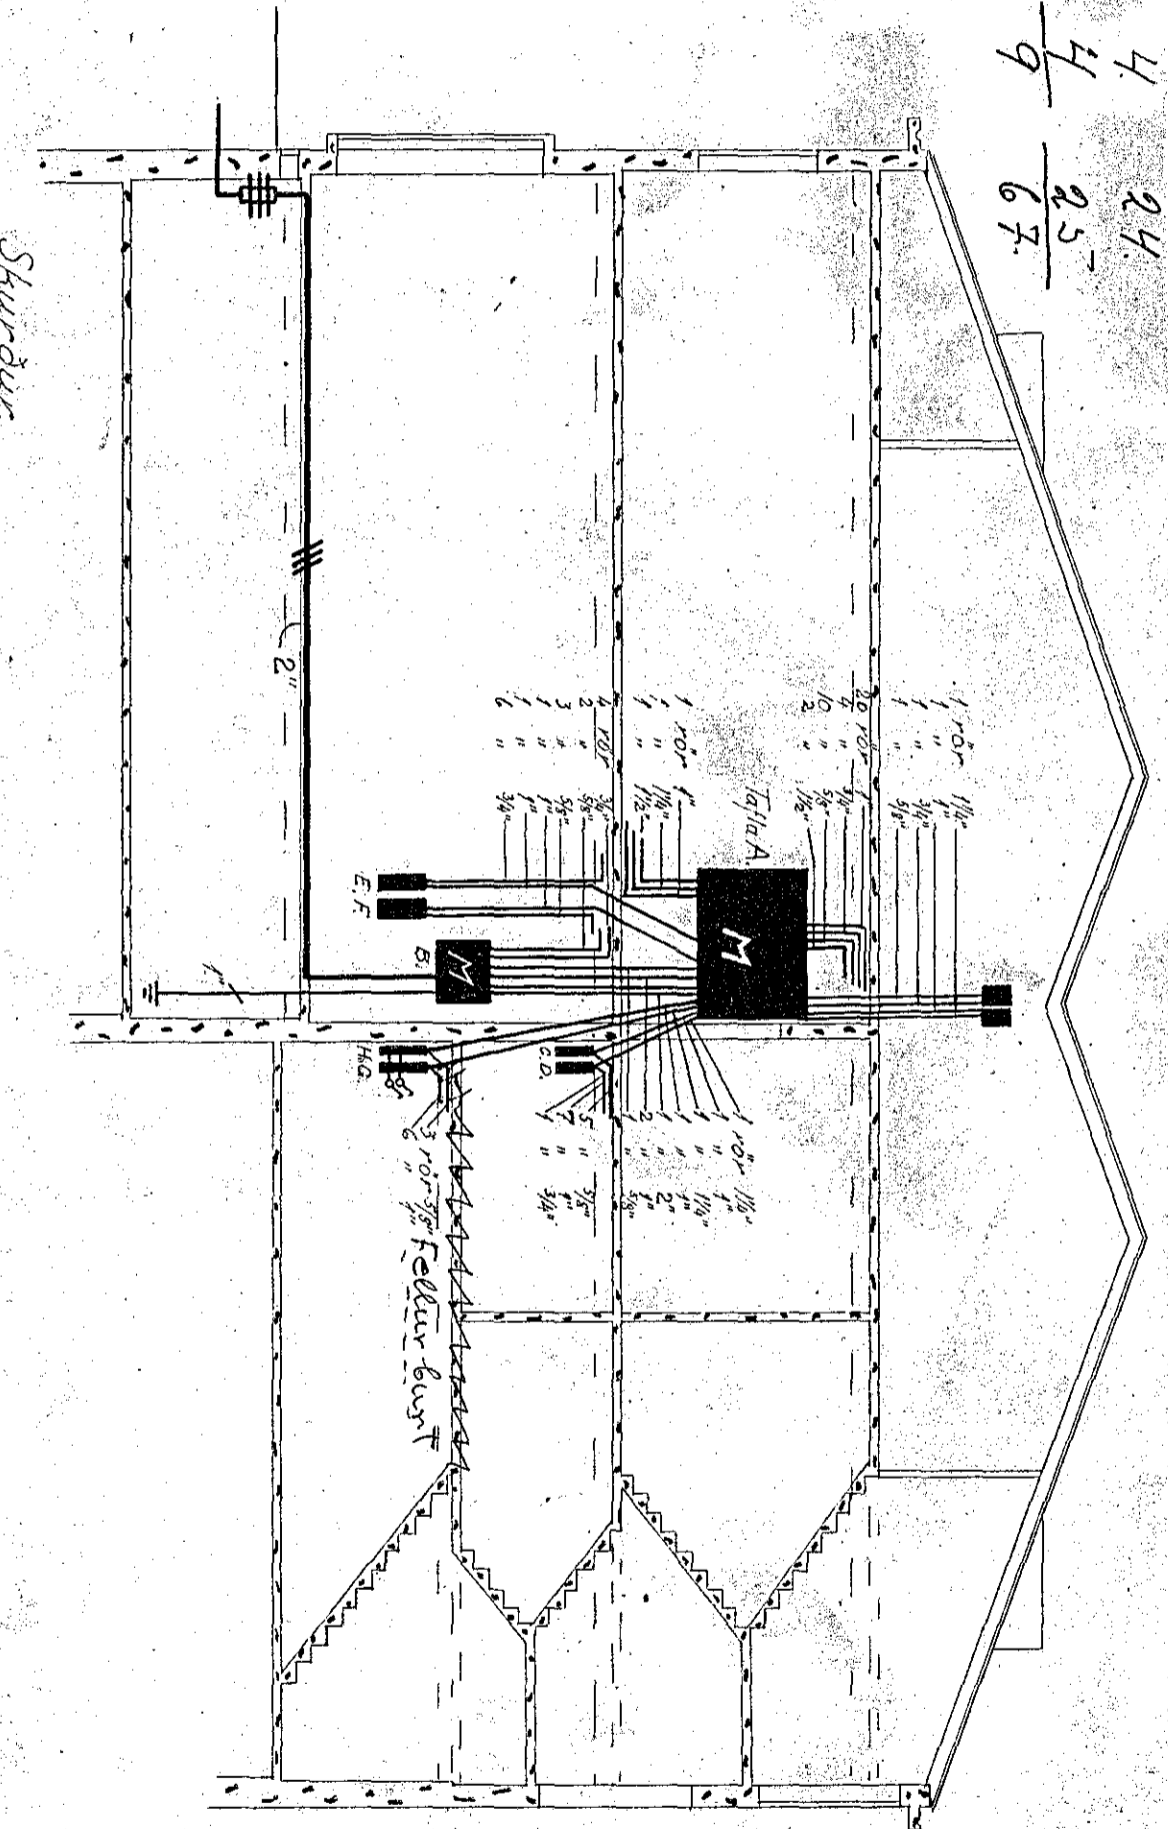

Rafloagn til ljosa  
 og veila í skipa  
 smíðastöðina  
 Dröfn  
 Hafnarfjarði.

Nr. 379  
 Blað II  
 Mhv. 1100  
 Ríkisútgefningin