



INNVEGGIR 1:50


V-1
HÚS NR 26

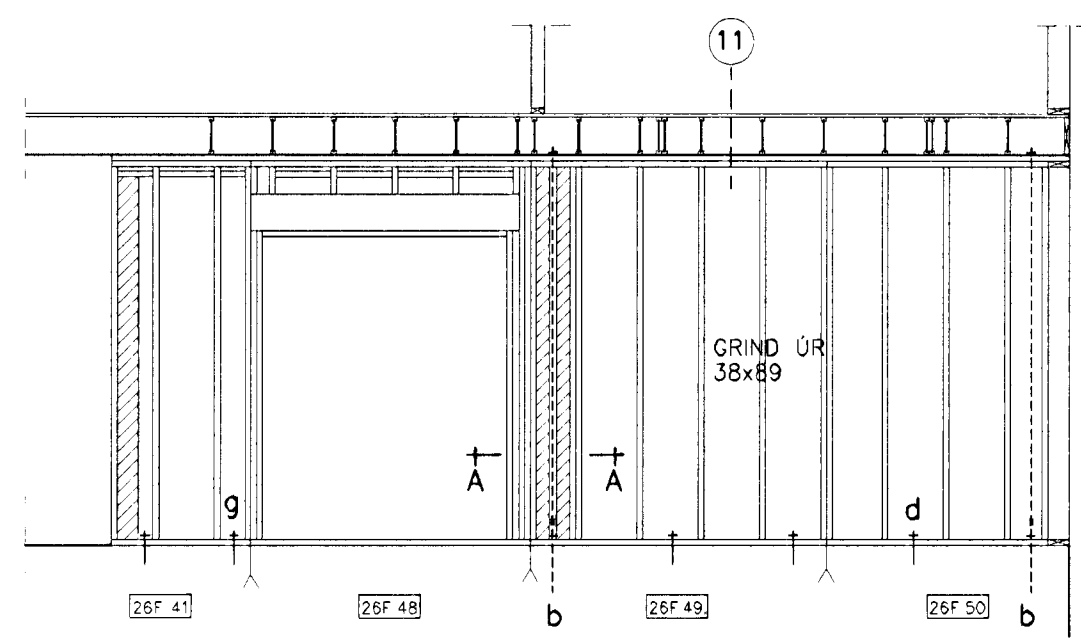


A-A 1:20

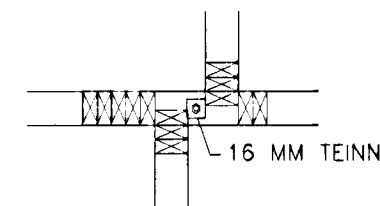

V-2
HÚS NR 26

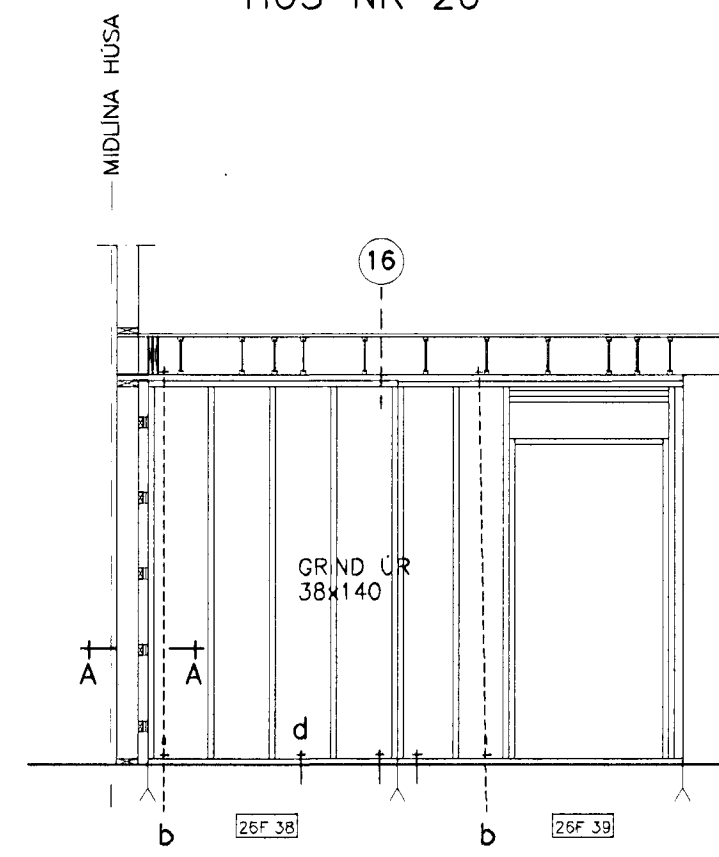


V-3
HÚS NR 26

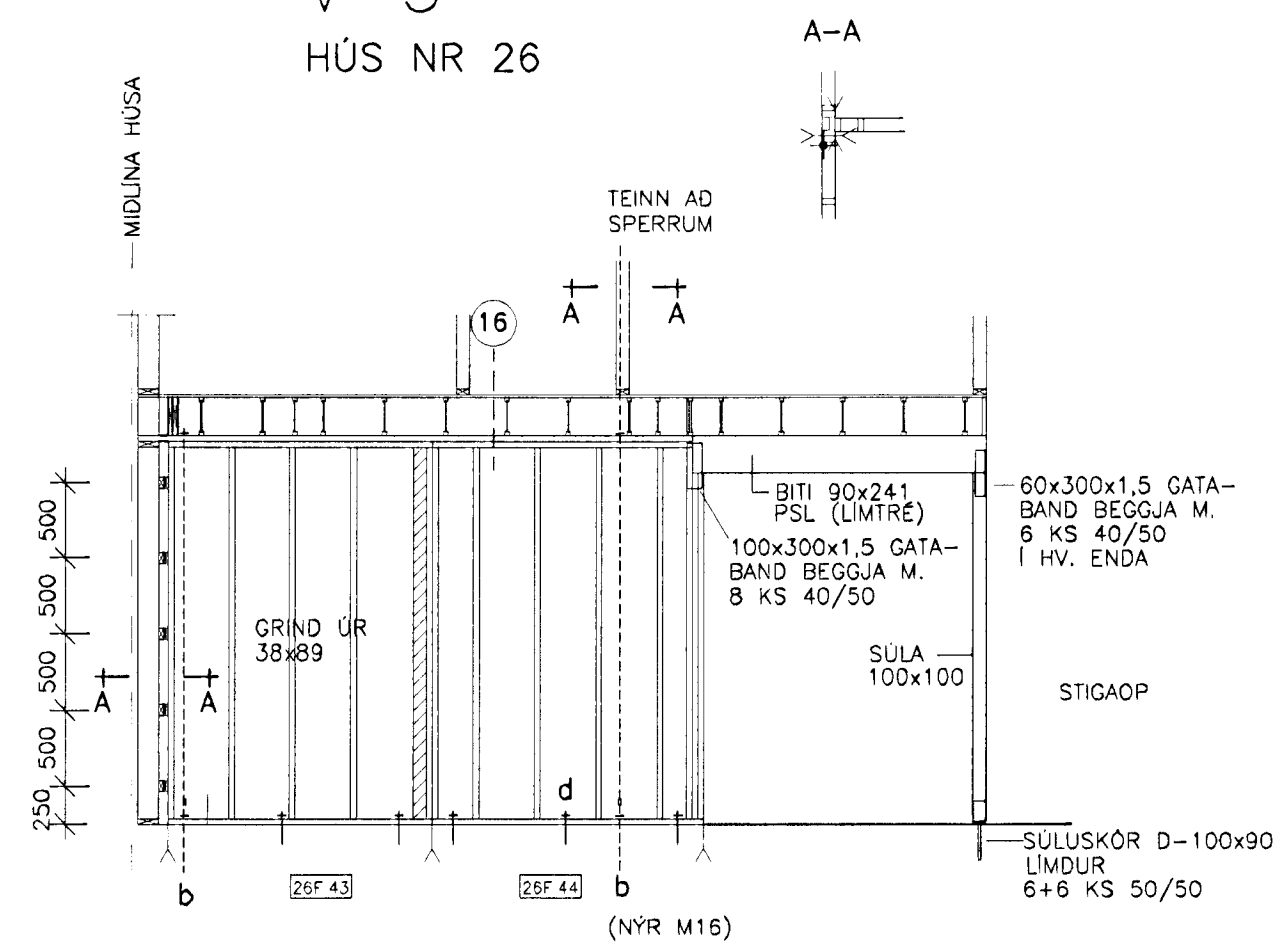


A-A 1:20


FESTING INNVEGGJA HORNRETT Á MIDVEGG HÚSA - BÆDI HÚS

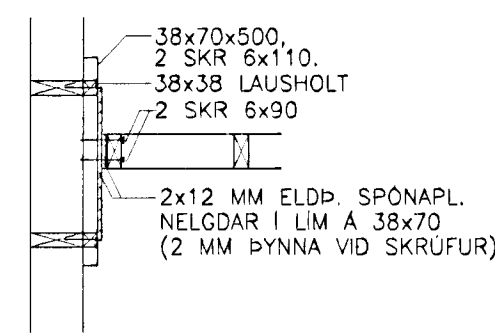


V-4
HÚS NR 26

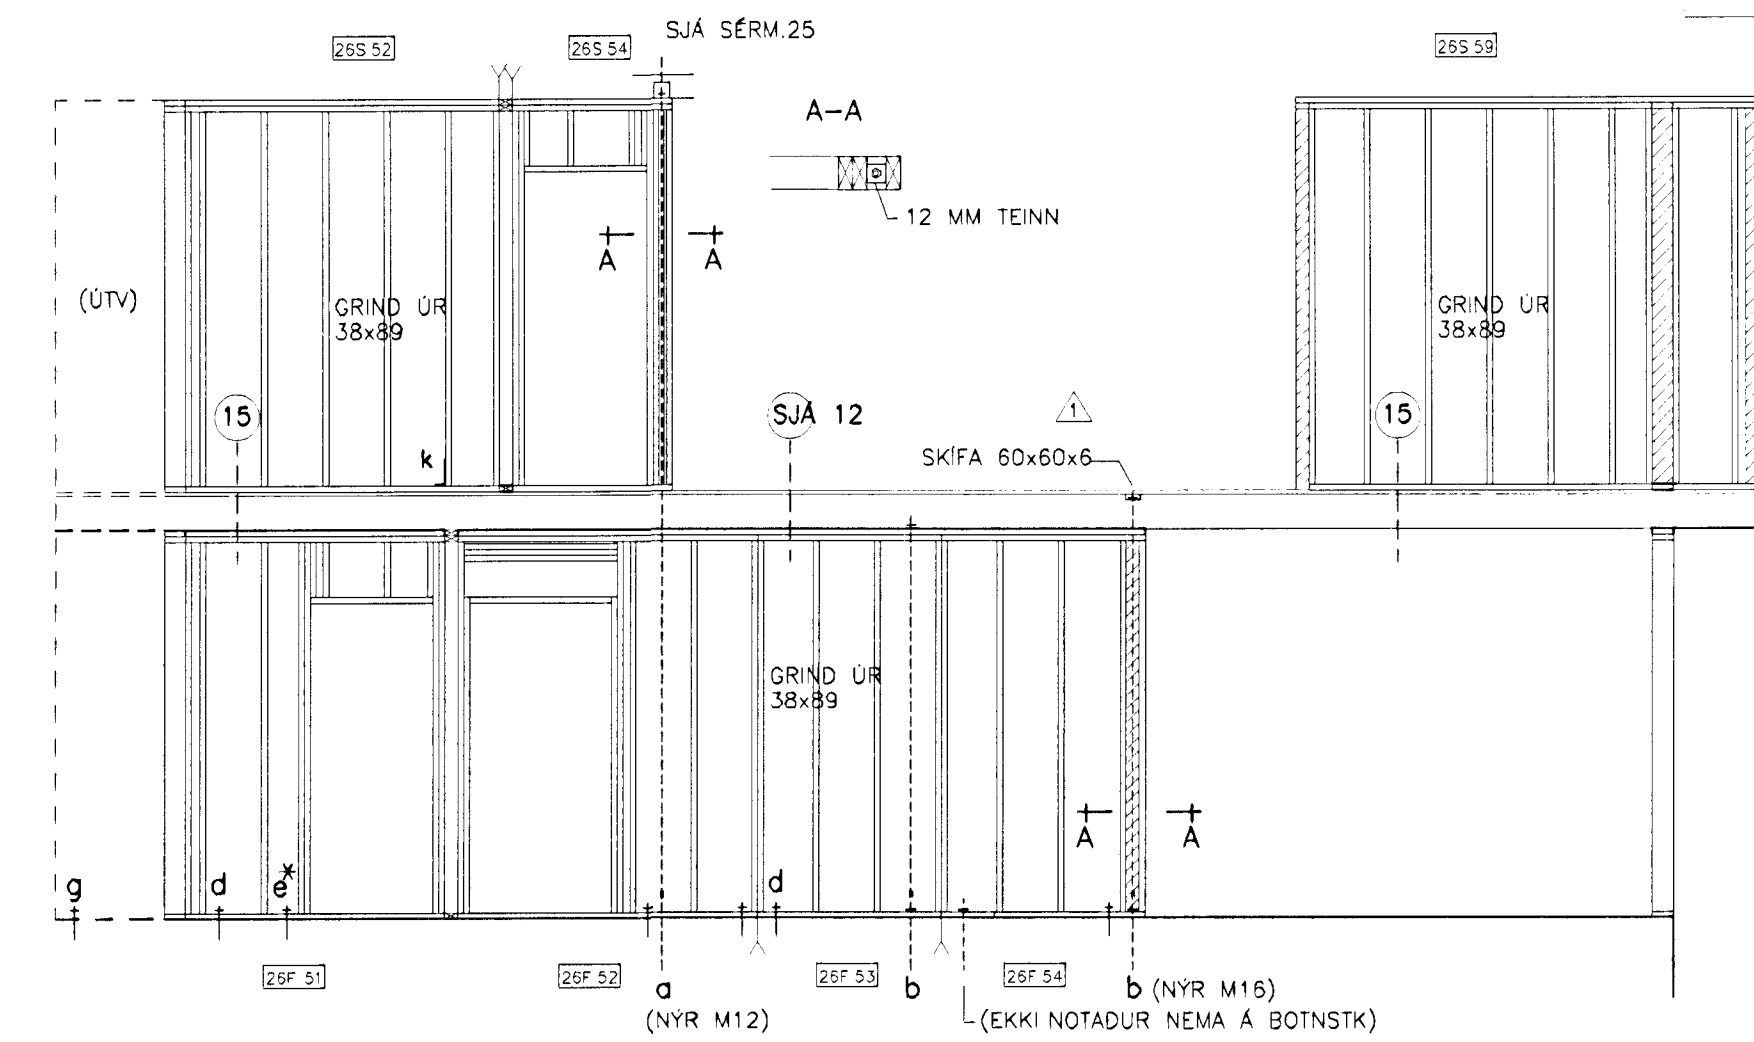


A-A 1:20

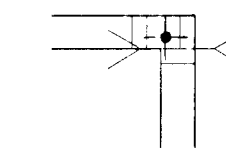


V-5
HÚS NR 26

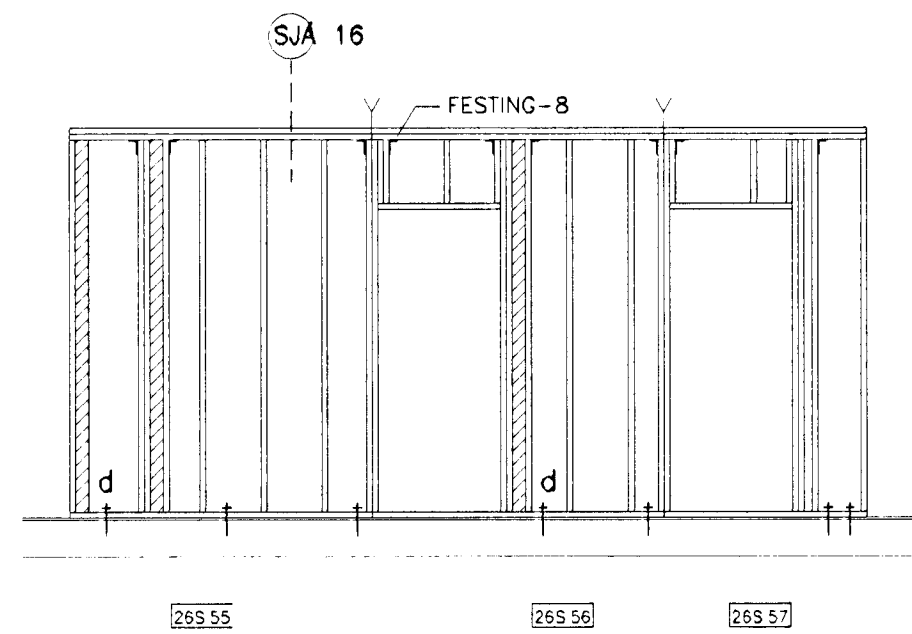

V-6
HÚS NR 26

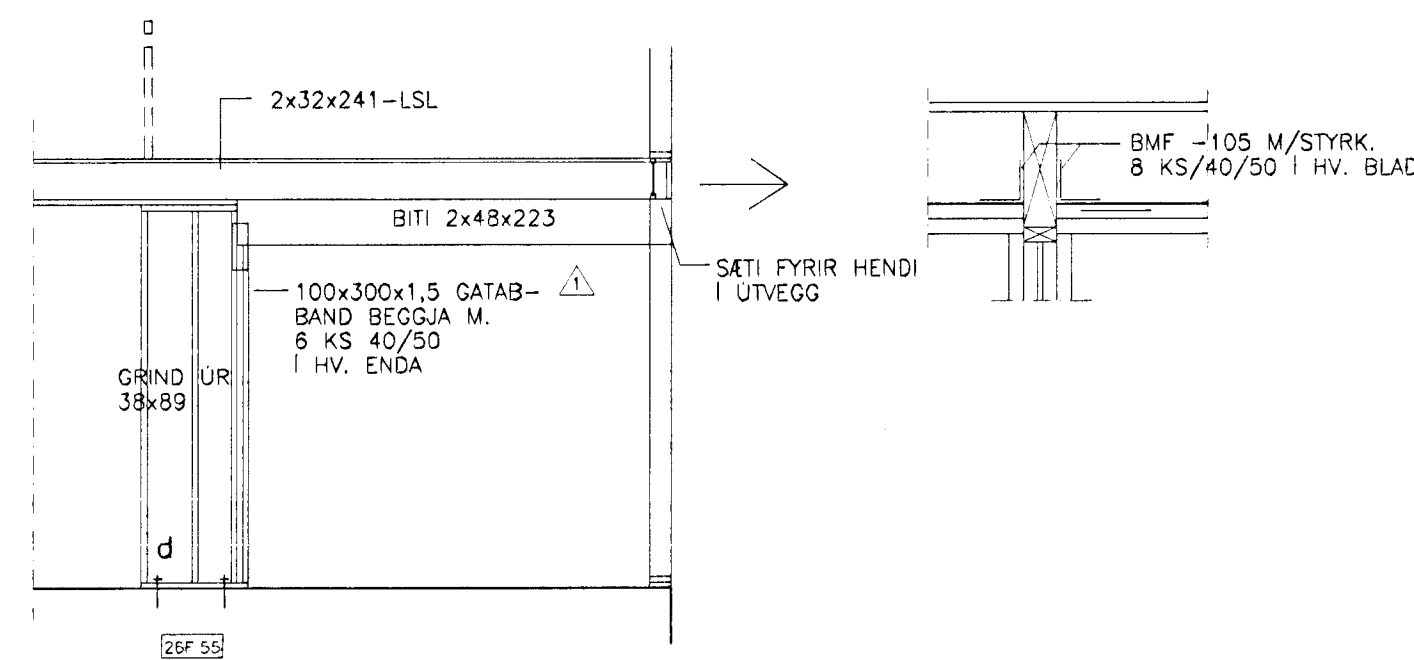

SKYRINGAR, SJÁ BLAD 203
SÉRMYNDIR, SJÁ BLAD 209 - 211

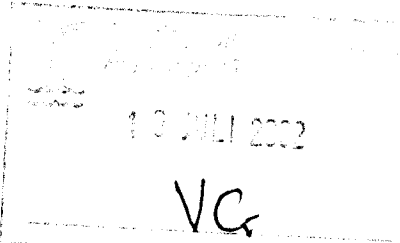

1.			
2.			
3.	01.07.2002	BITAVERSNIÐ Í VEGG 6. TEINN STYTTUR Í V-4.	DEPT
ARTUR	Kt 280439-3129		
VERFT.	ERLUÁS 26 OG 28 HAFNARFIRDI	VERF.	0116
TEKING.	HÚS 26 BURDARVIRKI -INNVEGGIR, HLIÐARMYNDIR	TEKING.	BJM PG 08.05.2002 1:50 1:20 BJM
ÞORSTEINN MAGNÚSSON - BYGGINGARVERKFRÆÐINGUR VERKFRÆÐISTOFA ALDBREKKU 6 200 KÓPAVOGI SIMI 551 9940 FAX 551 9945		TEKINGUR	207