


GRUNNMYND NEDRIHÆÐAR 1:50

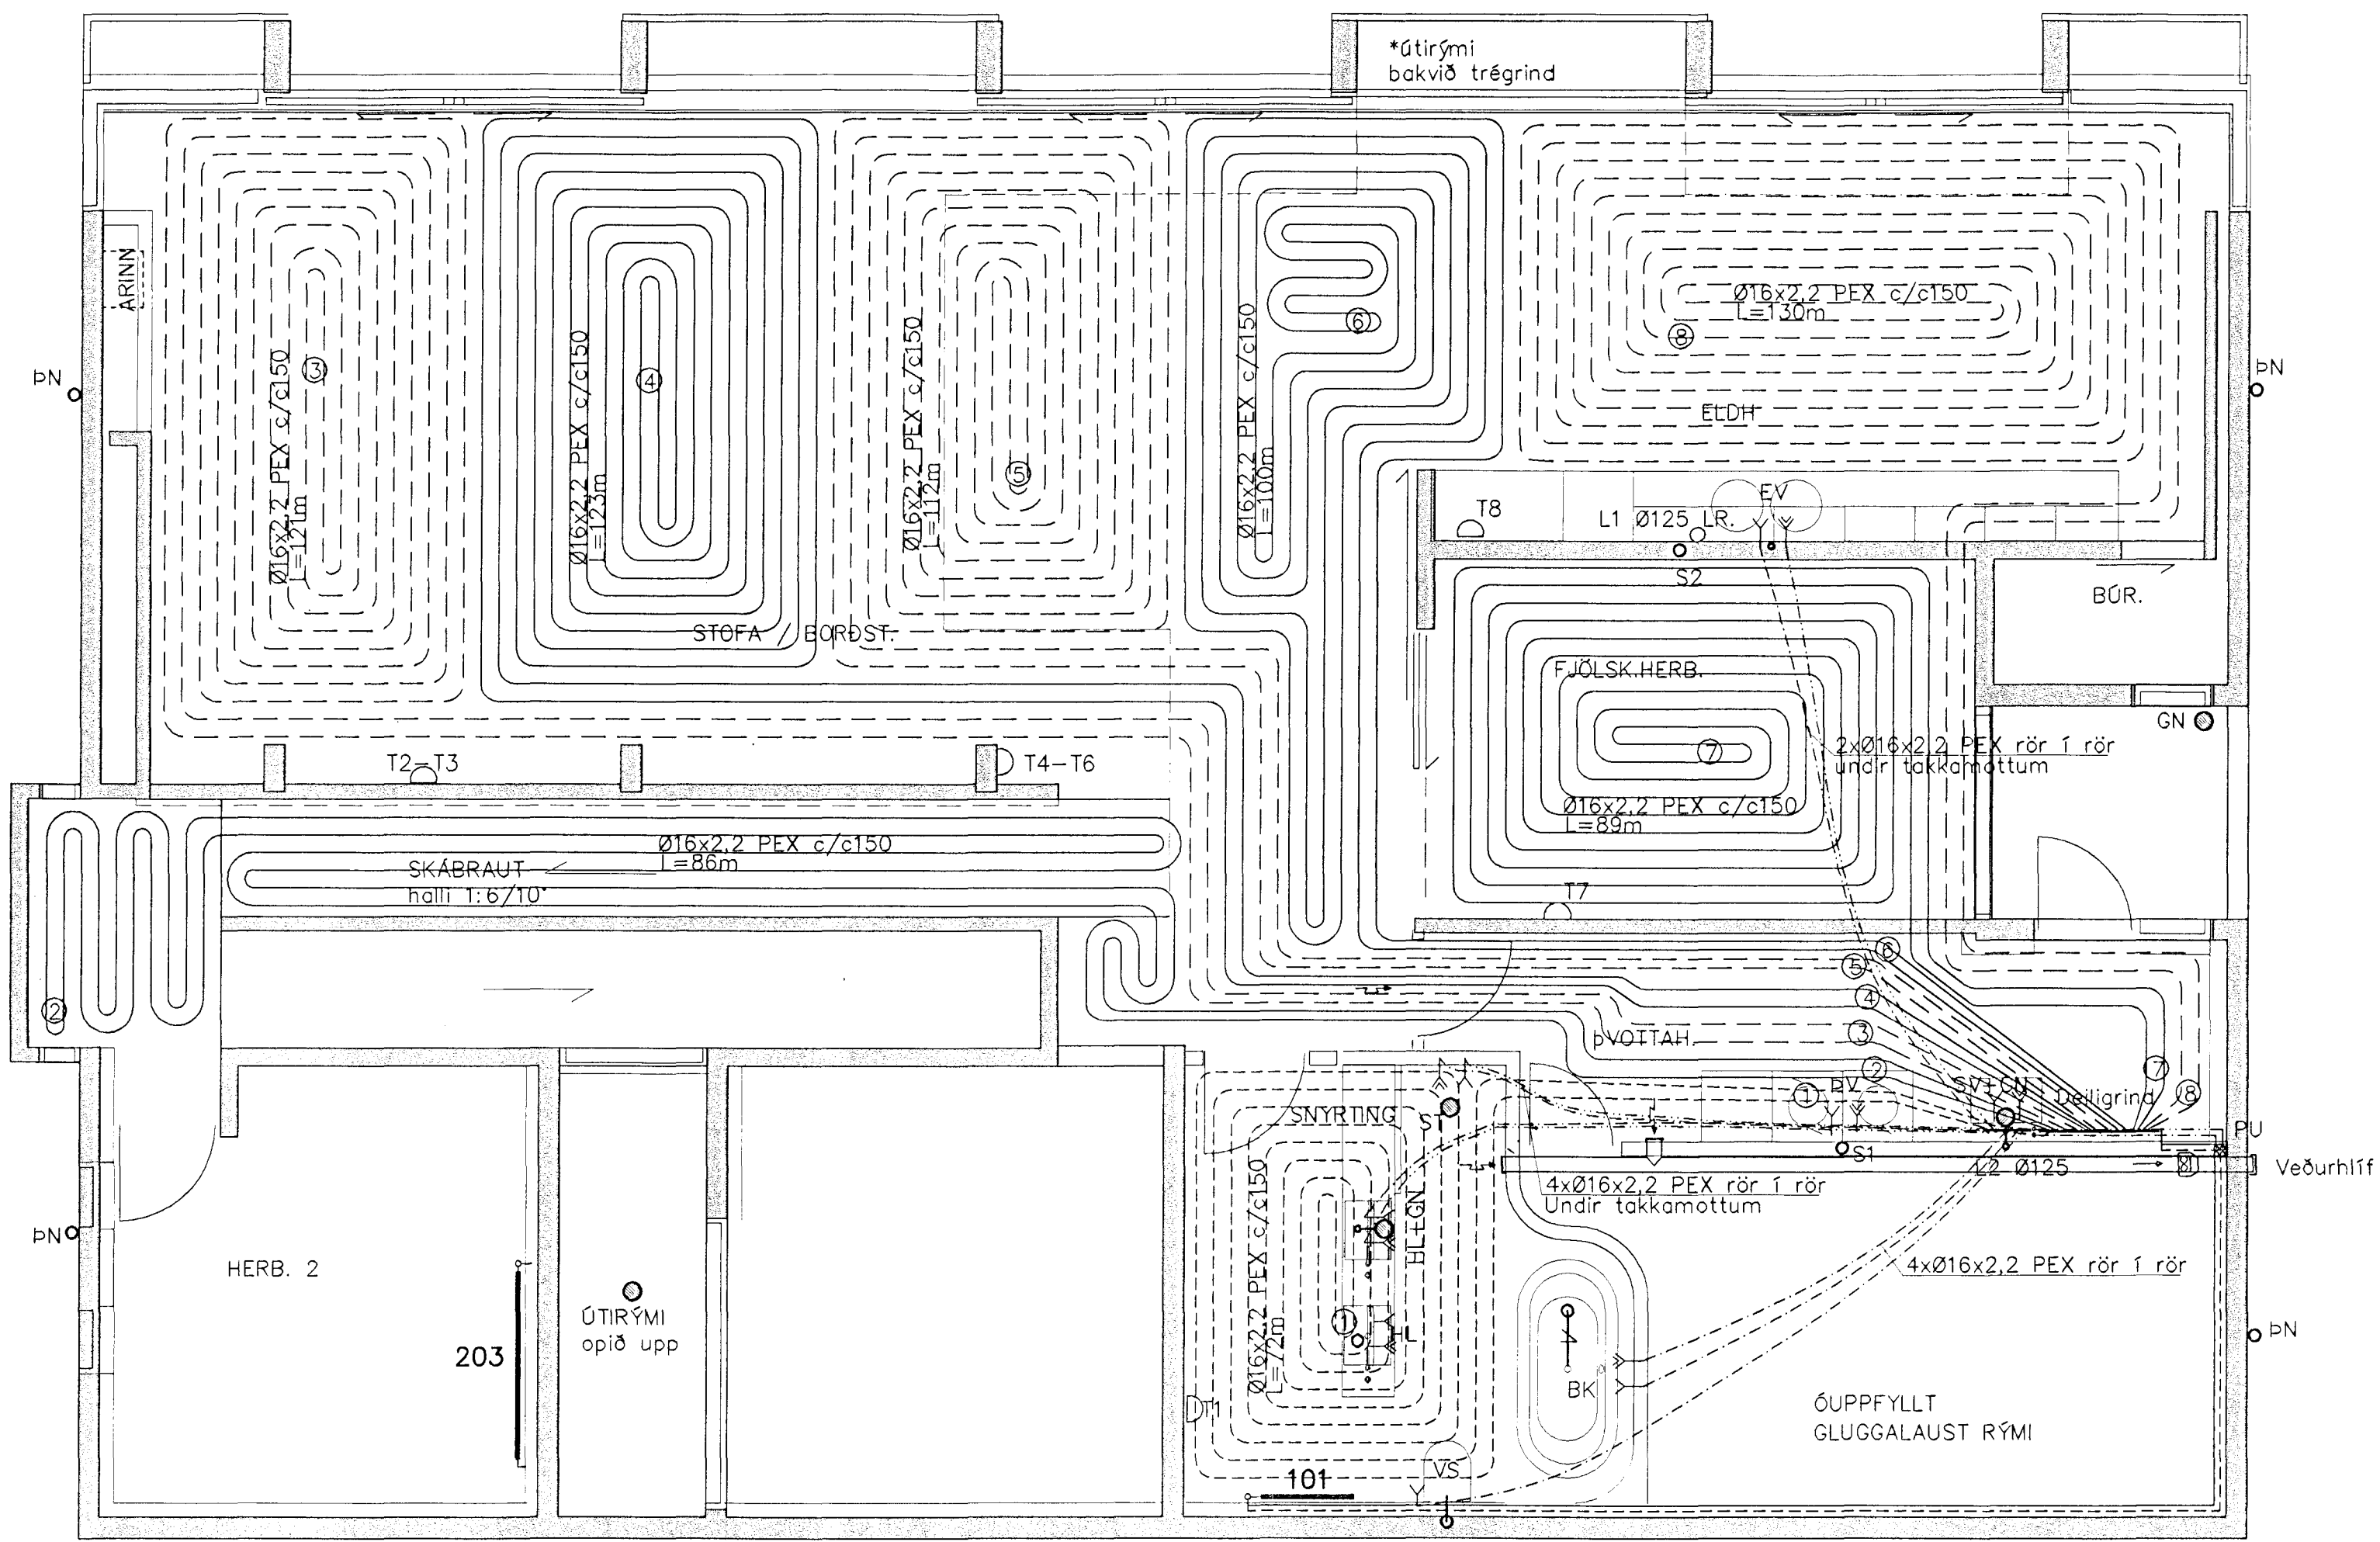


Ofnaskrá

Ofnar skulu vera vottaðir af Rannsóknarstofnun Byggingariðnaðarins samkvæmt ÍST EN-442
Ofnar delta-t=40°C Ofnatengi = 10mm

númer	rými	wött/klst	ofnategund	ofnloki	stilla-tala
101	Bað	526	Handkl. 600,H=1160	FJVR-10	
Samtals wött/klst		526			

Afköst gólfhita:

Slaufa Nr: 1	68m	750	wött/klst
Slaufa Nr: 2	86m	945	wött/klst
Slaufa Nr: 3	121m	1330	wött/klst
Slaufa Nr: 4	123m	1350	wött/klst
Slaufa Nr: 5	112m	1230	wött/klst
Slaufa Nr: 6	100m	1100	wött/klst
Slaufa Nr: 7	86m	945	wött/klst
Slaufa Nr: 8	128m	1400	wött/klst
Slaufa Nr: 9	27m	300	wött/klst
Samtals		797m	9380 wött/klst

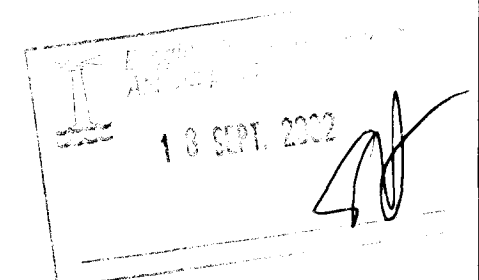

*1 Lagnaleiðir færast í lagnarými, ofn 103 fellur út.

Breytingar			Nr.	Dags.	Nafn	ERLUÁS 35, HAFNARFJ. Verkfræðistofa Þráinn & Benedikt Laugavegi 178, 105 Rvk Sími: 553 1770, 568 7775, Fax: 568-7701 Netfang: post@islandia.is	H Þ K T HS S M 1:50 Nr. P101
Hiti, vatn, frárennsli og loftr. neðrihæð							
1	12.09.02	BK					Dags. feb.'02 090638-4939