




GRUNNMYND ÞAKS, 1:50

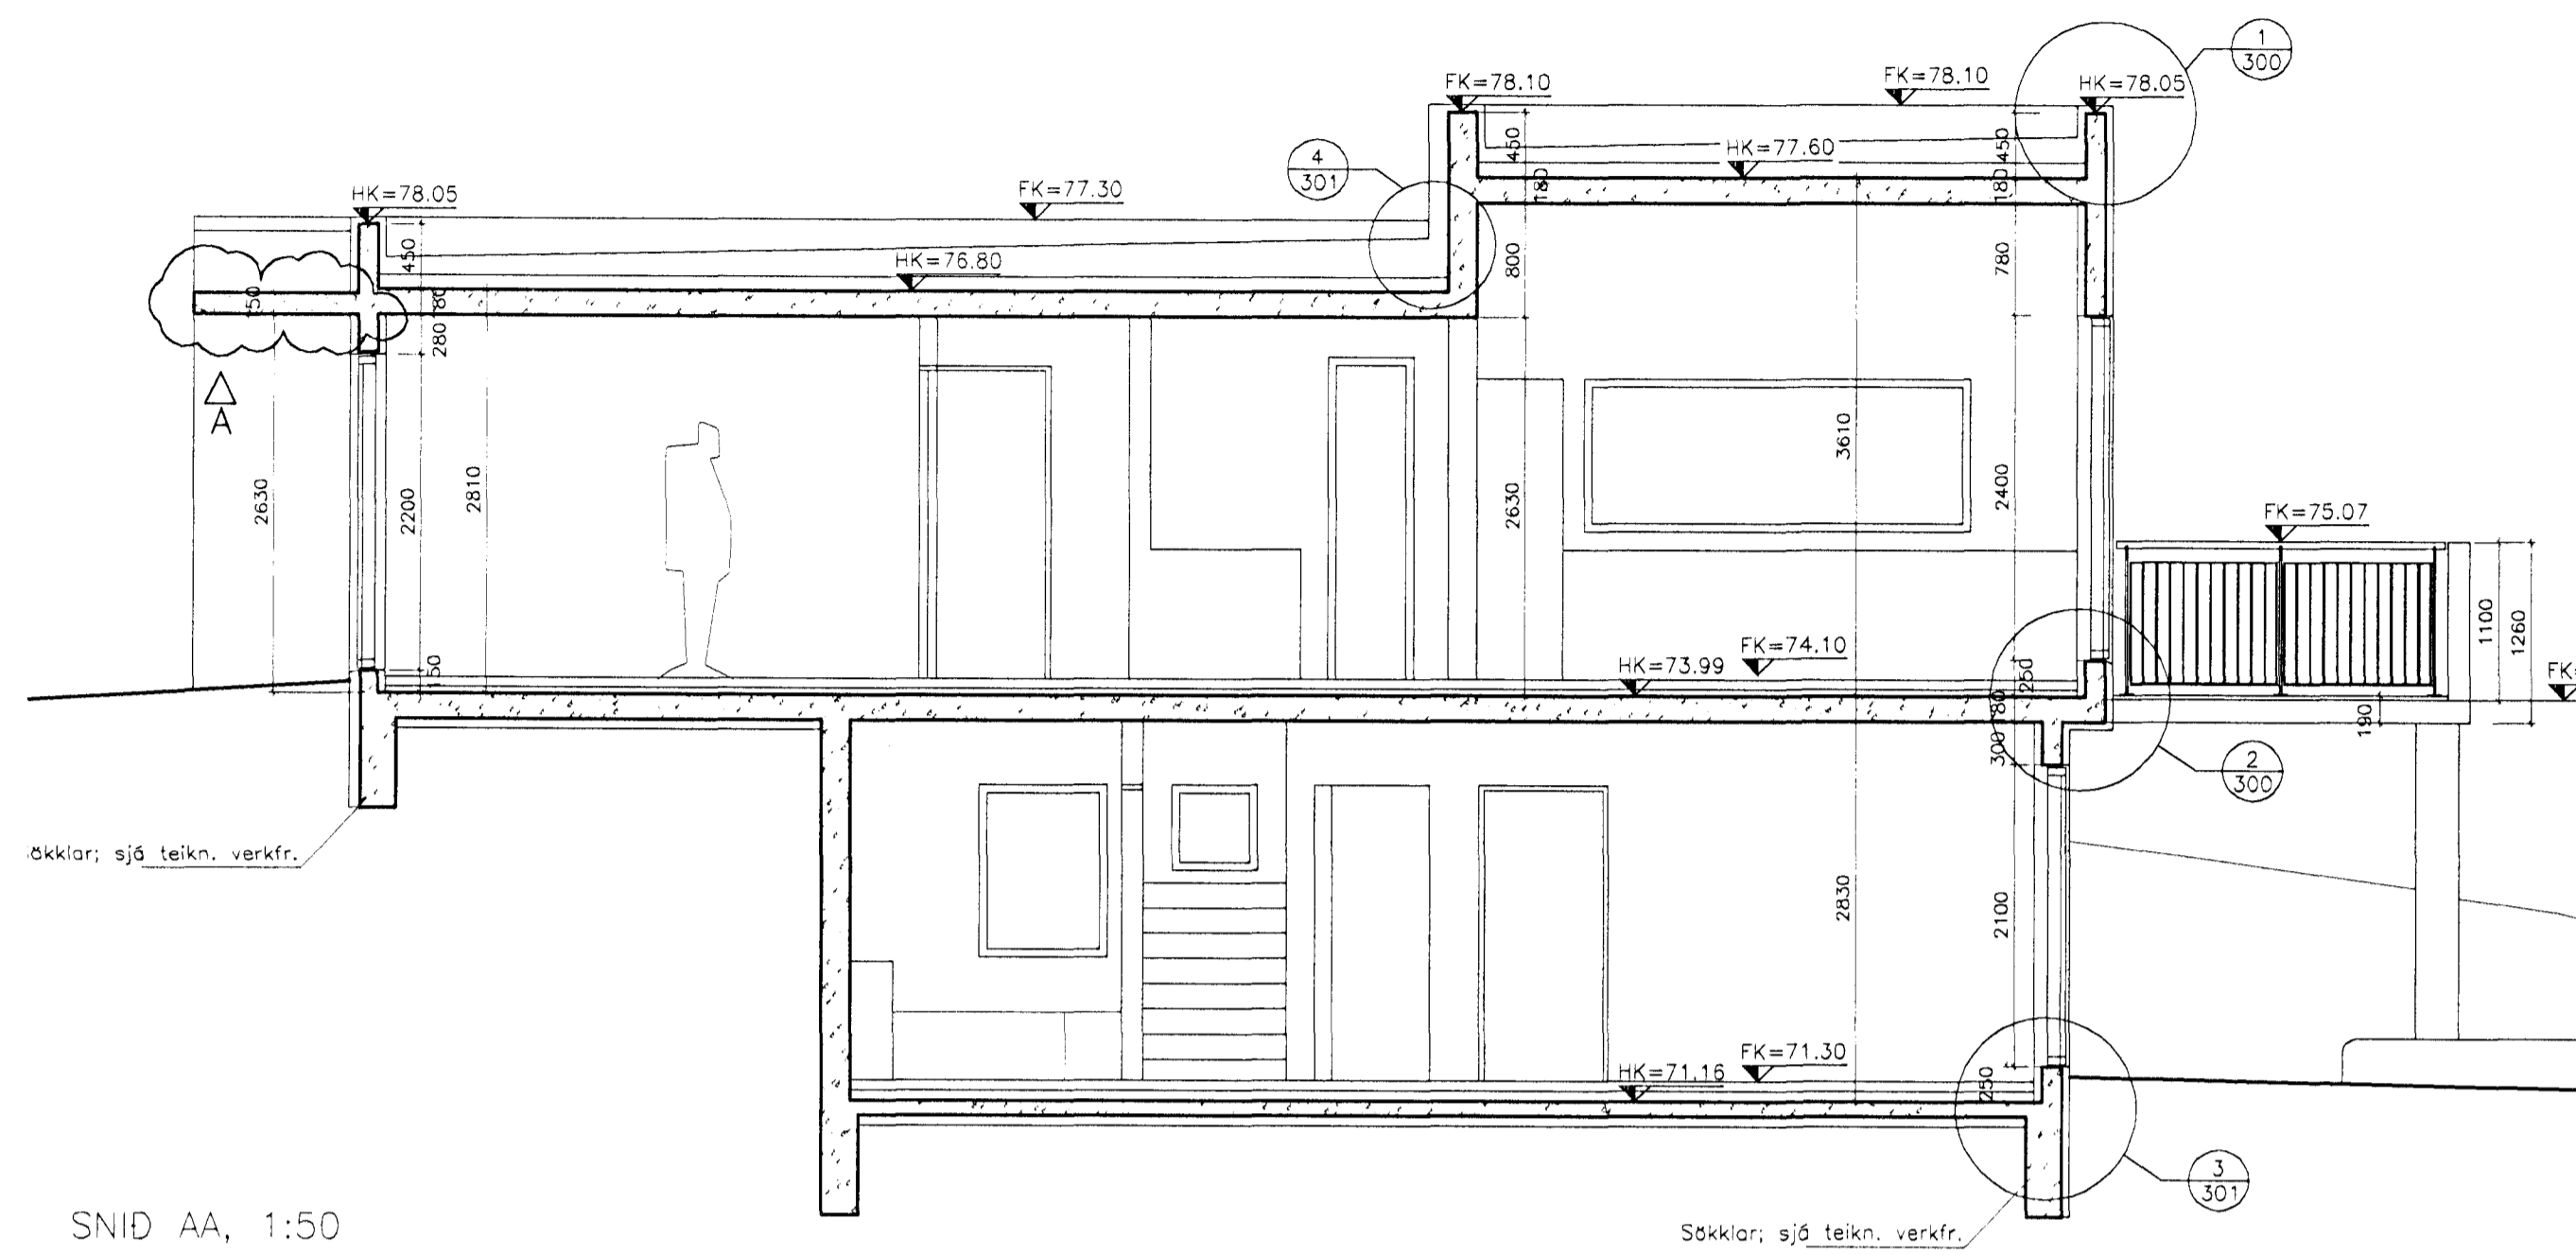

SNID AA, 1:50

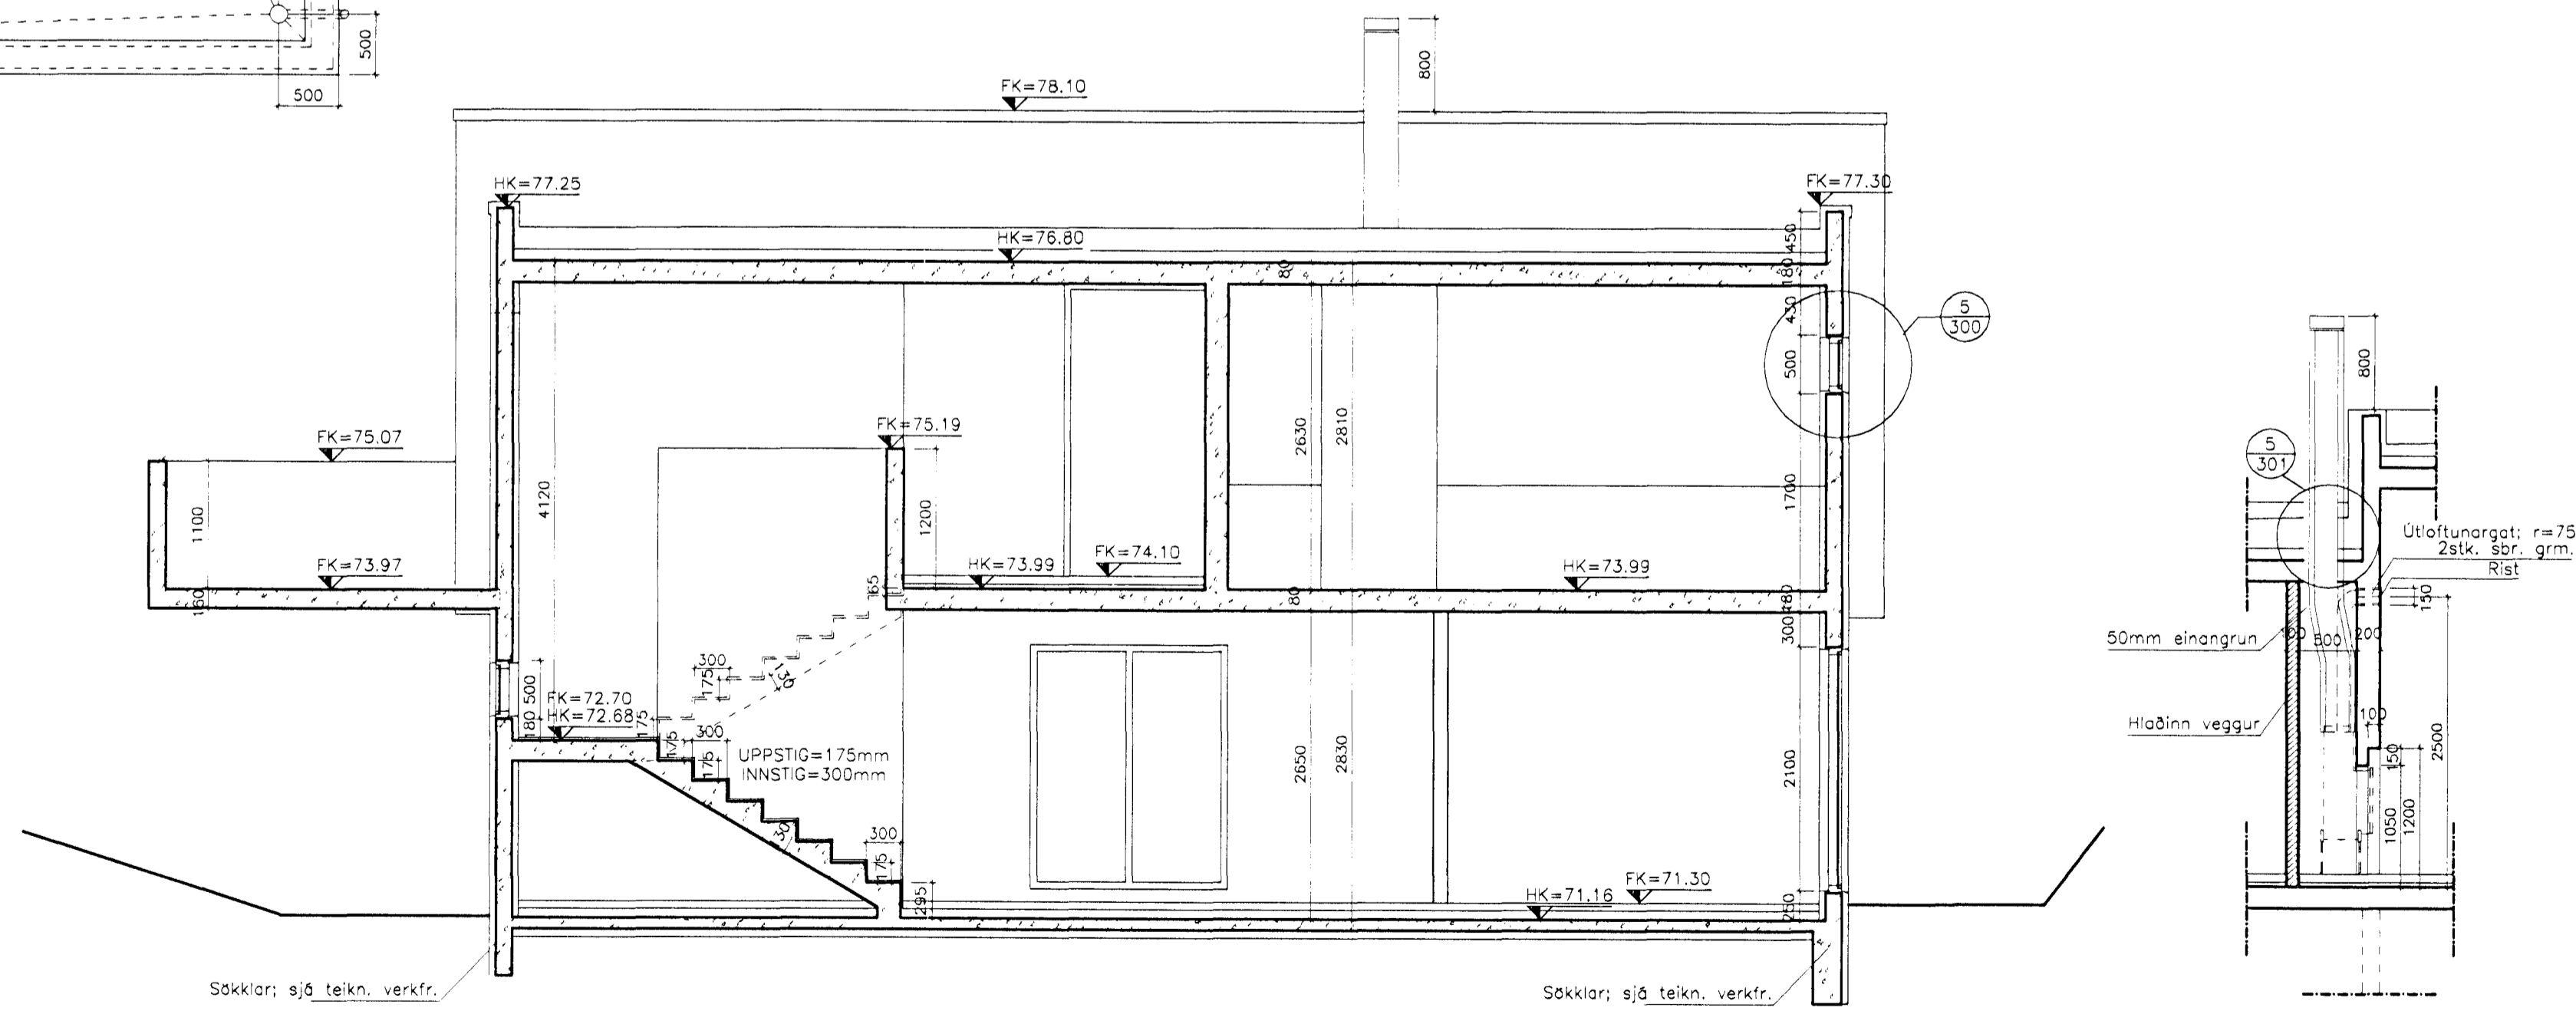

SNID BB, 1:50

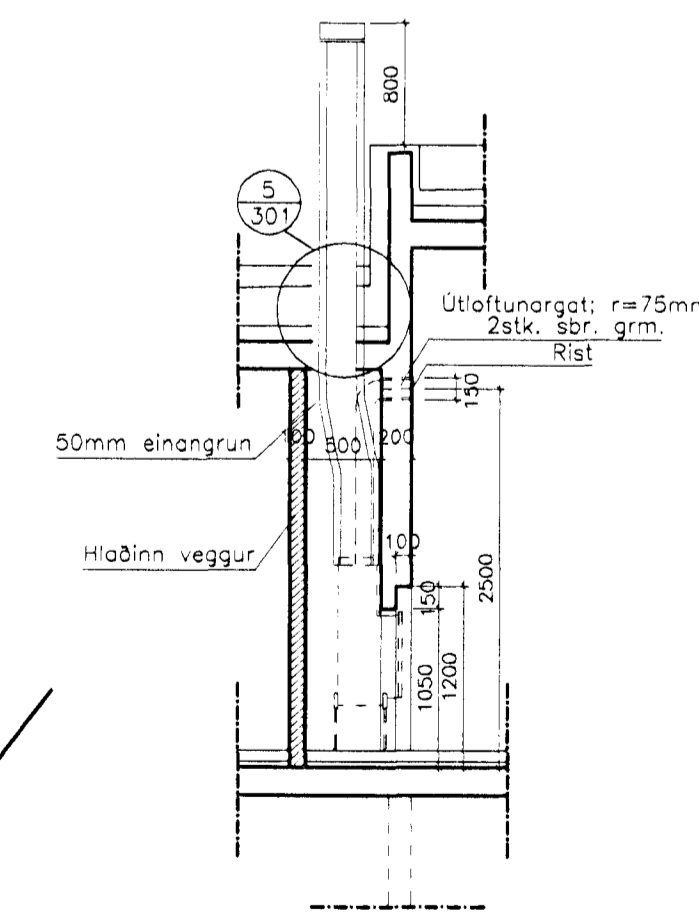

SNID CC, 1:50

D:
C:
B:
A: Skyggni yfir inngang 21.02.02
BREYTINGAR: DAGS:

25.10.2002
[Signature]

ERLUÁS 58, HAFNARFIRDI
VERKTEIKNING
ÞAKMYND
SNID AA-BB-CC

VERK: ERLU-0104
KVARÐI: 1:50
DAGS: 20.11.01
TEIKN: LME
SKRÁ:

Lagi Már Einarsson. 210801286
Lagi Már Einarsson arkitekt fat
Bæjarholti 5, 220 Hafnarfirði
Sími 551 7714 - 694 1325