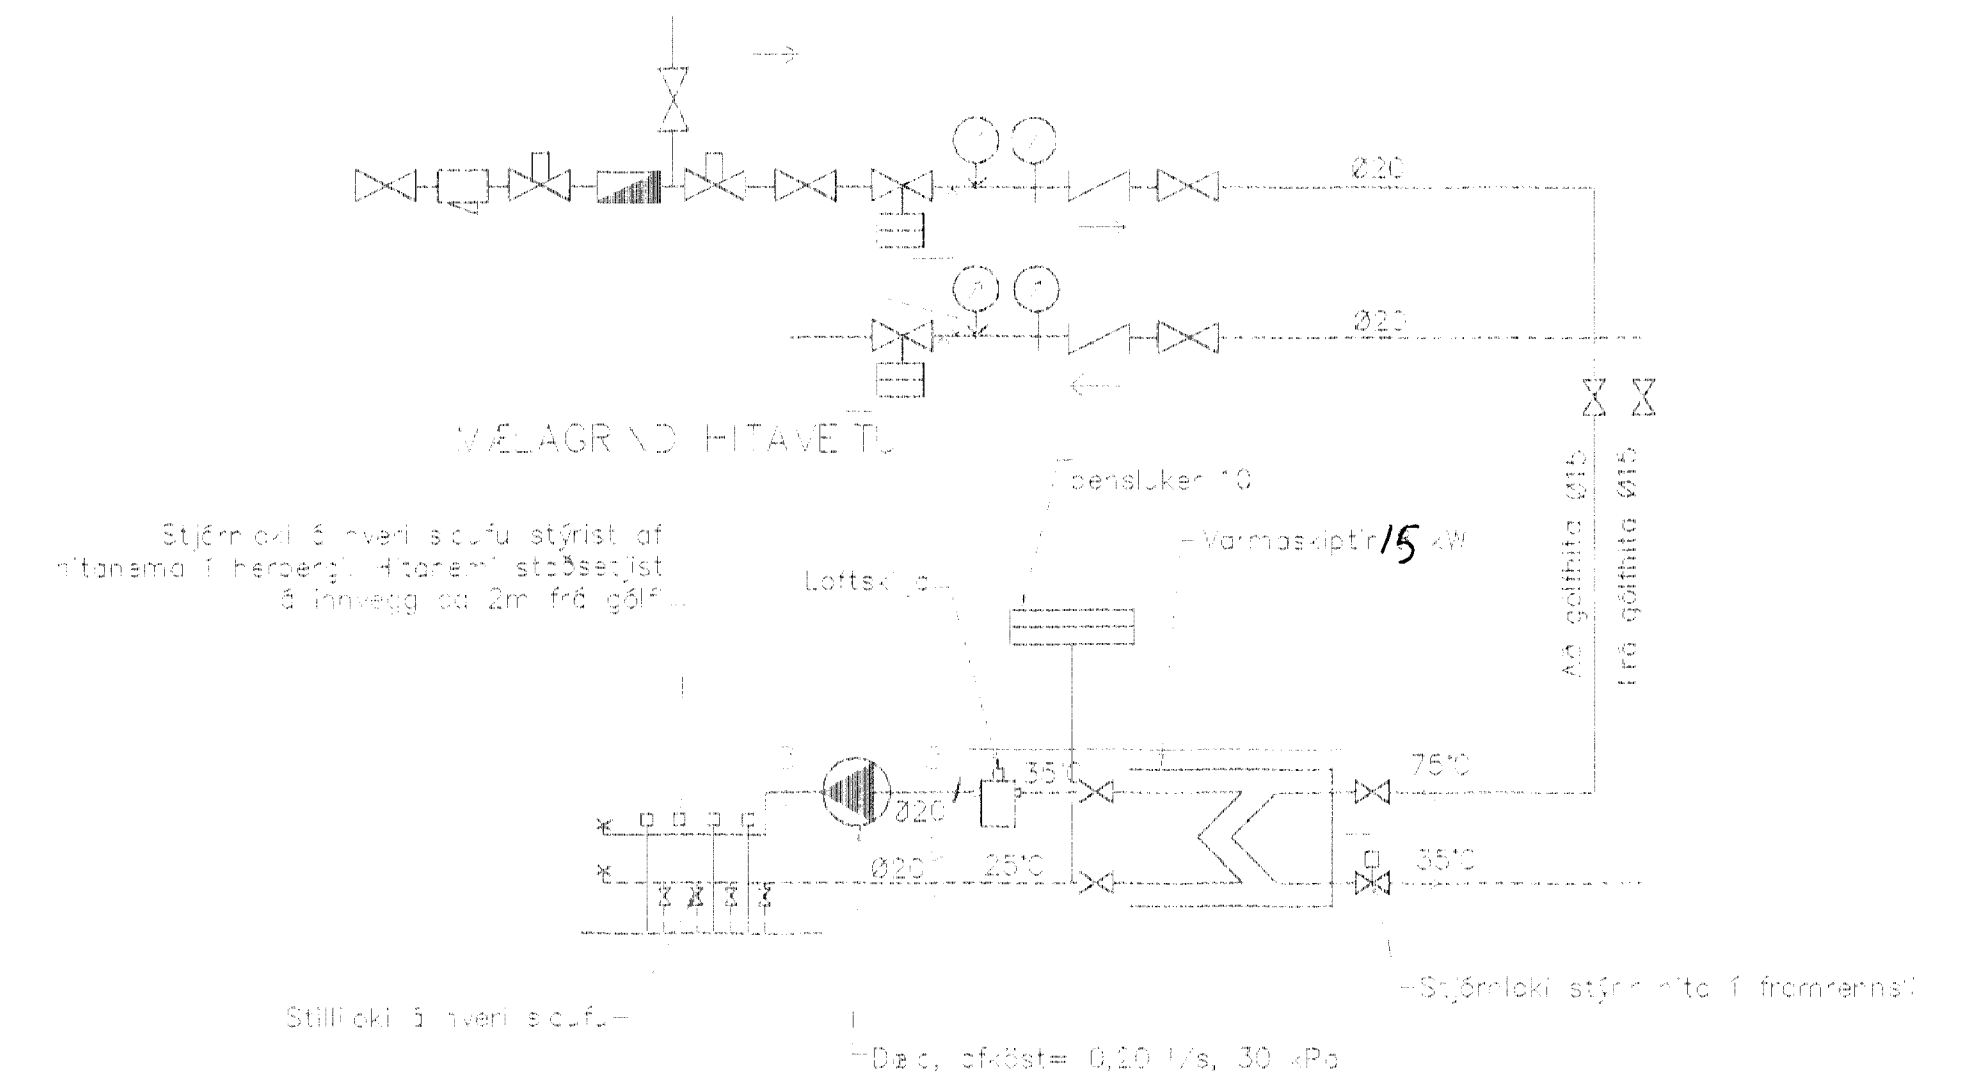


Grunnmynd 1/50



TENING GÓLFHITA

GÓLFHITALAGNR  
23x2,25 Pa-PEX c/c200  
SJA SNIB

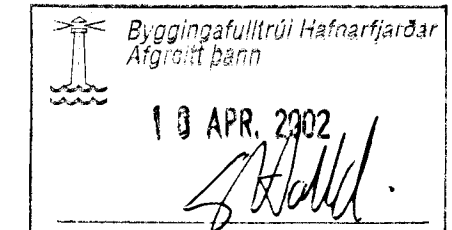

GÓLFHITA LAGNR  
12x2,0 Pa-PEX c/c 200

JÓLFERNI      STENPT FLATA

WAFI ABENDING

EINANGRUPA

GÓLFHITA SNIB 1:20

Br.	Daga	Eðli breytinga	Sign.
ERLUÁS 60 HAFNARFIRDI			
GÓLFHITA			
 13 APR. 2002 <i>[Signature]</i>			
MÁK. 1:50 1:20			
DAGS. APRIL 2002			
VERK NR. 2-17			
TEIKN. NR. 2-02			
MANNAD. nrj 241-48-3000			
TEIKNAD. G.H.			
YFIRFAKIS			
 TJEKNINGUNETA SUREAR ÞORLEIFSSONAR ehf. STRANDGÖTU 11 220 HAFNARFIRDI Sími 565-4265 FAX 535-2876 E-póst tækni@tjknuneta.is			