


Á KILID, ELDRI
TÆKNING ÓGILD

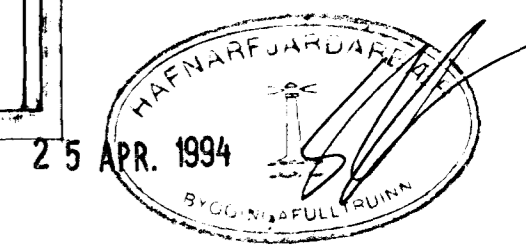

BREYTT Í MARS 1995

HERMANN ISEBARN	MTFI
EYRARHOLT NR.12, HAFNARFIRDI	
MÁL	1:50
DAGS.	OKT. 1991
BLAD	5
FRÁRENNISLIS, VATNS OG HITALAGNIR GRUNNMYND 2. OG 3.HÆÐAR	
<i>Hermann Iseborn</i>	