
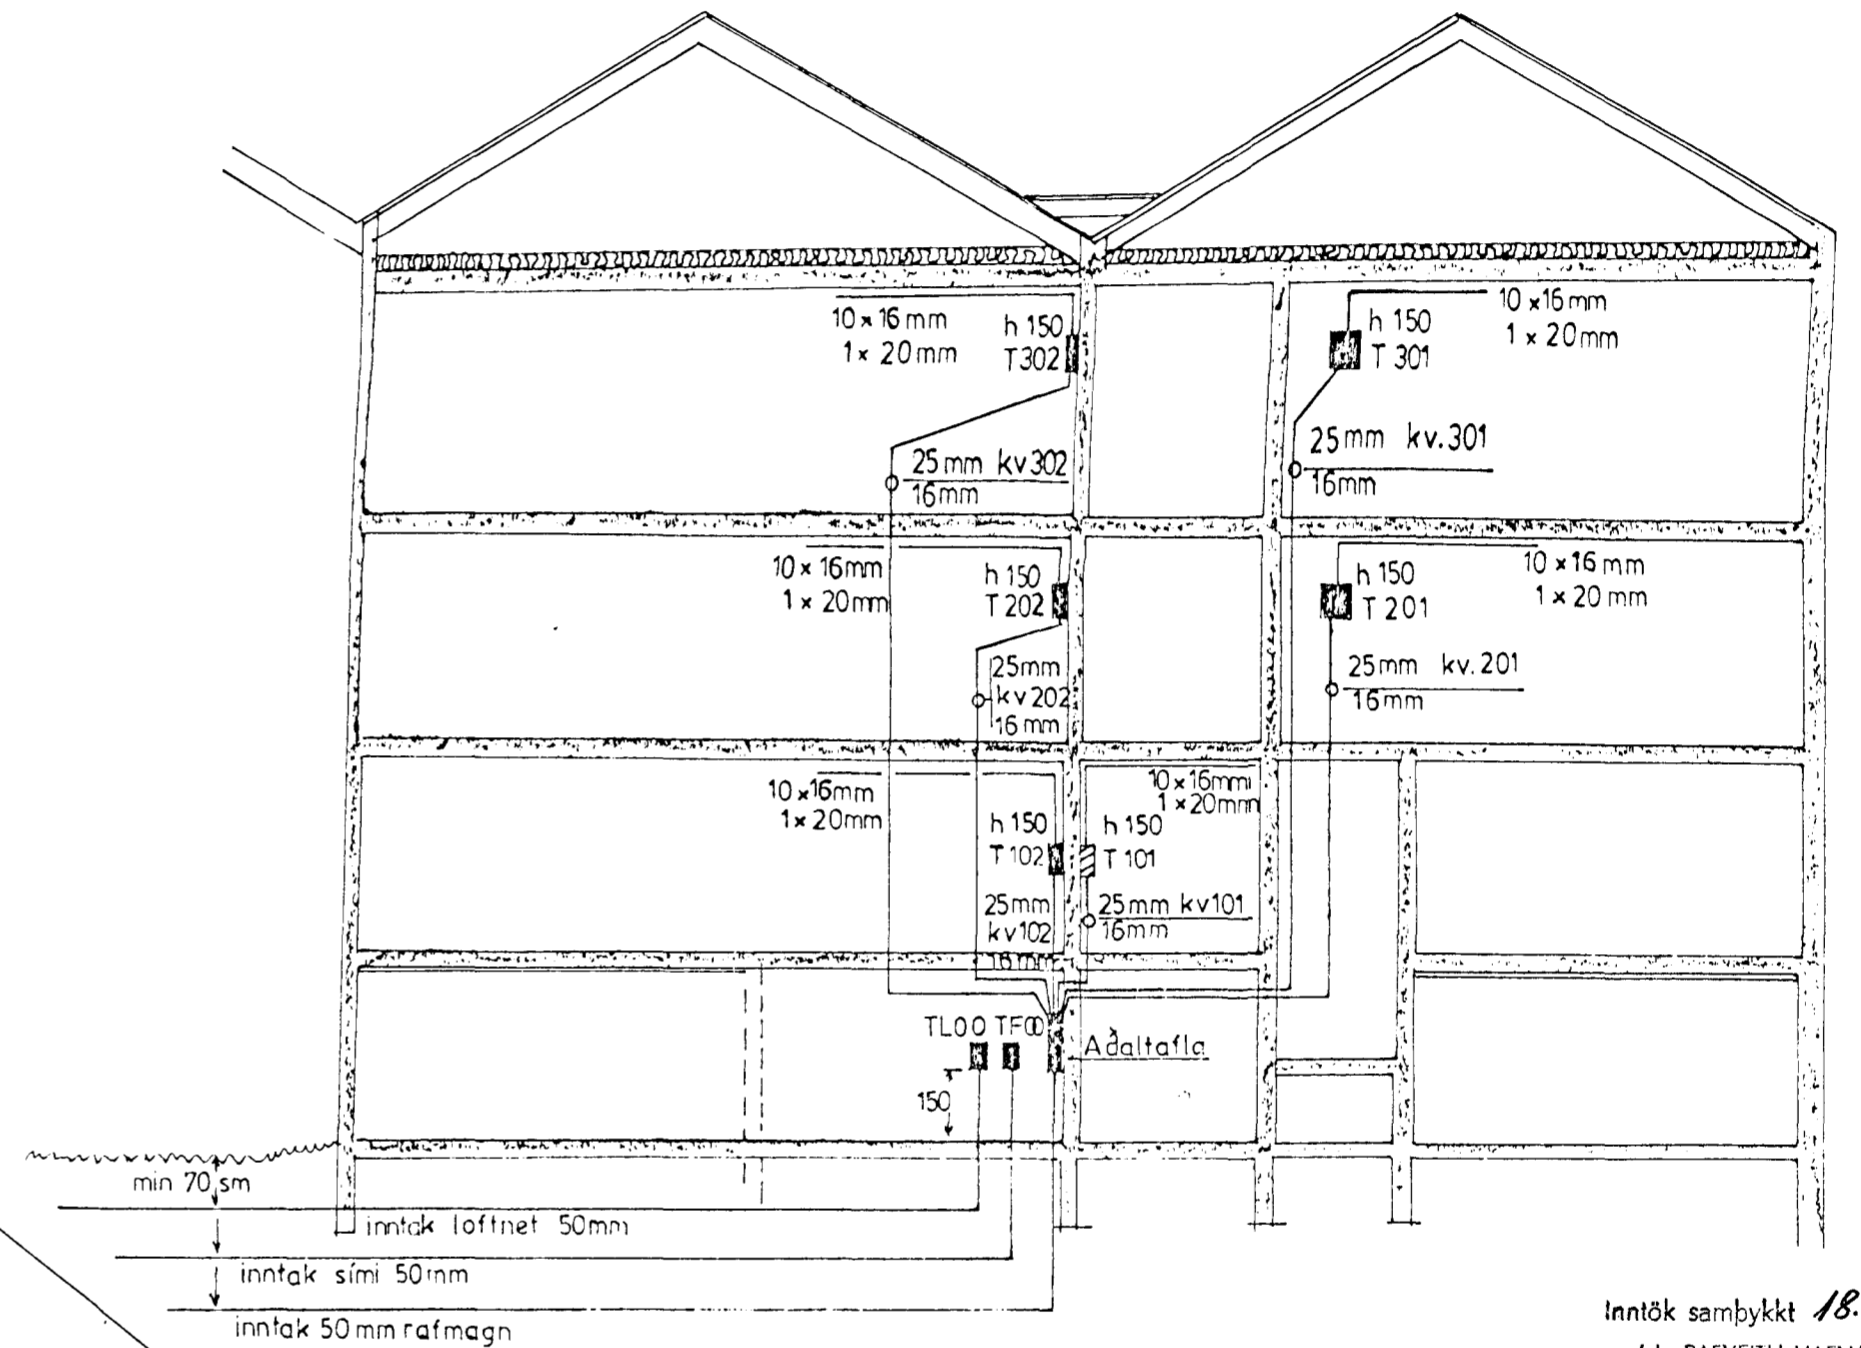


EYRARHOLT 16. RAFLAGNIR

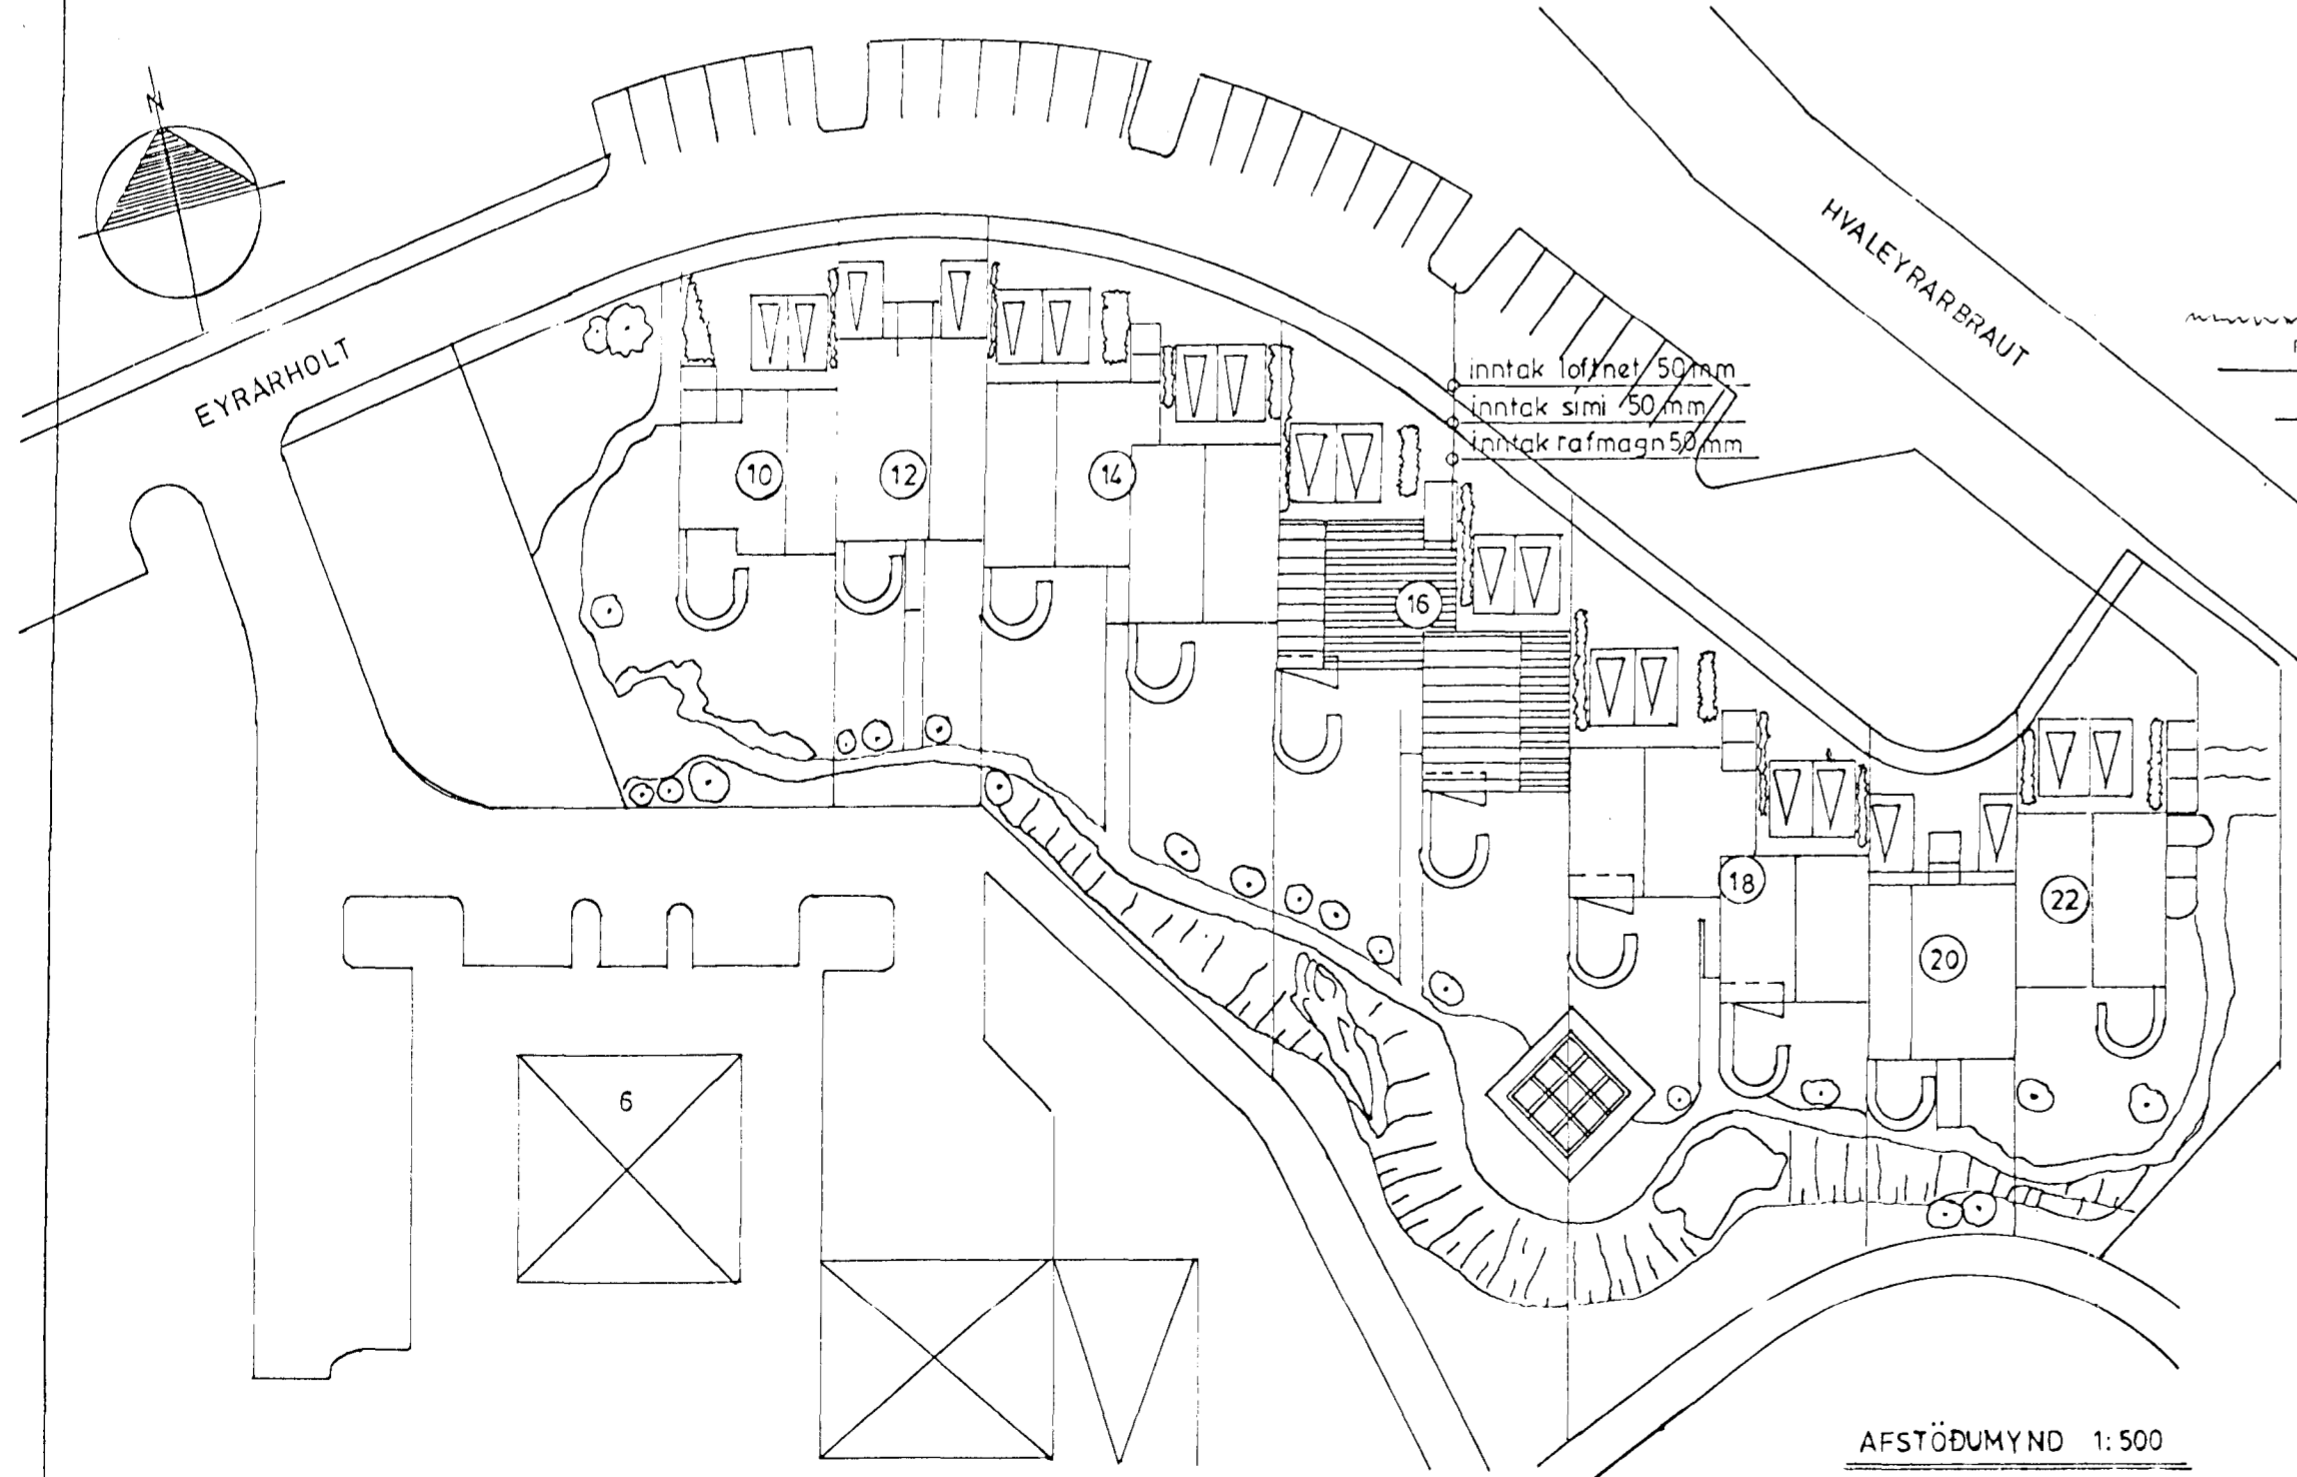

SNID 1:100

Inntök samþykkt 18.11.0. 1995
Afh. RAFVEITU HAFNARFIJARÐAR
Albert Þredingsson


Jens Þorsteinsson

JÓHANNES SKARPHÉÐINS, AFSTÖÐUMYND og SNID	H.J.S. Y.J.S. T.J.S.
M 1:500 1:100	
Tölur 1994	
Dags JAN '94	

3292