


GRUNNMYND 01 1:100

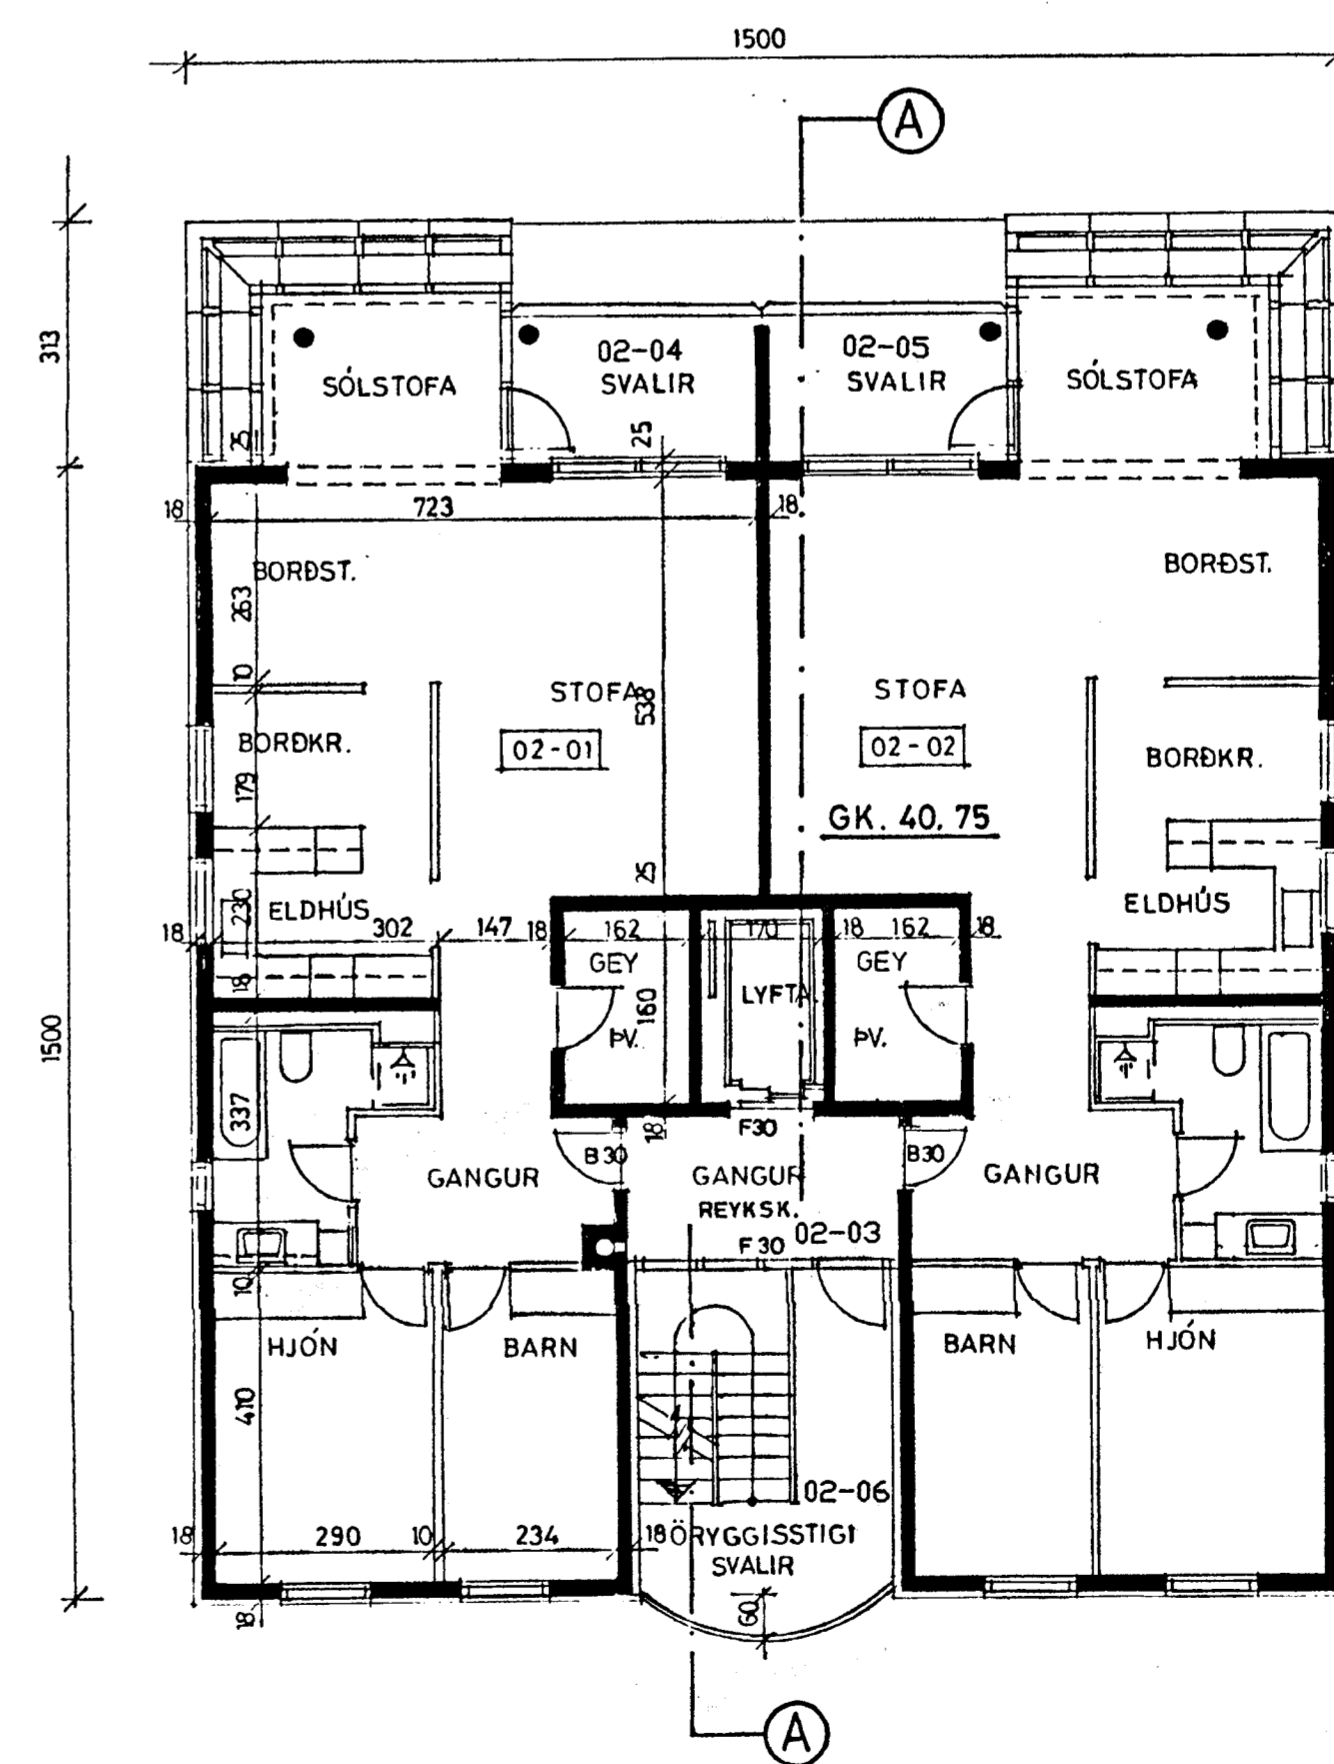


GRUNNMYND 02 1:100

Stökkvilið höfuðhópnarvæðisins he
 27/6'02
 [Signature]

BR. STÖDMÜR 30.07.1992 k.
 BR. STÖDMÜR, RÍS, 02.07.1992 k.
 BR. TRAPPA A LÖB 10.06.1992 k.
 BREYTT RISHÆÐ OG BILGEY. 27.03.1992 k.
 BREYTT 05.09.1990

BR. 11011991 BREIKKAÐAR SVALIR Í RÍSI k.

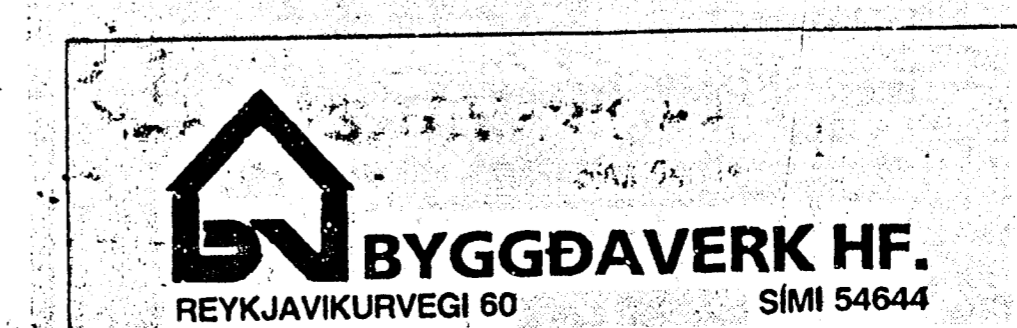

EYRARHOLT 6, HAFNARFIRÐI
 GRUNNMYNDIR **03**
 DAGS. 12.07.1990 MKV. 1:100 HANNAÐ SA/PVB TEIKN. AE/GJ
 SIGURÐOR ADALSTEINSSON, ARKITEKT, PÁLL V. BJARNASON, ARKITEKT.