



Semjuki & fundi byggingar-
 notandab. 2.19.1992
 BYGGINGAVALTFRÚNN
 1. HAFNARFIRÐI
 Sigurbj. Halld.

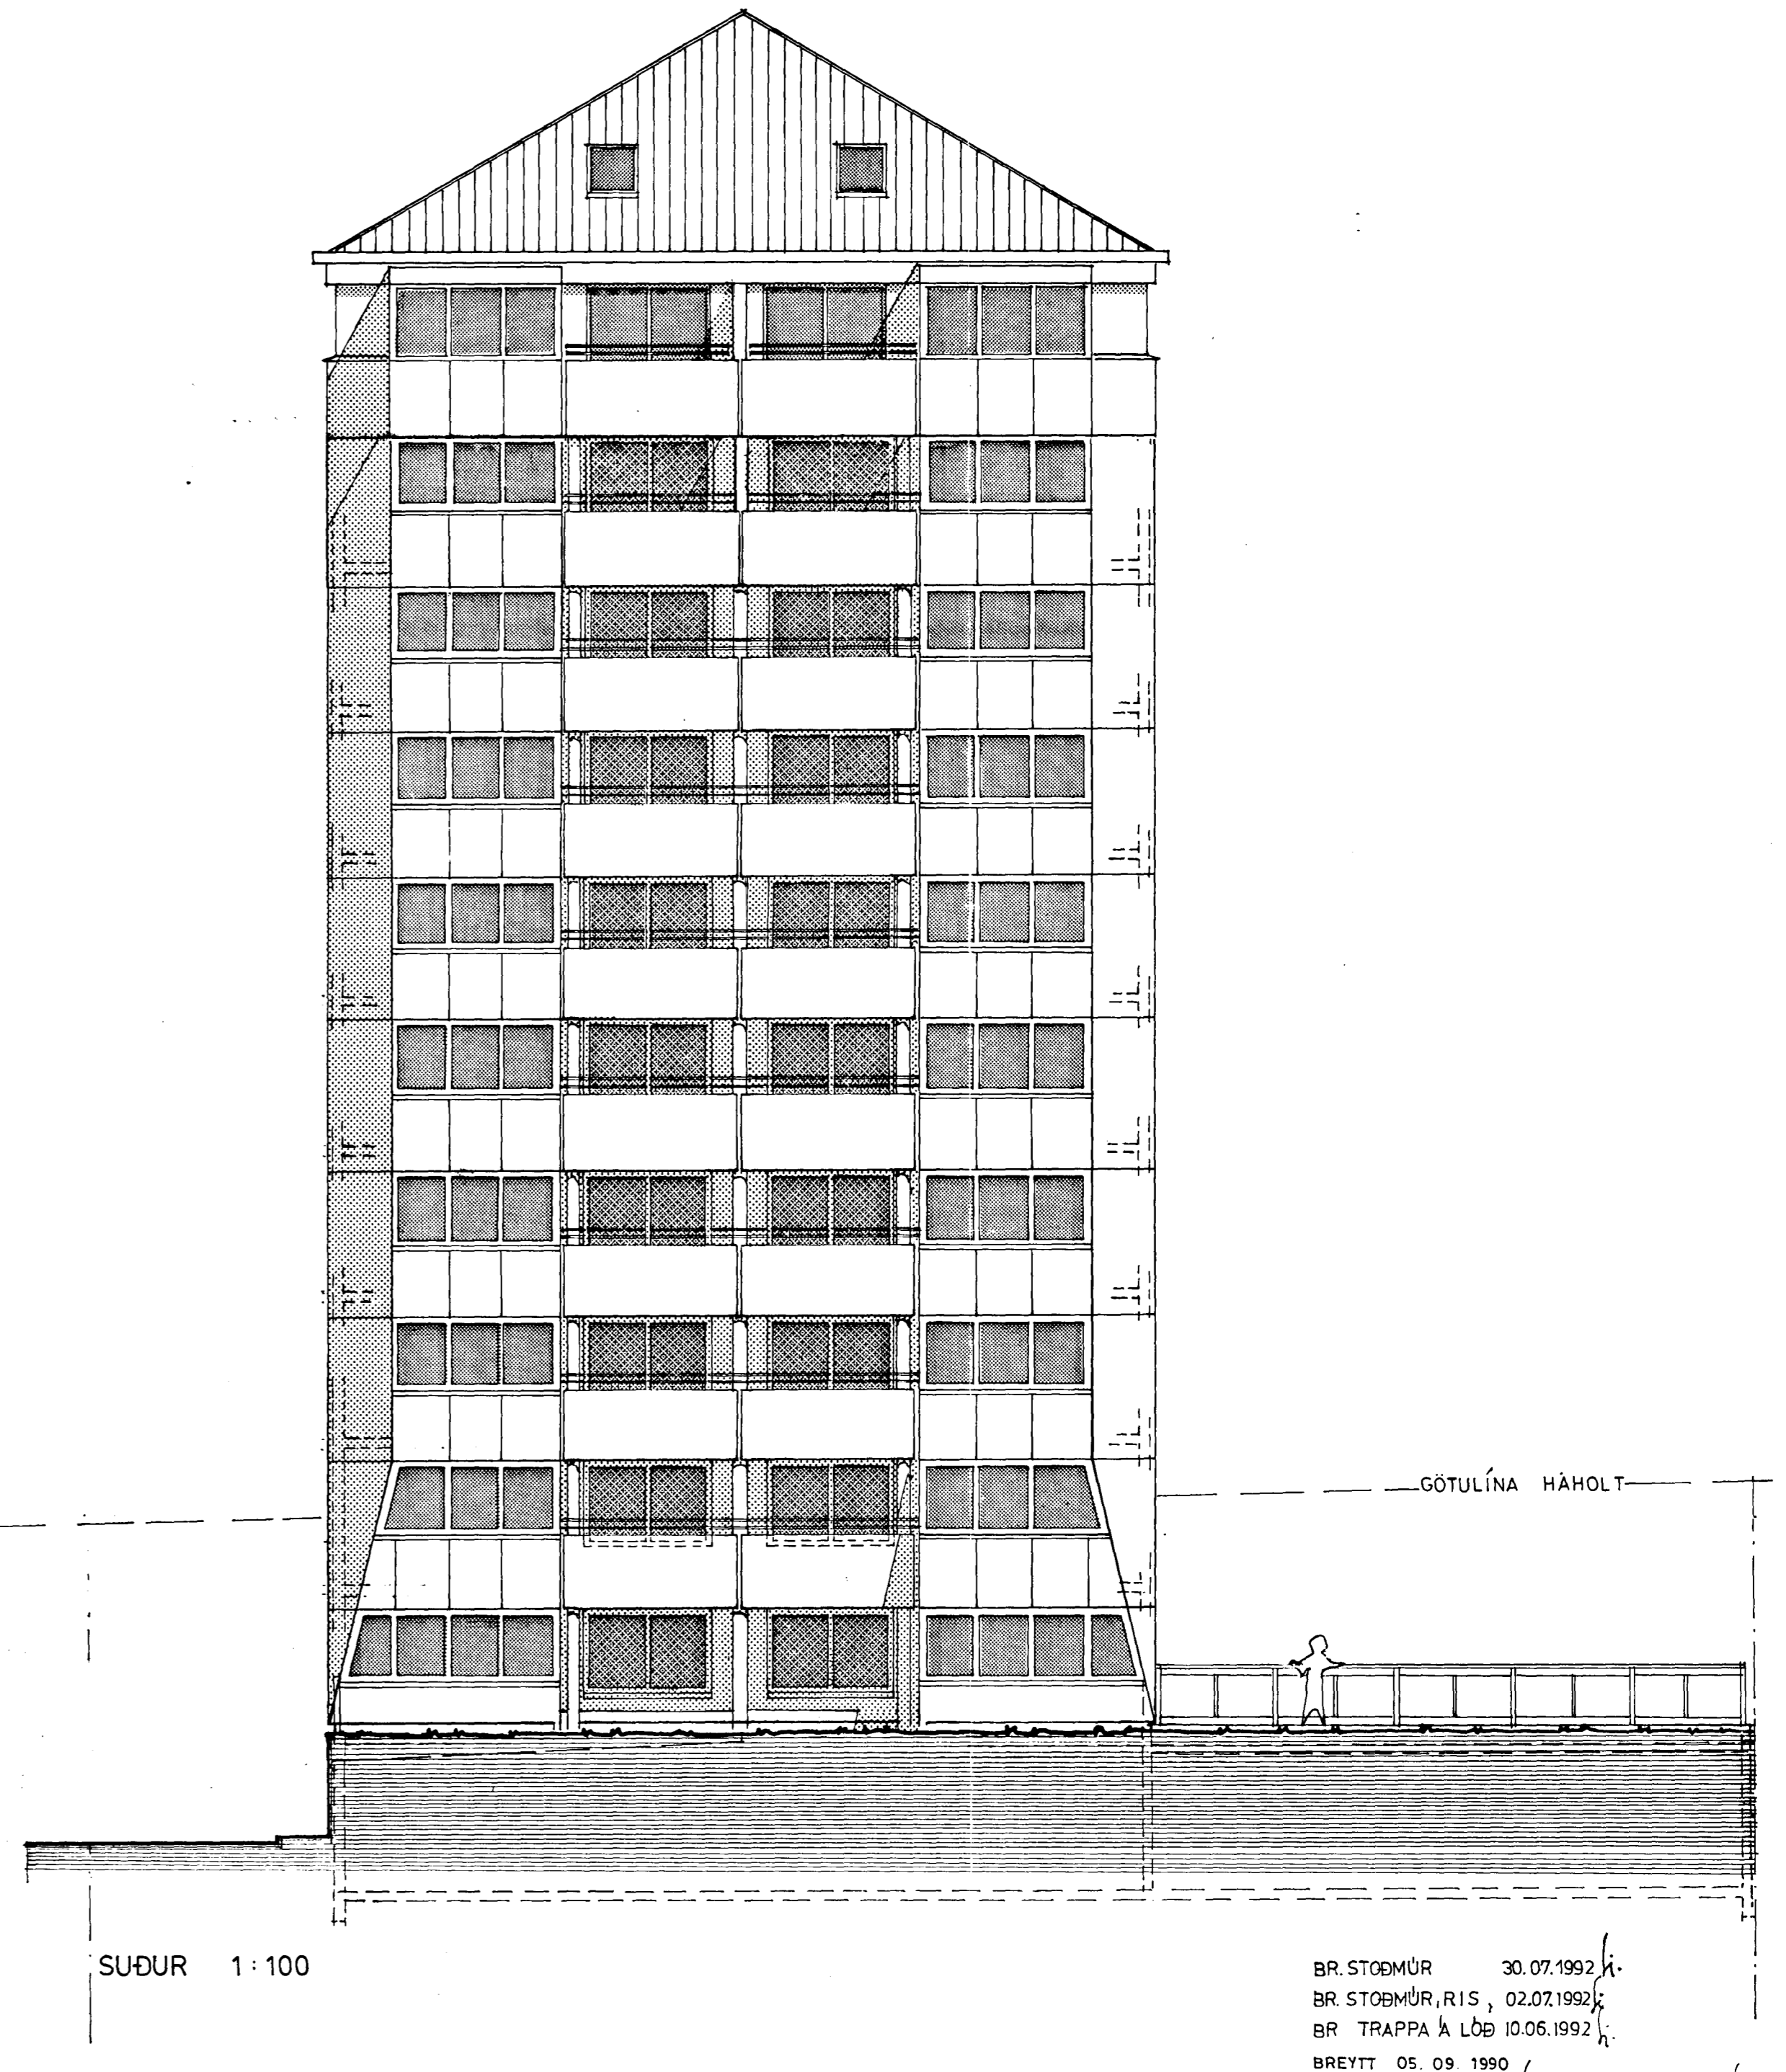

BR. STÖDMÜR 30.07.1992
 BR. STÖDMÜR, RÍ.S. 02.07.1992
 BR. TRAPPA & LÖB 10.06.1992
 BREYTT 05.09.1990
 BR. PAK 12.03.1992
 BILGEY 27.03.1992

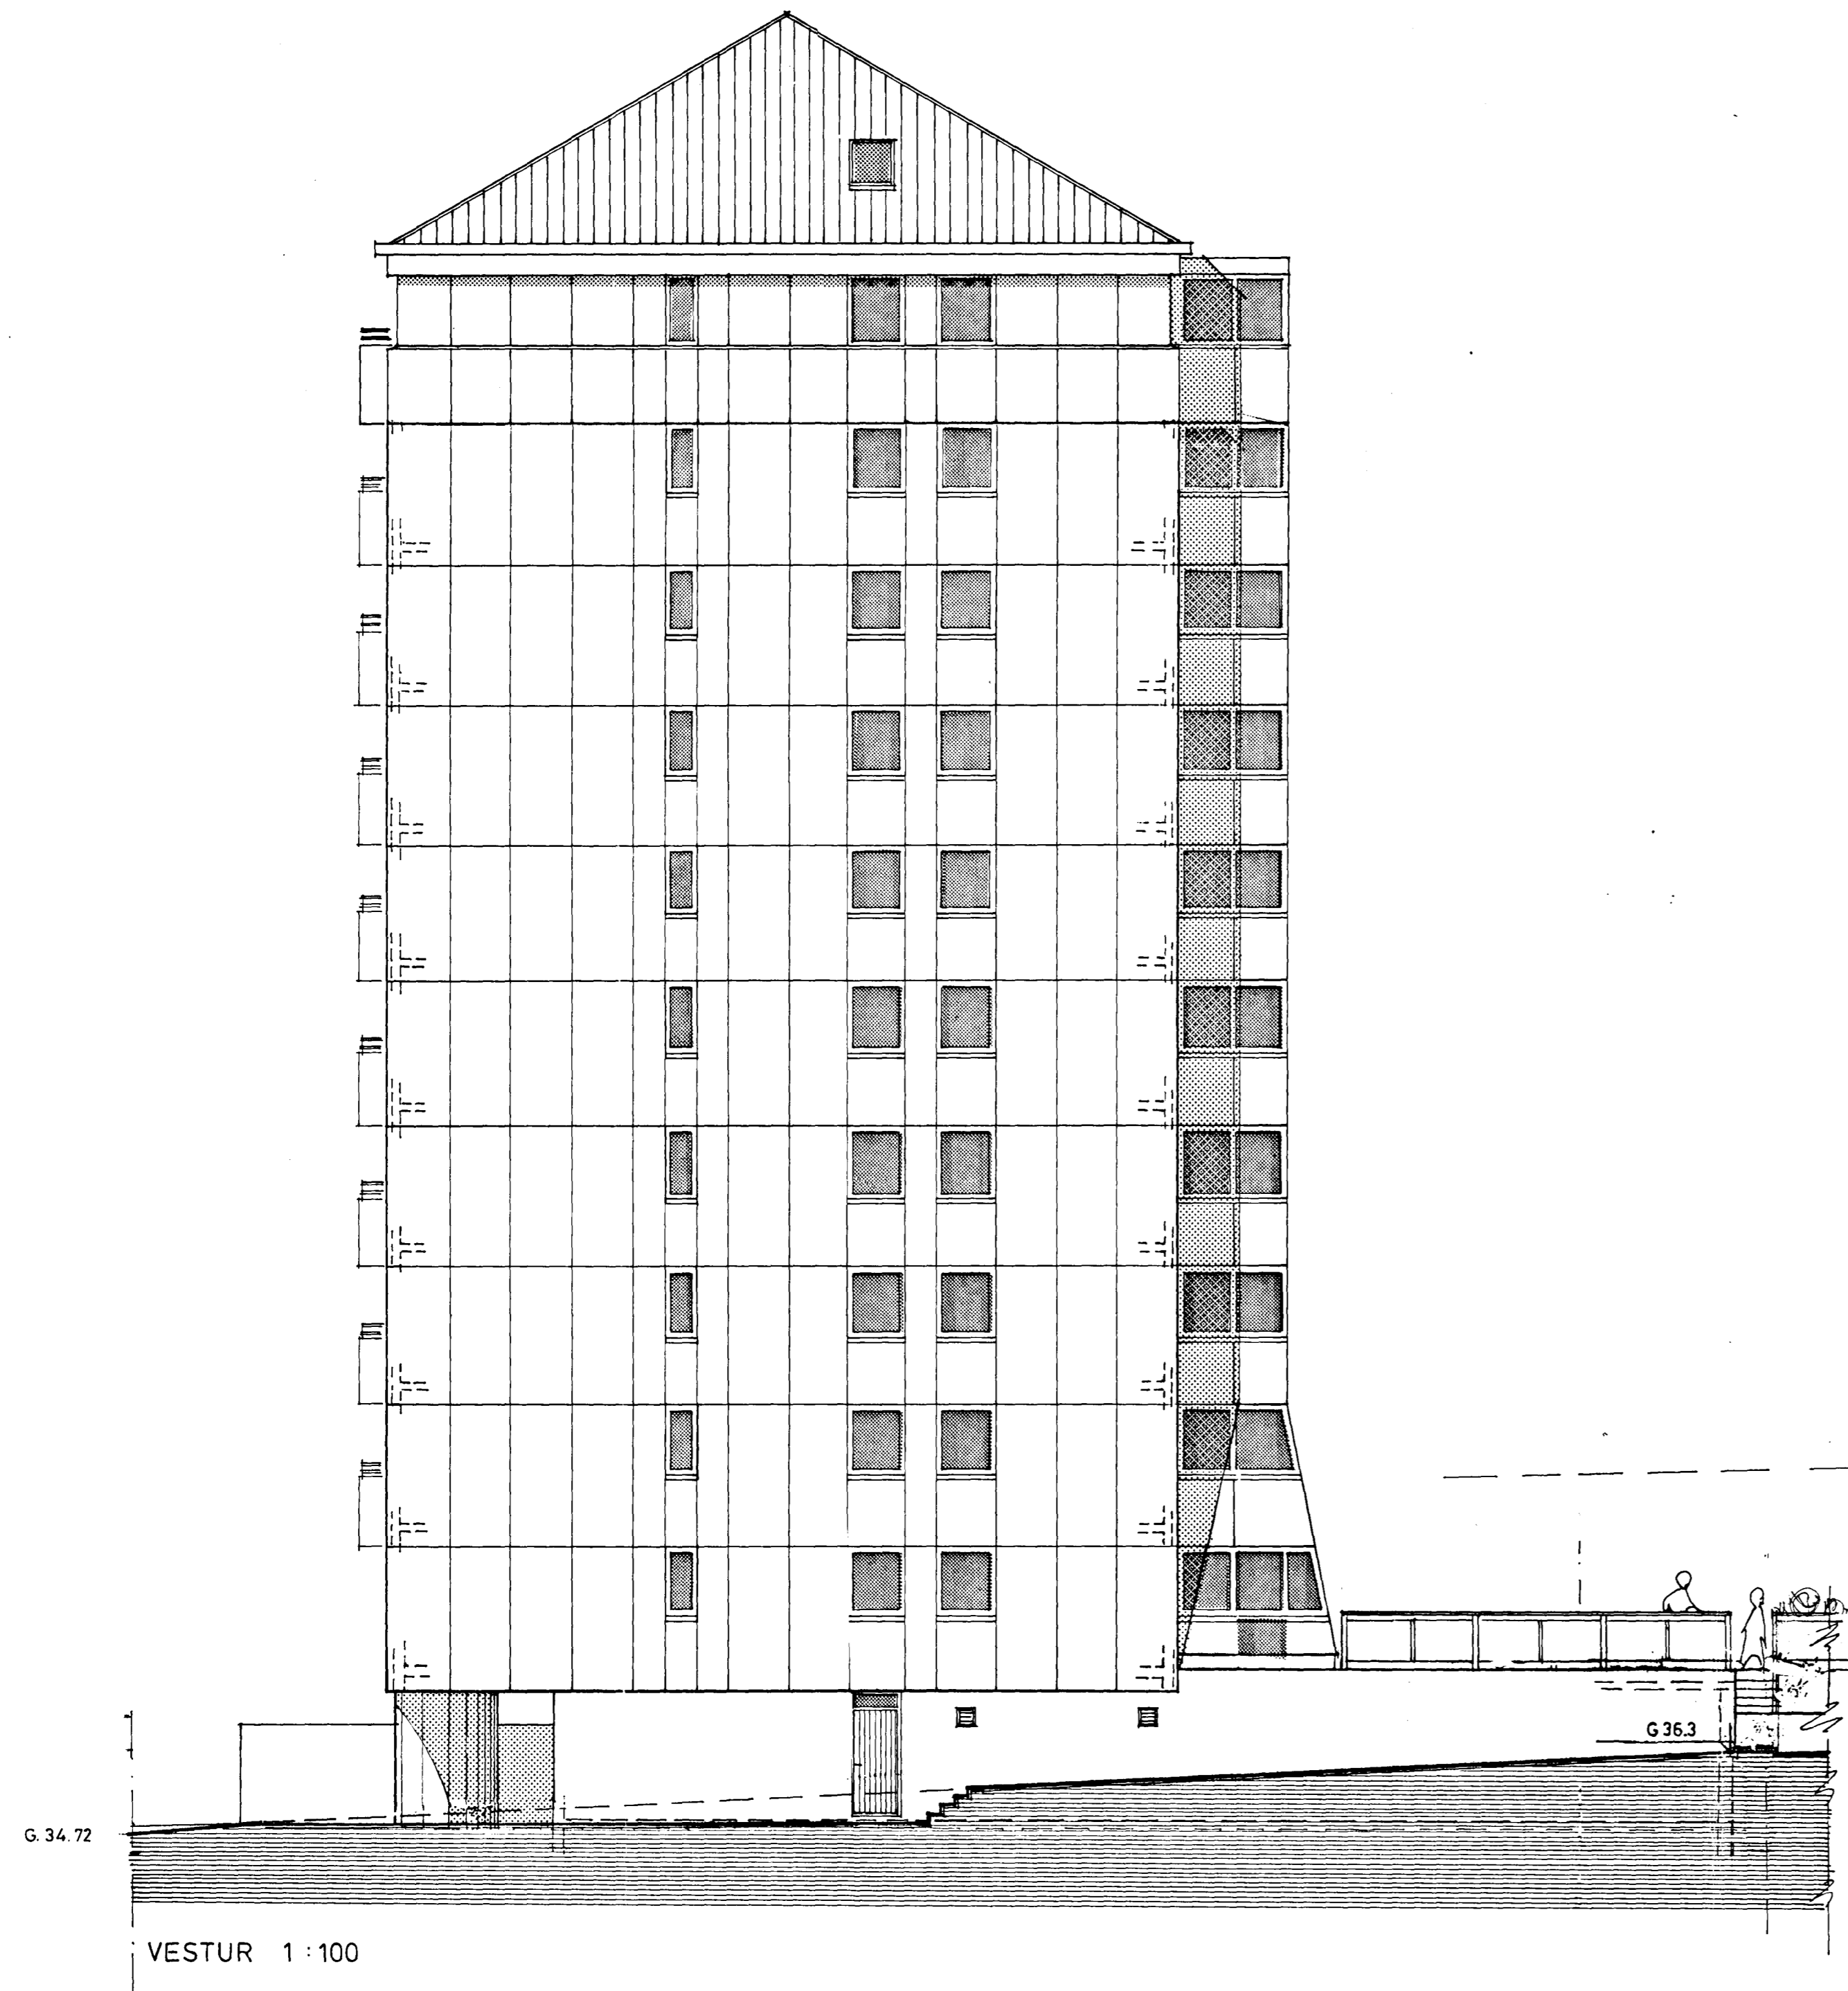

EYRARHOLT 6, HAFNARFIRÐI
 ÚTLITSMYNDIR **05**
 DAGS. 12.07.1990 MKV. 1:100 HANNAÐ SA/PVB TEIKN. AE/GJ
 SIGURBJ. ADALSTEINSSON, LAURITZ. ADALSTEINSSON